~~646.402 DURABLE 4 INCH WHITE LINE, THERMOPLASTIC~~
~~STA. 399+75 - STA. 414+63.92 (SOLID LT & RT)~~
~~STA. 0+00 - STA. 1+50 (SOLID LT & RT)~~

646.602 TEMPORARY 4 INCH WHITE LINE, PAINT
STA. 399+75 - STA. 414+63.92 (SOLID LT & RT)
STA. 0+00 - STA. 1+50 (SOLID LT & RT)

~~646.412 DURABLE 4 INCH YELLOW LINE, THERMOPLASTIC~~
~~STA. 399+75 - STA. 402+12 (SOLID LT)~~
~~STA. 399+75 - STA. 406+56 (DASHED RT)~~
~~STA. 406+56 - STA. 414+63.92 (DASHED LT)~~
~~STA. 406+56 - STA. 414+63.92 (SOLID RT)~~
~~STA. 0+00 - STA. 1+50 (SOLID LT & RT)~~

646.612 TEMPORARY 4 INCH YELLOW LINE, PAINT
STA. 399+75 - STA. 402+1~~2~~0 (SOLID LT)
STA. 399+75 - STA. 406+5~~6~~7 (DASHED RT)
STA. 406+5~~6~~7- STA. 414+~~63.92~~ (DASHED LT)30.00
STA. 406+5~~6~~7- STA. 414+63.92 (SOLID RT)
STA. 0+00 - STA. 1+50 (SOLID LT & RT)
STA. 414+30 - STA. 414+63.92 (SOLID LT)

621.20 STEEL BEAM GUARDRAIL, GALVANIZED
STA. 399+75.00 - STA. ~~404+53.50~~ RT401+82

621.50 MANUFACTURED TERMINAL SECTION, FLARED
STA. ~~404+53.50~~ - STA. ~~404+91.00~~ RT
406+32.00 406+69.50

621.80 REMOVAL AND DISPOSAL OF GUARDRAIL
STA. 399+75.00 - STA. 404+91.00 RT

676.10 DELINEATOR WITH STEEL POST
STA. 404+91.00 RT

621.205 STEEL BEAM GUARDRAIL, GALV. W/8' POSTS
STA. 401+82.00 - STA. 406+32.00 RT

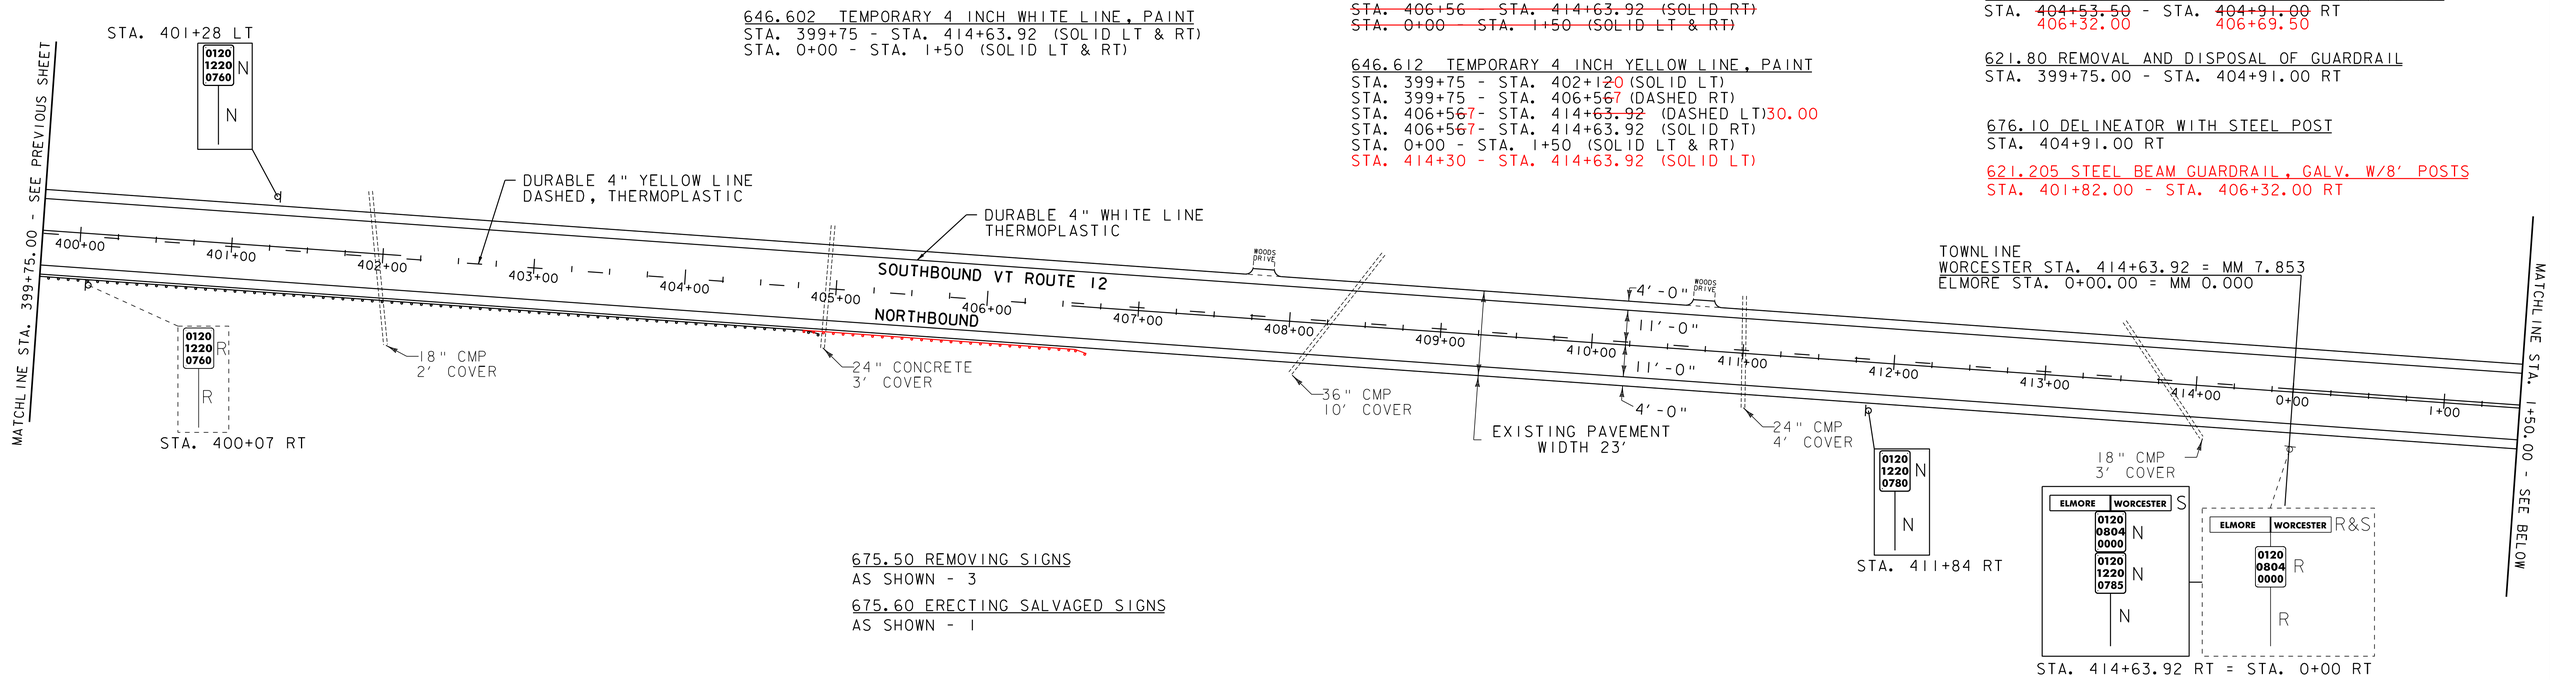

601.0010 15" CSP .064 (2-2/3 X 1/2)
STA. 7+~~39~~ - STA. 7+~~69~~ RT
13 73

~~646.402 DURABLE 4 INCH WHITE LINE, THERMOPLASTIC~~
~~STA. 1+50 - STA. 17+25 (SOLID LT & RT)~~

646.602 TEMPORARY 4 INCH WHITE LINE, PAINT
STA. 1+50 - STA. 17+25 (SOLID LT & RT)

675.50 REMOVING SIGNS
AS SHOWN - 4

675.60 ERECTING SALVAGED SIGNS
AS SHOWN - 4

~~646.412 DURABLE 4 INCH YELLOW LINE, THERMOPLASTIC~~
~~STA. 1+50 - STA. 17+25 (SOLID LT & RT)~~

646.612 TEMPORARY 4 INCH YELLOW LINE, PAINT
STA. 1+50 - STA. 17+25 (SOLID LT & RT)

621.20 STEEL BEAM GUARDRAIL, GALVANIZED
STA. ~~7+87.50~~ - STA. 14+~~62.50~~ RT
8+46.50 67.00

621.205 STEEL BEAM GUARDRAIL, GALVANIZED W/8 FEET POSTS
78.50STA. 6+~~97.50~~ - STA. ~~7+72.50~~ LT8+03.50
STA. 7+84.00 - STA. 8+46.50 RT

621.50 MANUFACTURED TERMINAL SECTION, FLARED
41.00STA. 6+~~60.00~~ - STA. 6+~~97.50~~ LT78.50
8+03.50STA. ~~7+72.50~~ - STA. 8+~~10.00~~ LT41.00
46.50STA. 7+~~50.00~~ - STA. 7+~~87.50~~ RT84.00
67.00STA. 14+~~62.50~~ - STA. 15+~~00.00~~ RT04.50

621.80 REMOVAL AND DISPOSAL OF GUARDRAIL
STA. 6+60.00 - STA. 8+10.00 LT
60.00STA. 7+~~50.00~~ - STA. 9+~~88.50~~ RT85.00
55.00STA. 11+~~37.50~~ - STA. ~~15+00.00~~ RT14+95.00

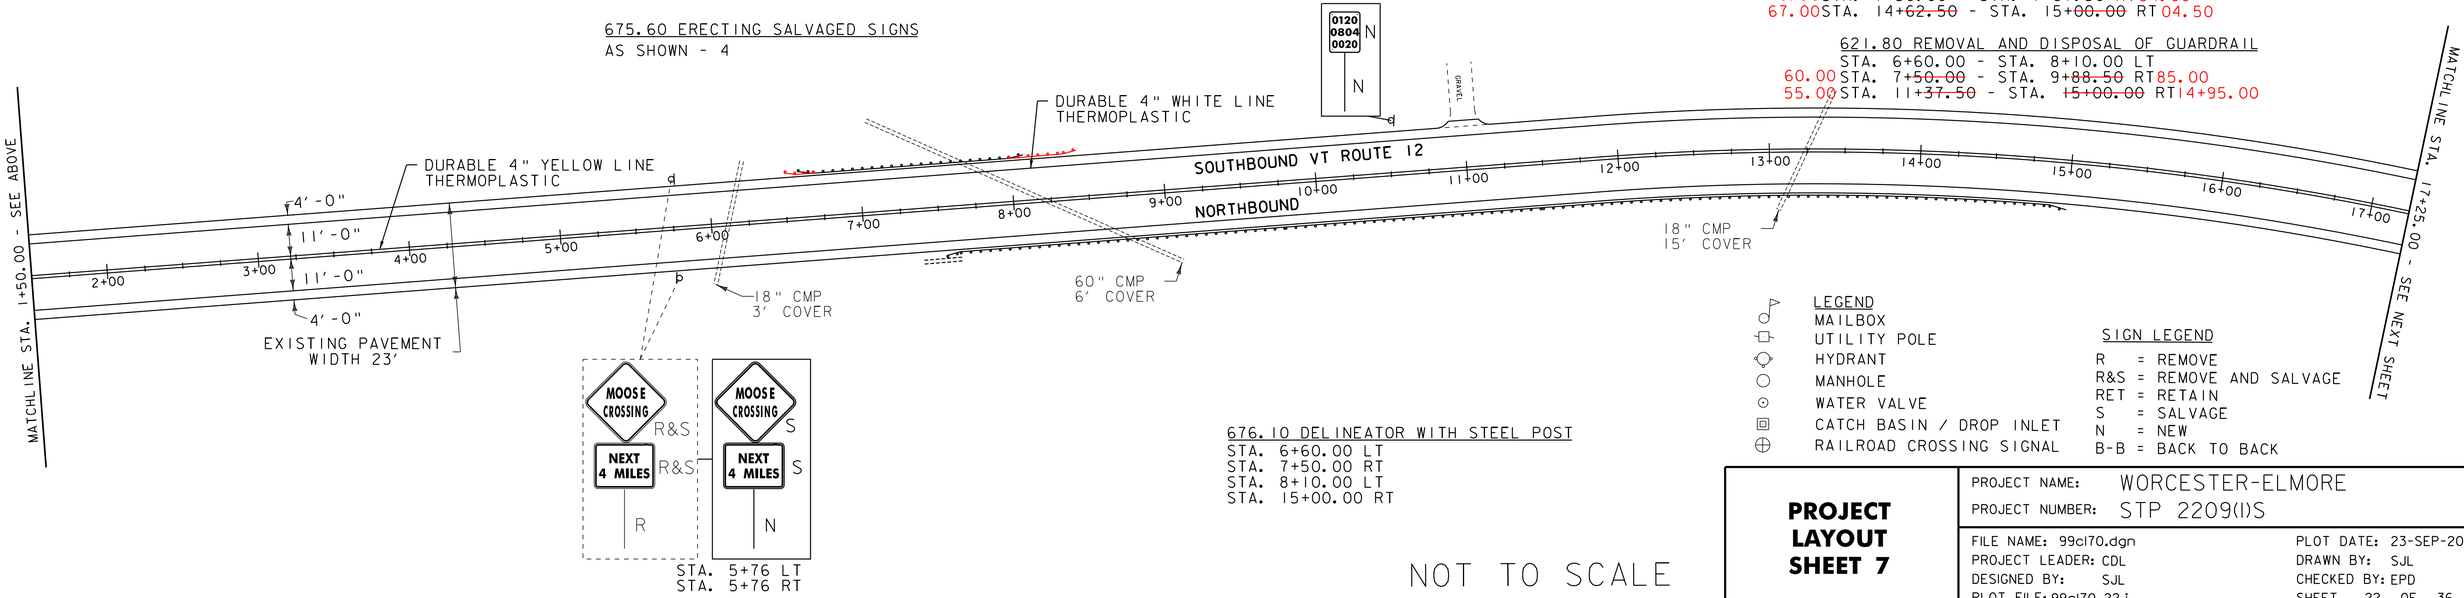

676.10 DELINEATOR WITH STEEL POST
STA. 6+60.00 LT
STA. 7+50.00 RT
STA. 8+10.00 LT
STA. 15+00.00 RT

LEGEND
- MAILBOX
- UTILITY POLE
- HYDRANT
- MANHOLE
- WATER VALVE
- CATCH BASIN / DROP INLET
- RAILROAD CROSSING SIGNAL

SIGN LEGEND
- R = REMOVE
- R&S = REMOVE AND SALVAGE
- RET = RETAIN
- S = SALVAGE
- N = NEW
- B-B = BACK TO BACK

NOT TO SCALE

PROJECT LAYOUT SHEET 7

PROJECT NAME: WORCESTER-ELMORE
PROJECT NUMBER: STP 2209(I)S

FILE NAME: 99c170.dgn
PROJECT LEADER: CDL
DESIGNED BY: SJL
PLOT FILE: 99c170_22.i
PLOT DATE: 23-SEP-2011 15:24
DRAWN BY: SJL
CHECKED BY: EPD
SHEET 22 OF 36