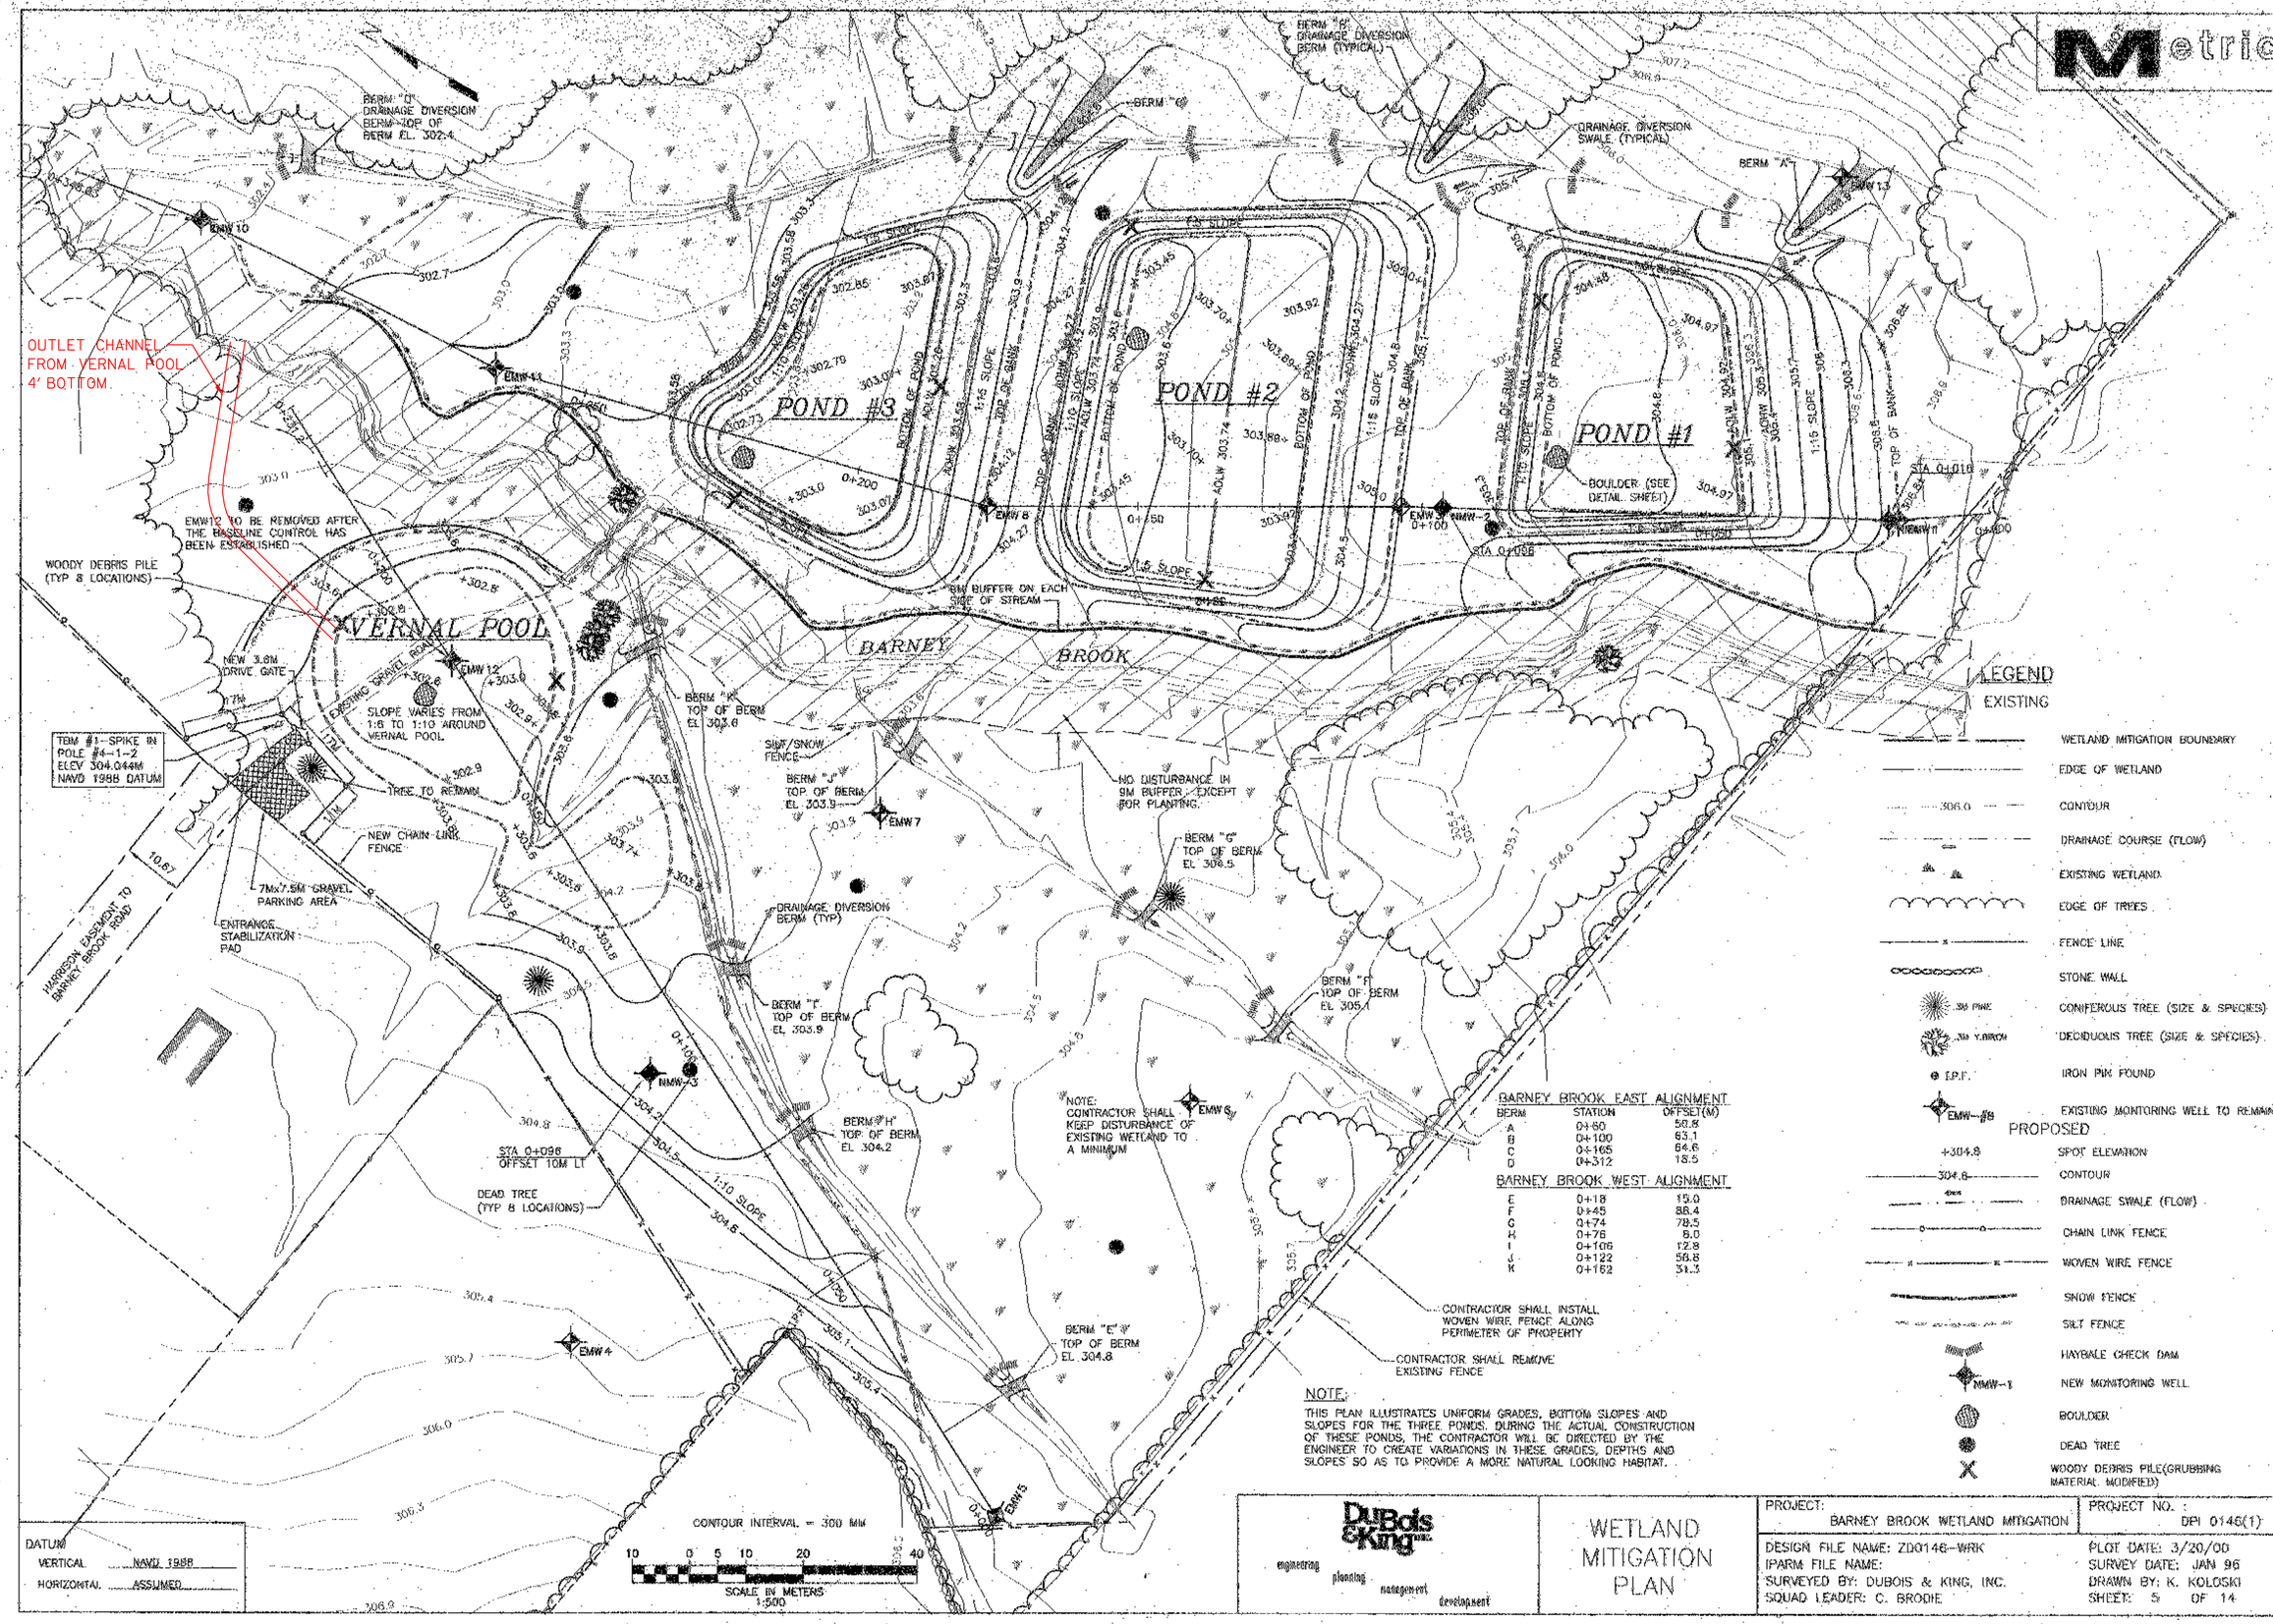

BARNEY BROOK EAST ALIGNMENT

BERM	STATION	OFFSET(M)
A	0+60	50.8
B	0+100	63.1
C	0+165	64.6
D	0+312	18.5

BARNEY BROOK WEST ALIGNMENT

E	0+18	15.0
F	0+45	88.4
G	0+74	78.5
H	0+76	8.0
I	0+106	12.8
J	0+122	58.8
K	0+162	31.3

NOTE:
THIS PLAN ILLUSTRATES UNIFORM GRADES, BOTTOM SLOPES AND SLOPES FOR THE THREE PONDS. DURING THE ACTUAL CONSTRUCTION OF THESE PONDS, THE CONTRACTOR WILL BE DIRECTED BY THE ENGINEER TO CREATE VARIATIONS IN THESE GRADES, DEPTHS AND SLOPES SO AS TO PROVIDE A MORE NATURAL LOOKING HABITAT.

DuBois & King inc.
engineering planning management development

WETLAND MITIGATION PLAN

PROJECT: BARNEY BROOK WETLAND MITIGATION
PROJECT NO.: DPI 0146(1)
DESIGN FILE NAME: ZD0146-WRK
IPARM FILE NAME:
SURVEYED BY: DUBOIS & KING, INC.
SQUAD LEADER: C. BRODIE
PLOT DATE: 3/20/00
SURVEY DATE: JAN 96
DRAWN BY: K. KOLOSKI
SHEET: 5 OF 14