646.20

~~646.402 DURABLE~~ 4 INCH WHITE LINE, ~~THERMOPLASTIC~~

STA. 349+50 TO 360+50, SOLID LT & RT
(ALL LINES WILL INCLUDE EDGE LINE BREAKS OR RADII AT SIDE ROADS)
STA. 352+32, DOUBLE SOLID LT (TAPLIN HILL RD)

646.21

~~646.412 DURABLE~~ 4 INCH YELLOW LINE, ~~THERMOPLASTIC~~

STA. 349+50 TO 349+54, DASHED LT, SOLID RT
STA. 349+54 TO 360+50, SOLID LT & RT
(ALL LINES WILL INCLUDE ℄ BREAKS AT SIDE ROADS)
STA. 352+32, DOUBLE SOLID LT (TAPLIN HILL RD)

646.602 TEMPORARY 4 INCH WHITE LINE, PAINT

STA. 349+50 TO 360+50, SOLID LT & RT
(ALL LINES WILL INCLUDE EDGELINE BREAKS OR RADII AT SIDE ROADS)
STA. 352+32, DOUBLE SOLID LT (TAPLIN HILL RD)

646.612 TEMPORARY 4 INCH YELLOW LINE, PAINT

STA. 349+50 TO 349+54, DASHED LT, SOLID RT
STA. 349+54 TO 360+50, SOLID LT & RT
(ALL LINES WILL INCLUDE ℄ BREAKS AT SIDE ROADS)
STA. 352+32, DOUBLE SOLID LT (TAPLIN HILL RD)

646.26

~~646.482 DURABLE 24~~ INCH STOP BAR, ~~THERMOPLASTIC~~

STA. 352+32, LT (TAPLIN HILL RD)

646.492 DURABLE LETTER OR SYMBOL, THERMOPLASTIC

STA. 352+32, LT - "STOP"

646.682 TEMPORARY 24 INCH STOP BAR, PAINT

STA. 352+32, LT (TAPLIN HILL RD)

646.692 TEMPORARY LETTER OR SYMBOL, PAINT

STA. 352+32, LT - "STOP"

675.50 REMOVING SIGNS

AS SHOWN - 2

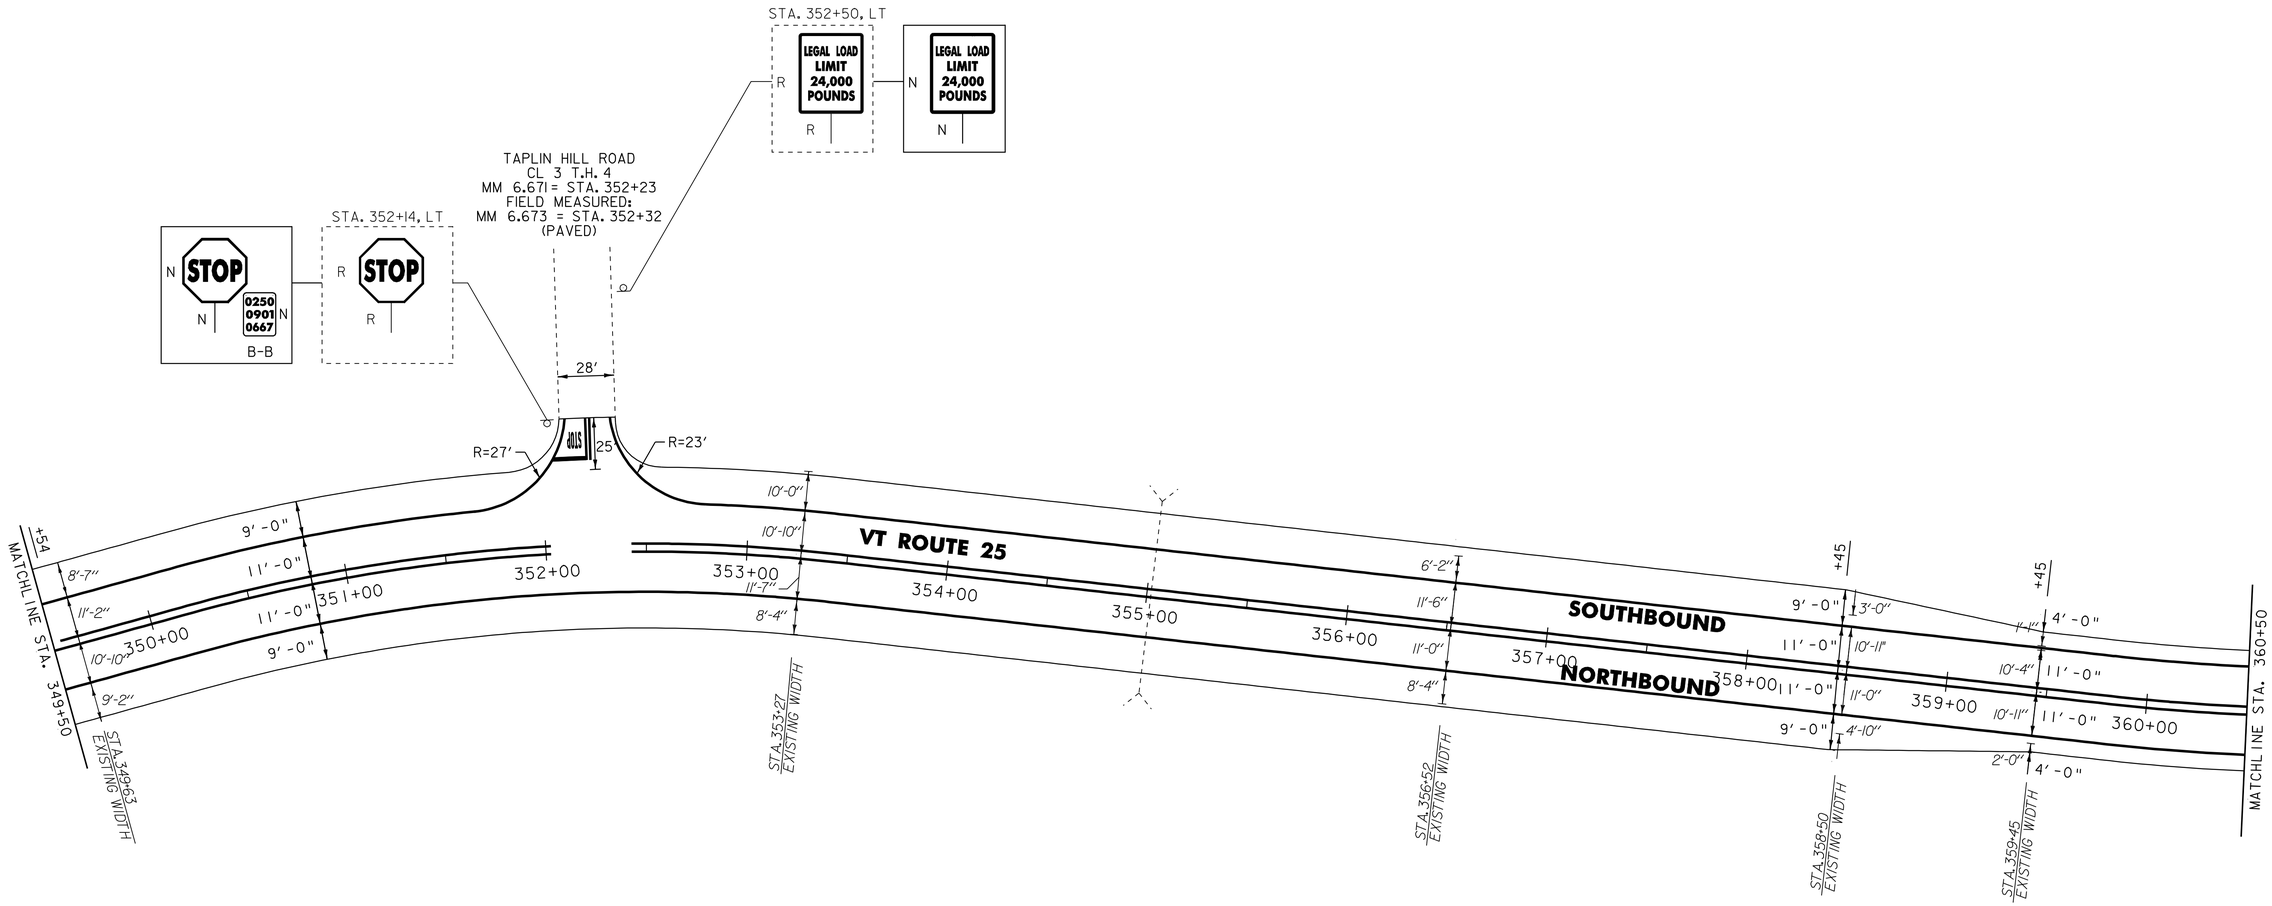

NOTES:
1. ALL EXISTING SIGNS NOT SHOWN SHALL BE RETAINED.
2. FOR LEGEND, SEE LAYOUT SHEET #1

NOT TO SCALE

PROJECT LAYOUT SHEET #3

Stantec

PROJECT NAME: BRADFORD - ORANGE
PROJECT NUMBER: STP 2213(1)

FILE NAME: p99b178.dgn
PROJECT LEADER: JLL
DESIGNED BY: STANTEC
IPARM FILE: p99b178103.i
PLOT DATE: 28-MAY-2010 13:4
DRAWN BY: STANTEC
CHECKED BY: JLL
SHEET 20 OF 84