525.10 REMOVAL OF EXISTING RAILING
STA. 120+76.5 TO 121+01.5, LT
STA. 120+76.5 TO 121+01.5, RT

525.40 BRIDGE RAILING, GALVANIZED HD STEEL BEAM/CURB MOUNTED
STA. 120+76.5 TO 121+01.5, RT

525.60 BRIDGE RAILING REPAIR, TYPE III
STA. 120+76.5 TO 121+01.5, LT

529.25 REMOVAL OF CONCRETE OR MASONRY
STA. 120+81 TO 120+97, RT

617.10 RELOCATE MAILBOX, SINGLE SUPPORT
STA. 119+43, RT

621.20 STEEL BEAM GUARDRAIL, GALVANIZED
82.75 STA. 119~~+45.25~~ TO 120+45.25, RT
120+20.25 STA. ~~119+95.25~~ TO 120+45.25, LT
STA. 121+32.75 TO 121+50, LT

621.21 HD STEEL BEAM GUARDRAIL, GALVANIZED
STA. 120+45.25 TO 120+76.5, LT
STA. 120+45.25 TO 120+76.5, RT
STA. 121+01.5 TO 121+26.5, RT
STA. 121+01.5 TO 121+32.75, LT

621.50 MANUFACTURED TERMINAL SECTION, FLARED
STA 119+57.75 TO 119+95.25, LT
STA 119+45.25 TO 119+82.75 RT

621.60 ANCHOR FOR STEEL BEAM RAIL
~~STA. 119+45.25, RT~~
STA. 121+26.5, RT

621.80 REMOVAL AND DISPOSAL OF GUARDRAIL
STA. 119+39 TO 120+76.5, RT
STA 120+40 TO 121+50, LT
STA. 121+01.5 TO 121+28, RT

646.20
~~646.402 DURABLE~~ 4 INCH WHITE LINE, ~~THERMOPLASTIC~~
STA. 109+50 TO 121+50, SOLID LT & RT
STA. 113+62, DOUBLE SOLID LT (T.H. 4)

646.21
~~646.412 DURABLE~~ 4 INCH YELLOW LINE, ~~THERMOPLASTIC~~
STA. 109+50 TO 121+50, SOLID LT & RT
STA. 113+62, DOUBLE SOLID LT (T.H. 4)

646.26
~~646.482~~ DURABLE 24 INCH STOP BAR, ~~THERMOPLASTIC~~
STA. 113+62, LT (T.H. 4)

646.492 DURABLE LETTER OR SYMBOL, THERMOPLASTIC
STA. 113+62, LT - "STOP"

646.602 TEMPORARY 4 INCH WHITE LINE, PAINT
STA. 109+50 TO 121+50, SOLID LT & RT
STA. 113+62, DOUBLE SOLID LT (T.H. 4)

646.612 TEMPORARY 4 INCH YELLOW LINE, PAINT
STA. 109+50 TO 121+50, SOLID LT & RT
STA. 113+62, DOUBLE SOLID LT (T.H. 4)

646.682 TEMPORARY 24 INCH STOP BAR, PAINT
STA. 113+62, LT (T.H. 4)

646.692 TEMPORARY LETTER OR SYMBOL, PAINT
STA. 113+62, LT - "STOP"

675.50 REMOVING SIGNS
AS SHOWN - 4

675.60 ERECTING SALVAGED SIGNS
AS SHOWN - 1

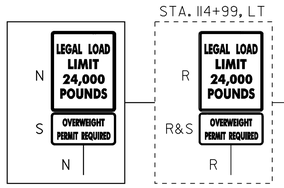

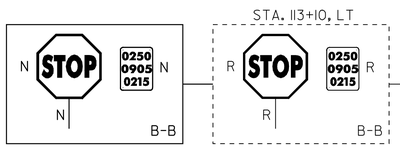

BROOK ROAD
CL 2 T.H. 4
MM 2.150 = STA. 113+52
FIELD MEASURED:
MM 2.152 = STA. 113+62
(ASHPALT)
FOR DETAILS, SEE
INTERSECTION DETAIL SHEET NO. 3

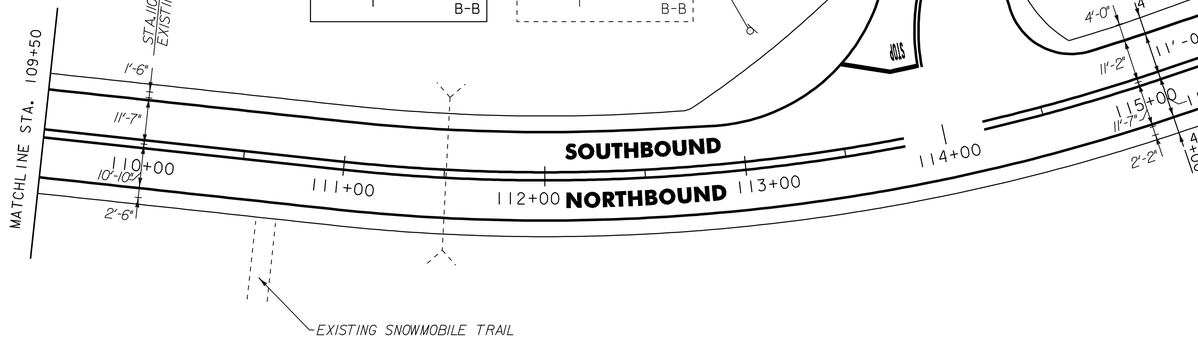

BR II
MM 2.281 = STA. 120+43
FIELD MEASURED:
MM 2.290 = STA. 120+89
CONCRETE BOX CULVERT

NOTES:
1. ALL EXISTING SIGNS NOT SHOWN SHALL BE RETAINED.
2. FOR LEGEND, SEE LAYOUT SHEET #1

NOT TO SCALE

PROJECT LAYOUT SHEET #12

Stantec

PROJECT NAME: BRADFORD - ORANGE
PROJECT NUMBER: STP 2213(1)

FILE NAME: p99b178.dgn
PROJECT LEADER: JLL
DESIGNED BY: STANTEC
IPARM FILE: p99b178l2.i
PLOT DATE: 28-MAY-2010 13:4
DRAWN BY: STANTEC
CHECKED BY: JLL
SHEET 29 OF 84