621.20 STEEL BEAM GUARDRAIL, GALVANIZED
STA. 121+50 TO ~~123+32.75~~ 121+95.25, LT

621.50 MANUFACTURED TERMINAL SECTION, FLARED
STA. ~~123+32.75~~ 121+95.25 TO ~~123+70.25~~ 122+32.75, LT

621.80 REMOVAL AND DISPOSAL OF GUARDRAIL
STA. 121+50 TO 121+66, LT

646.20
~~646.402 DURABLE~~ 4 INCH WHITE LINE, ~~THERMOPLASTIC~~
STA. 121+50 TO 133+50, SOLID LT & RT

646.21
~~646.412 DURABLE~~ 4 INCH YELLOW LINE, ~~THERMOPLASTIC~~
STA. 121+50 TO 133+50, SOLID LT & RT

646.602 TEMPORARY 4 INCH WHITE LINE, PAINT
STA. 121+50 TO 133+50, SOLID LT & RT

646.612 TEMPORARY 4 INCH YELLOW LINE, PAINT
STA. 121+50 TO 133+50, SOLID LT & RT

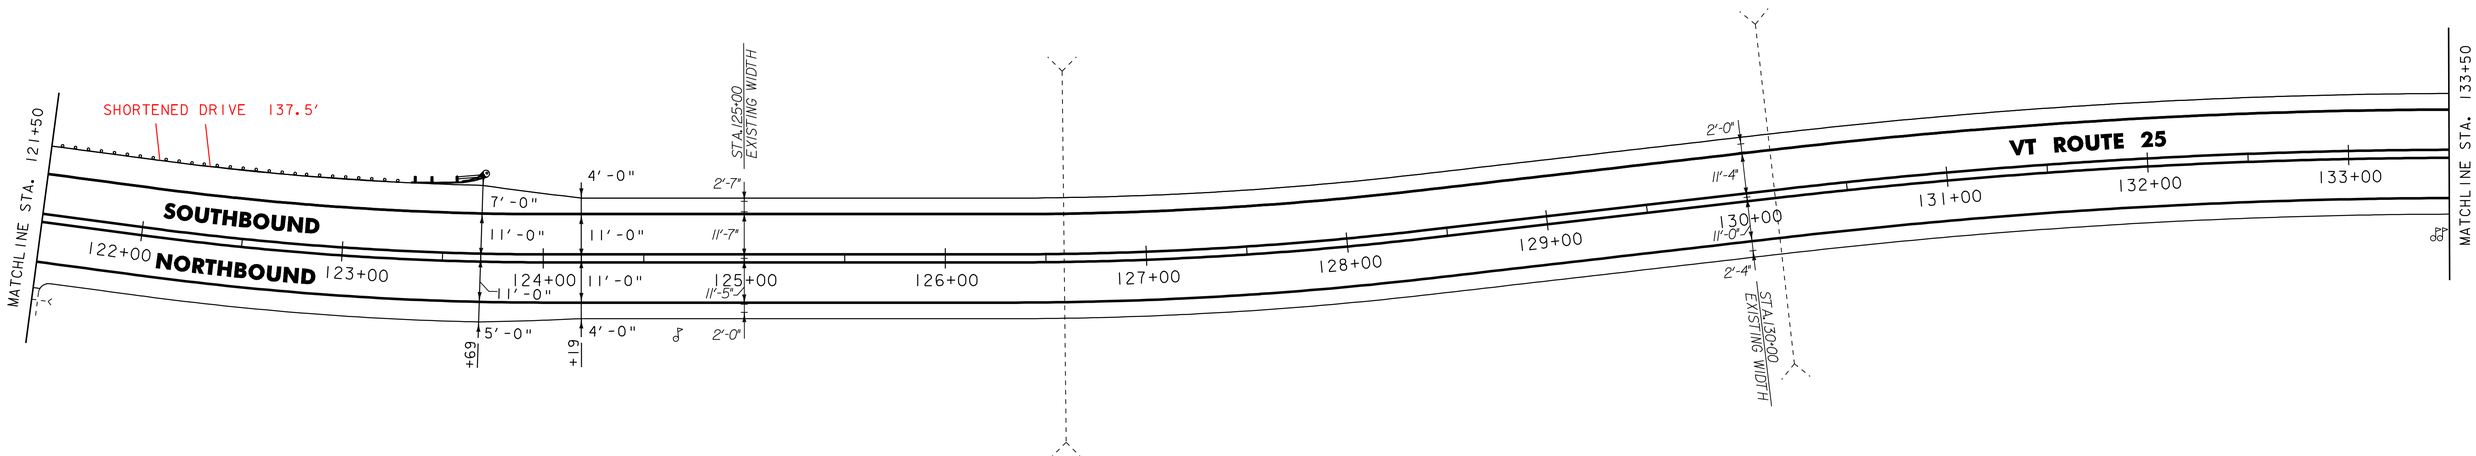

646.20
~~646.402 DURABLE~~ 4 INCH WHITE LINE, ~~THERMOPLASTIC~~
STA. 133+50 TO 144+50, SOLID LT & RT

646.21
~~646.412 DURABLE~~ 4 INCH YELLOW LINE, ~~THERMOPLASTIC~~
STA. 133+50 TO 144+50, SOLID LT & RT

646.602 TEMPORARY 4 INCH WHITE LINE, PAINT
STA. 133+50 TO 144+50, SOLID LT & RT

646.612 TEMPORARY 4 INCH YELLOW LINE, PAINT
STA. 133+50 TO 144+50, SOLID LT & RT

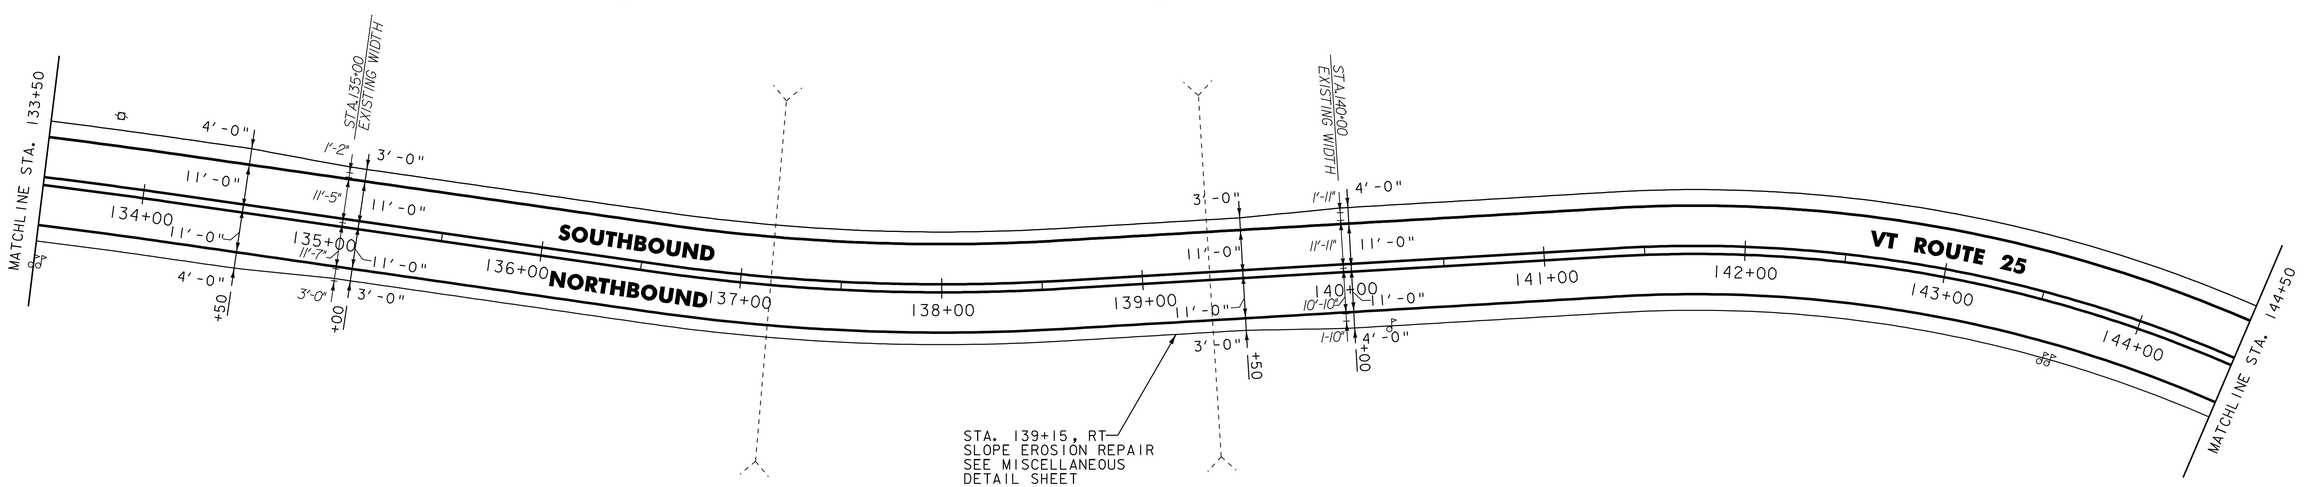

NOTES:
1. ALL EXISTING SIGNS NOT SHOWN SHALL BE RETAINED.
2. FOR LEGEND, SEE LAYOUT SHEET #1

NOT TO SCALE

Stantec

PROJECT LAYOUT SHEET #13

PROJECT NAME: BRADFORD - ORANGE
PROJECT NUMBER: STP 2213(I)

FILE NAME: p99b178.dgn
PROJECT LEADER: JLL
DESIGNED BY: STANTEC
IPARM FILE: p99b178113.i
PLOT DATE: 28-MAY-2010 13:4
DRAWN BY: STANTEC
CHECKED BY: JLL
SHEET 30 OF 84