~~616.35 TREATED TIMBER CURB~~
~~STA. 152+75 TO 153+50, RT~~

~~621.20 STEEL BEAM GUARDRAIL, GALVANIZED~~
~~STA. 153+47.5 TO 156+50, RT~~

621.205 STEEL BEAM GUARDRAIL, GALVANIZED W/8 FEET POSTS
STA. ~~150+35~~ 150+00 TO ~~153+47.5~~ 156+50, RT

621.50 MANUFACTURED TERMINAL SECTION, FLARED
~~STA. 149+97.5 TO 150+35, RT~~

621.80 REMOVAL AND DISPOSAL OF GUARDRAIL
STA 150+00 TO 156+50 RT

646.20
~~646.402 DURABLE~~ 4 INCH WHITE LINE, THERMOPLASTIC
STA. 144+50 TO 156+50, SOLID LT & RT

646.21
~~646.412 DURABLE~~ 4 INCH YELLOW LINE, THERMOPLASTIC
STA. 144+50 TO 156+50, SOLID LT & RT

621.60 ANCHOR FOR STEEL BEAM GUARDRAIL
STA 150+00 RT ANCHOR FOR BURIED END

646.602 TEMPORARY 4 INCH WHITE LINE, PAINT
STA. 144+50 TO 156+50, SOLID LT & RT

646.612 TEMPORARY 4 INCH YELLOW LINE, PAINT
STA. 144+50 TO 156+50, SOLID LT & RT

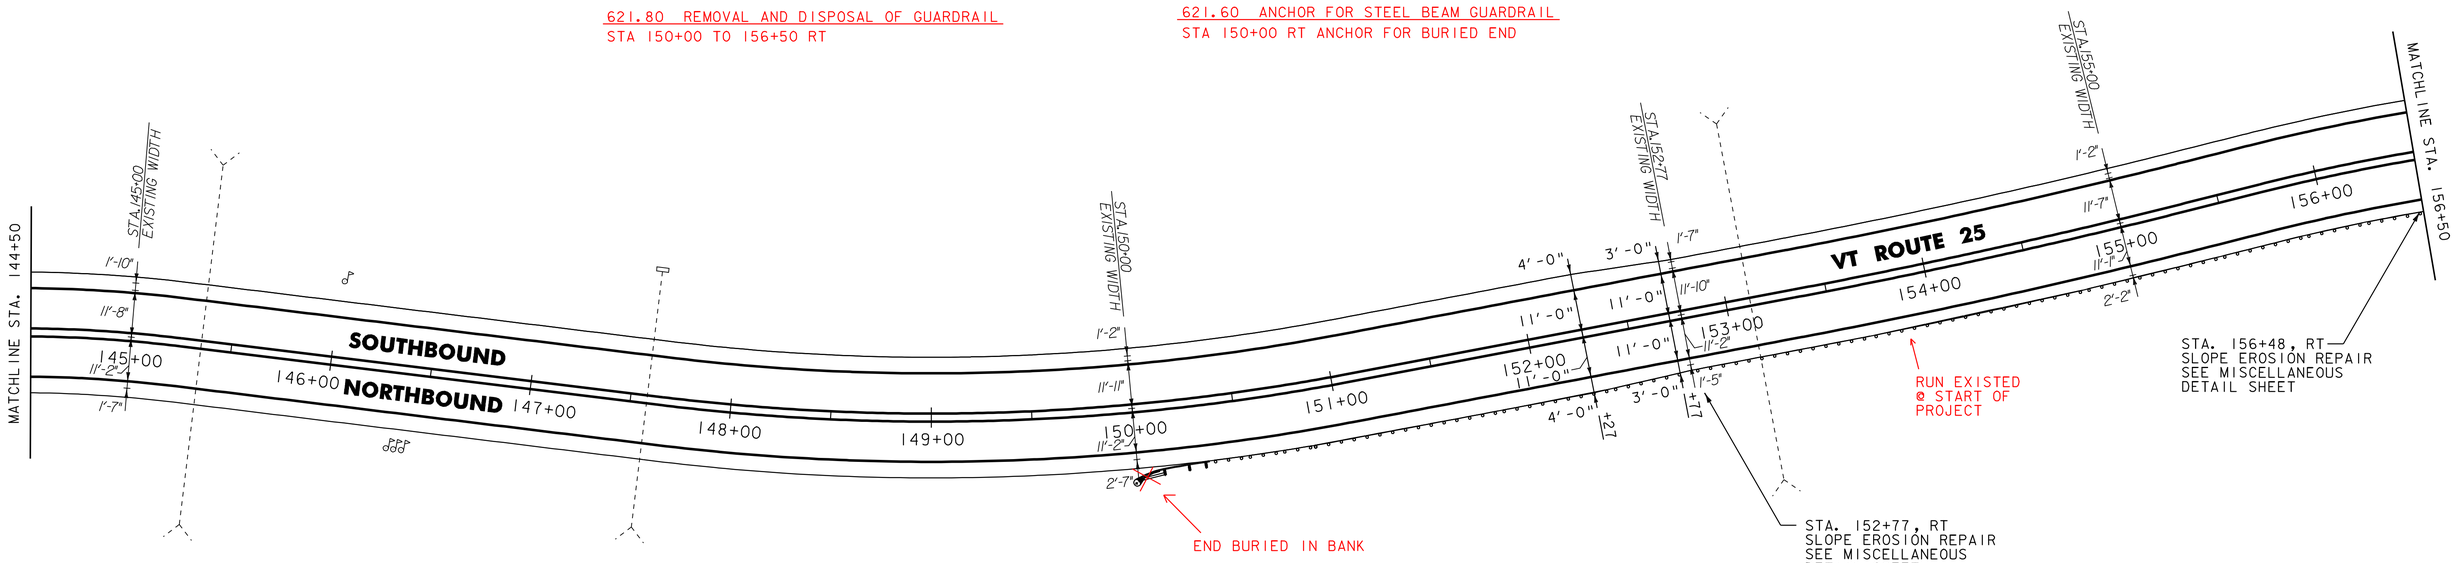

621.205 ~~621.20~~ STEEL BEAM GUARDRAIL, GALVANIZED W/ 8' POSTS
~~STA. 156+50 TO 158+35, RT~~

621.60 ANCHOR FOR STEEL BEAM RAIL
STA. 158+35, RT

621.80 REMOVAL AND DISPOSAL OF GUARDRAIL
STA 156+50 TO 158+35 RT

646.20
~~646.402 DURABLE~~ 4 INCH WHITE LINE, ~~THERMOPLASTIC~~
STA. 156+50 TO 168+50, SOLID LT & RT

646.2
~~646.412 DURABLE~~ 4 INCH YELLOW LINE, ~~THERMOPLASTIC~~
STA. 156+50 TO 168+50, SOLID LT & RT

646.602 TEMPORARY 4 INCH WHITE LINE, PAINT
STA. 156+50 TO 168+50, SOLID LT & RT

646.612 TEMPORARY 4 INCH YELLOW LINE, PAINT
STA. 156+50 TO 168+50, SOLID LT & RT

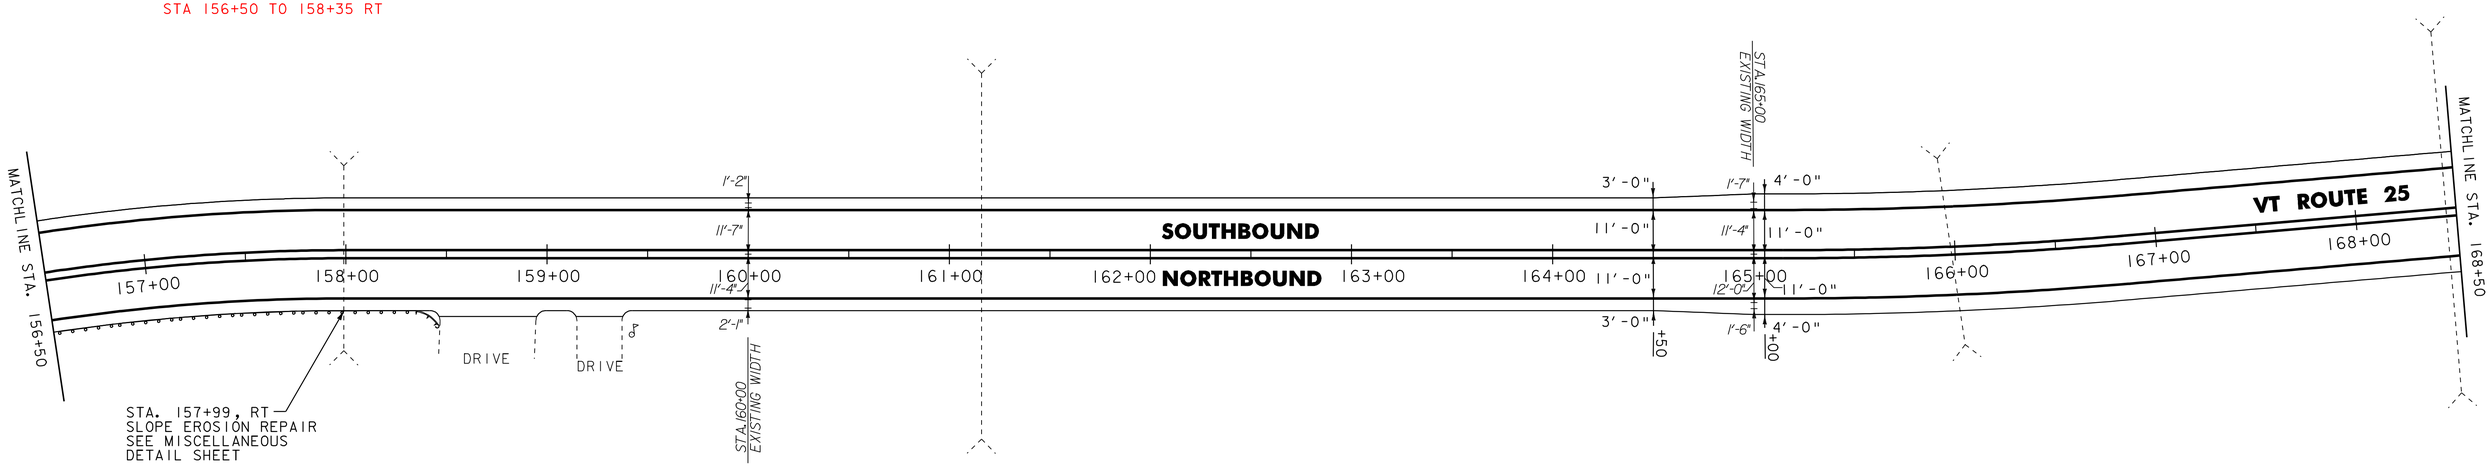

NOTES:
1. ALL EXISTING SIGNS NOT SHOWN SHALL BE RETAINED.
2. FOR LEGEND, SEE LAYOUT SHEET #1

NOT TO SCALE

Stantec

PROJECT LAYOUT SHEET #14

PROJECT NAME: BRADFORD - ORANGE
PROJECT NUMBER: STP 2213(I)

FILE NAME: p99b178.dgn
PROJECT LEADER: JLL
DESIGNED BY: STANTEC
IPARM FILE: p99b178114.i

PLOT DATE: 28-MAY-2010 13:4
DRAWN BY: STANTEC
CHECKED BY: JLL
SHEET 31 OF 84