646.20
~~646.402 DURABLE~~ 4 INCH WHITE LINE, ~~THERMOPLASTIC~~
STA. 111+00 TO 122+50, SOLID LT & RT

646.21
~~646.412 DURABLE~~ 4 INCH YELLOW LINE, ~~THERMOPLASTIC~~
STA. 111+00 TO 118+27, SOLID LT & RT
STA. 118+27 TO 122+50, SOLID LT, DASHED RT

646.602 TEMPORARY 4 INCH WHITE LINE, PAINT
STA. 111+00 TO 122+50, SOLID LT & RT

646.612 TEMPORARY 4 INCH YELLOW LINE, PAINT
STA. 111+00 TO 118+27, SOLID LT & RT
STA. 118+27 TO 122+50, SOLID LT, DASHED RT

616.47 BITUMINOUS CONCRETE GUTTERS AND TRAFFIC ISLANDS
120+83 RT & LT CULVERT CROSSING

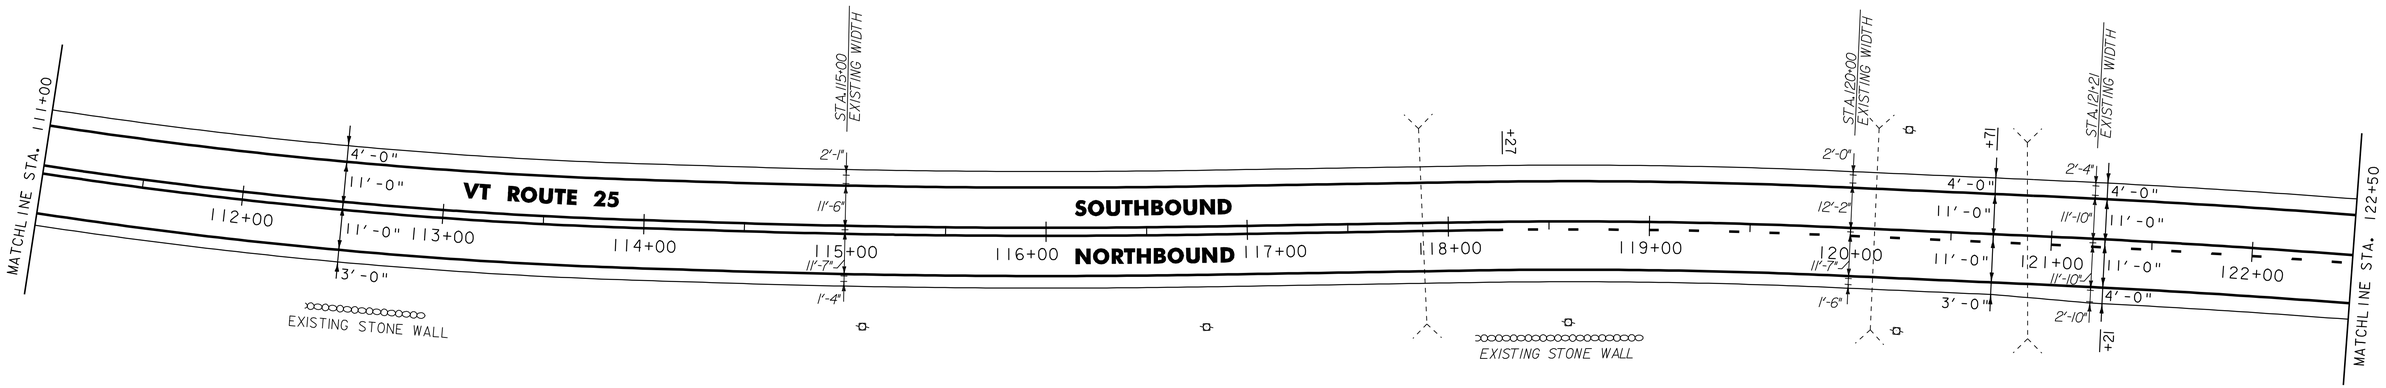

621.20 STEEL BEAM GUARDRAIL, GALVANIZED
STA. 130+43.5 TO 131+06, RT

621.50 MANUFACTURED TERMINAL SECTION, FLARED
STA. 126+62 TO 126+99.5, RT
STA. 127+46 TO 127+83.5, LT
STA. 130+68.5 TO 131+06, LT
STA. 131+06 TO 131+43.5, RT

621.80 REMOVAL AND DISPOSAL OF GUARDRAIL
STA. 126+62 TO 126+99.5, RT
STA. 127+46 TO 127+83.5, LT
STA. 130+43.5 TO 130+81, RT
STA. 130+68.5 TO 131+06, LT

646.20
~~646.402 DURABLE~~ 4 INCH WHITE LINE, ~~THERMOPLASTIC~~
STA. 122+50 TO 134+50, SOLID LT & RT

646.21
~~646.412 DURABLE~~ 4 INCH YELLOW LINE, ~~THERMOPLASTIC~~
STA. 122+50 TO 126+19, SOLID LT, DASHED RT
STA. 126+19 TO 127+78, DASHED ℄
STA. 127+78 TO 134+50, DASHED LT, SOLID RT

STA.129+20, LT REMOVE EXISTING BITUMINOUS GUTTER, CONSTRUCT STONE FILL, TYPE I. SEE MISCELLANEOUS DETAIL SHEET

646.602 TEMPORARY 4 INCH WHITE LINE, PAINT
STA. 122+50 TO 134+50, SOLID LT & RT

646.612 TEMPORARY 4 INCH YELLOW LINE, PAINT
STA. 122+50 TO 126+19, SOLID LT, DASHED RT
STA. 126+19 TO 127+78, DASHED ℄
STA. 127+78 TO 134+50, DASHED LT, SOLID RT

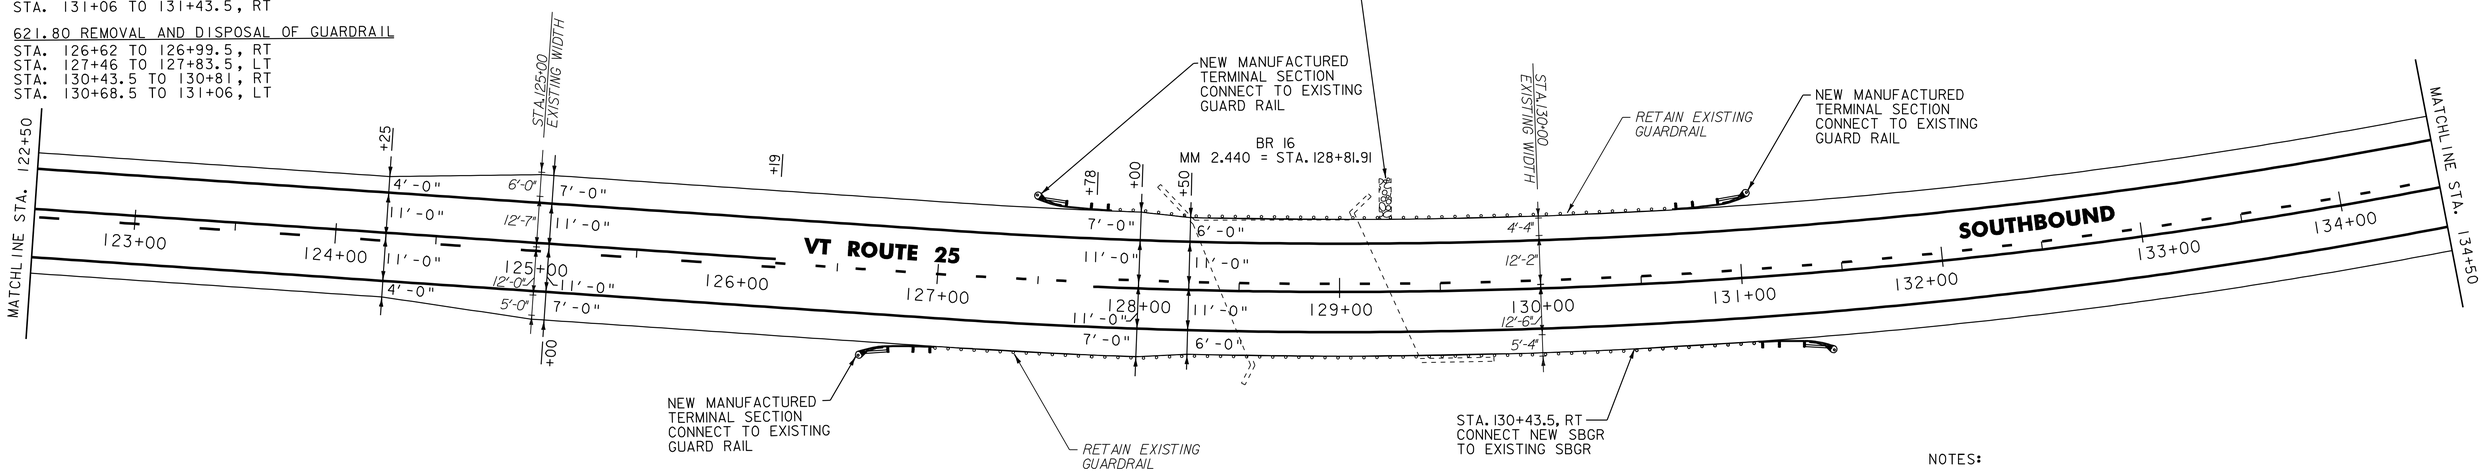

NOTES:
1. ALL EXISTING SIGNS NOT SHOWN SHALL BE RETAINED.
2. FOR LEGEND, SEE LAYOUT SHEET #1

NOT TO SCALE

Stantec

PROJECT LAYOUT SHEET #24

PROJECT NAME: BRADFORD - ORANGE
PROJECT NUMBER: STP 2213(I)

FILE NAME: p99b178.dgn
PROJECT LEADER: JLL
DESIGNED BY: STANTEC
IPARM FILE: p99b178124.i
PLOT DATE: 28-MAY-2010 13:4
DRAWN BY: STANTEC
CHECKED BY: JLL
SHEET 41 OF 84