646.20
~~646.402 DURABLE~~ 4 INCH WHITE LINE, ~~THERMOPLASTIC~~
STA. 206+50 TO 218+50, SOLID LT & RT

646.602 TEMPORARY 4 INCH WHITE LINE, PAINT
STA. 206+50 TO 218+50, SOLID LT & RT

646.21
~~646.412 DURABLE~~ 4 INCH YELLOW LINE, ~~THERMOPLASTIC~~
STA. 206+50 TO 218+50, SOLID LT & RT

646.612 TEMPORARY 4 INCH YELLOW LINE, PAINT
STA. 206+50 TO 218+50, SOLID LT & RT

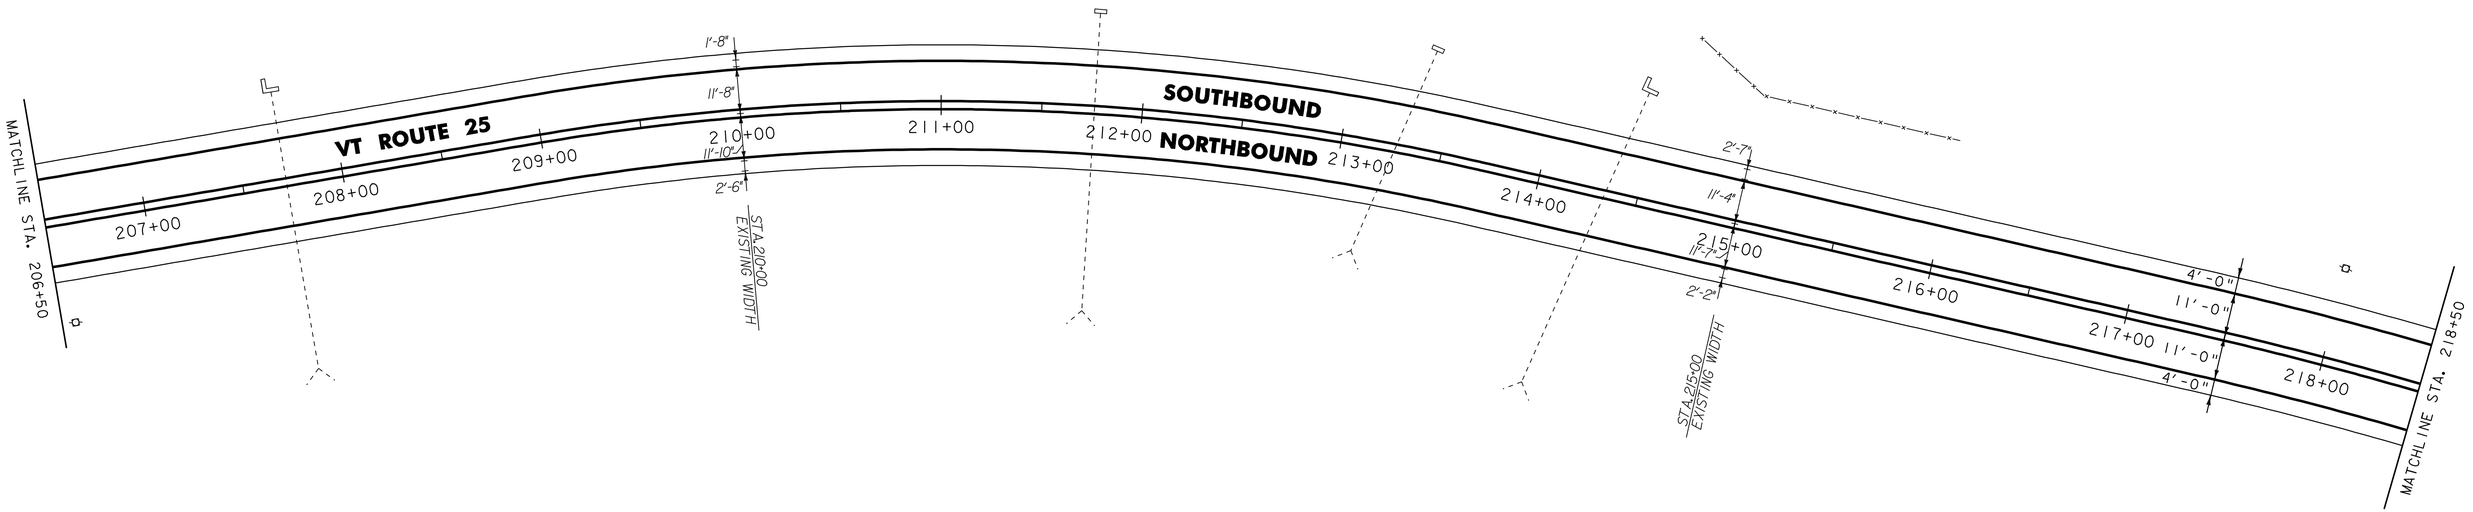

646.20
~~646.402 DURABLE~~ 4 INCH WHITE LINE, ~~THERMOPLASTIC~~
STA. 218+50 TO 230+50, SOLID LT & RT

646.602 TEMPORARY 4 INCH WHITE LINE, PAINT
STA. 218+50 TO 230+50, SOLID LT & RT

646.21
~~646.412 DURABLE~~ 4 INCH YELLOW LINE, ~~THERMOPLASTIC~~
STA. 218+50 TO 230+50, SOLID LT & RT

646.612 TEMPORARY 4 INCH YELLOW LINE, PAINT
STA. 218+50 TO 230+50, SOLID LT & RT

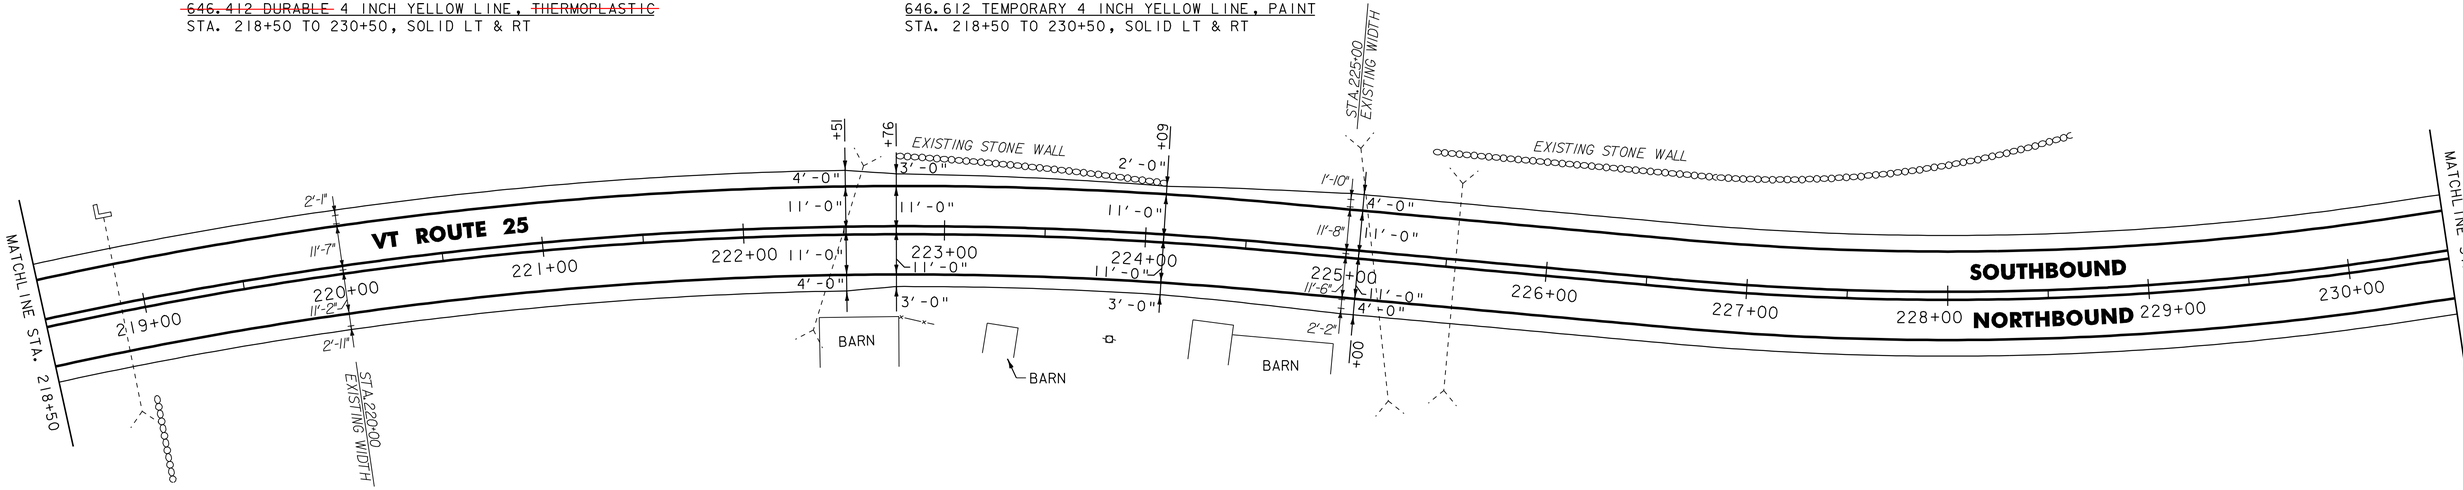

NOTES:
1. ALL EXISTING SIGNS NOT SHOWN SHALL BE RETAINED.
2. FOR LEGEND, SEE LAYOUT SHEET #1

NOT TO SCALE

PROJECT LAYOUT SHEET #30

Stantec

PROJECT NAME: BRADFORD - ORANGE
PROJECT NUMBER: STP 2213(1)

FILE NAME: p99b178.dgn
PROJECT LEADER: JLL
DESIGNED BY: STANTEC
IPARM FILE: p99b178l30.i
PLOT DATE: 28-MAY-2010 13:4
DRAWN BY: STANTEC
CHECKED BY: JLL
SHEET 47 OF 84