STATE OF VERMONT
AGENCY OF TRANSPORTATION

TRAFFIC SIGN SUMMARY SHEET #13

VAOT Metric

MILE MARKER, STATION, OR SIGN NUMBER	SIGN LEGEND	NEW AND SALVAGED SIGNS: SIGN DIMENSIONS: EA	WIDTH (mm)	HEIGHT (mm)	"A"	"B"	SALV. SIGN	SALV. T.I.S.	EXIST. POST: RETAIN	EXIST. POST: SALVAGE	NEW SIGN POSpbl84ss: NO. OF POSTS	FLANGED CHANNEL kg/m: 1.7	3.0	4.5	SQUARE STEEL (mm) kg/m: 44	50	63	ANCHOR	SLEEVE	TUBULAR ALUMINUM Ø (mm) kg/m: 75	100	100 MOD.	TUBULAR STEEL Ø (mm) kg/m: FOUNDATION	75	89	100	125	W-SHAPE STEEL FTG. SIZE: 600 mm	750 mm	WEIGHT	POST SIZE	SIGN FRAME REQUIRED	REMARKS	SIGN DETAIL: DETAIL ON SHEET NUMBER	STD. SHEET NUMBER
TOWN OF CLARENDON 2+873, LT.	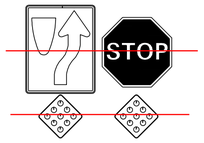	0 ~~1~~ 0 ~~1~~ 0 ~~2~~	000 ~~600~~ 000 ~~750~~ 000 ~~450~~	000 ~~750~~ 000 ~~750~~ 000 ~~450~~	000 ~~0.45~~ 000 ~~0.56~~ 000 ~~0.40~~						0 ~~1~~			NO ~~X~~				NO ~~X~~																ANCHOR PAID FOR UNDER ITEM 675.301 (MOD.) R 4 - 7 R 1 - 1 BACK TO BACK WITH MEDIAN SIGN OM - 1 BACK TO BACK WITH OBJECT MARKER		E-144M E-143M E-150M
2+873, RT.	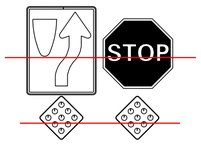	0 ~~1~~ 0 ~~1~~ 0 ~~2~~	000 ~~600~~ 000 ~~750~~ 000 ~~450~~	000 ~~750~~ 000 ~~750~~ 000 ~~450~~	000 ~~0.45~~ 000 ~~0.56~~ 000 ~~0.40~~						0 ~~1~~			NO ~~X~~				NO ~~X~~																ANCHOR PAID FOR UNDER ITEM 675.301 (MOD.) R 4 - 7 R 1 - 1 BACK TO BACK WITH MEDIAN SIGN OM - 1 BACK TO BACK WITH OBJECT MARKER		E-144M E-143M E-150M
2+882, 20m LT.		1 1	600 600	300 600	0.18 0.36						1			4.3 X																				M 3 - 3		E-136BM E-136BM
			900	900	0.81						2			8.7																							
2+885, RT.		1	750	750	0.56						1			4.3 X																				R 1 - 1		E-143M
2+885, 60m RT.	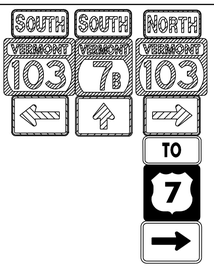	3 2 1 3 1 1 1	600 750 600 525 600 600 525	300 600 600 375 300 600 375	0.54 0.90 0.36 0.60 0.18 0.36 0.20						2			11.0 X																			X	M 3- 3, M 3- 3, M 3- 1 M 6- 1, M 6- 3, M 6- 1 M 4- 5 M 1 - 4 M 6- 1		E-136BM E-136BM E-136BM E-136BM E-136AM E-136AM E-136AM
2+885, 180m RT.		1 1	525 750	375 600	0.20 0.45						1			4.1 X																				M 2 - 1		E-136BM E-136BM
2+890, RT.		1 1	525 600	375 600	0.20 0.36						1			4.6 X																				M 2 - 1 M 1 - 4		E-136AM E-136AM
2+940, RT.		1 1	600 750	300 600	0.18 0.45						1			4.6 X																				M 3 - 1		E-136BM E-136BM
			m²	m²	EA.	m²						m	m	m 41.4	m	m	m		EA	kg	kg	kg 23.0		kg	kg	kg	kg								
TOTALS			m² 8.90	m²	EA.	m²						m 41.4			m					kg 23.0			EA.	kg				EA.	EA.	kg					

FINAL POST LENGTHS ARE TO BE DETERMINED IN THE FIELD.
POST SIZES ARE COMPUTED BASED ON INFORMATION FURNISHED ON THE STANDARD SHEETS AND THE TRAFFIC AND SAFETY DIVISION'S "SIGN POST DESIGN GUIDELINE."

PROJECT: WALLINGFORD-CLARENDON
PROJECT NO.: NH 2216(1)S

DESIGN FILE NAME: /pave/99pbl84/pbl84.dgn
IPARM FILE NAME: pbl84ssl3.i
SURVEYED BY: SJL, ACT
SQUAD LEADER: JAV

PLOT DATE: 13-NOV-2013 13:
SURVEY DATE:
DRAWN BY: ACT
SHEET: 45 OF 51