STATE OF VERMONT
AGENCY OF TRANSPORTATION

TRAFFIC SIGN SUMMARY SHEET #14

VAOT Metric

MILE MARKER, STATION, OR SIGN NUMBER	SIGN LEGEND	SIGN DIMENSIONS EA	WIDTH (mm)	HEIGHT (mm)	NEW AND SALVAGED SIGNS "A"	"B"	SALV. SIGN	SALV. T.I.S.	EXIST. POST RETAIN	EXIST. POST SALVAGE	NEW SIGN POSpbl84ss NO. OF POSTS	FLANGED CHANNEL kg/m 1.7	3.0	4.5	SQUARE STEEL (mm) kg/m 44 3.4	50 3.9	63 5.0	ANCHOR	SLEEVE	TUBULAR ALUMINUM Ø (mm) kg/m 75 1.9	100 2.5	100 MOD. 2.5	TUBULAR STEEL Ø (mm) FOUND-ATION	kg/m 75 11.3	89 13.4	100 16.1	125 21.7	W-SHAPE STEEL FTG. SIZE 600 mm	750 mm	WEIGHT	POST SIZE	SIGN FRAME REQUIRED	REMARKS	SIGN DETAIL DETAIL ON SHEET NUMBER	STD. SHEET NUMBER
TOWN OF CLARENDON 2+890, LT.	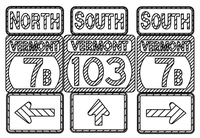	3	600	300	0.54						2			9.8 X																	X	M 3- 1, M 3- 3, M 3- 3		E-136BM
		2	600	600	0.72																														
		1	750	600	0.45																													M 6- 1, M 6- 3, M 6- 1		E-136BM
		3	525	375	0.60																														E-136BM
2+990, RT.	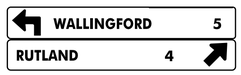	1	1800	250	0.45						2			9.5 X																					E-123M
		1	1800	250	0.45																														E-123M
037 3+~~030~~, LT.		1	525	375	0.20						1			4.9 X																					M 2 - 3		E-136BM
		1	600	600	0.36																														E-136BM
3+044, ℄	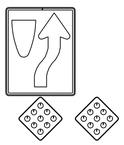	1	600	750	0.45						1			4.0 X				X																	ANCHOR PAID FOR UNDER ITEM 675.301 (MOD.) R 4 - 7		E-144M
		2	450	450	0.40																													OM - 1 BACK TO BACK WITH OBJECT MARKER		E-150M
3+050, RT.		2	600	300	0.36						2			9.6 X																			X	M 3- 3, M 3- 1		E-136AM
		2	600	600	0.72																													M 1 - 4, M 1 - 4		E-136AM
		2	525	375	0.40																													M 5- 1, M 6- 2		E-136AM
3+068, LT.		1	750	750	0.56						0 ~~2~~			NO ~~X~~																					W2 - 1 MOUNTED WITH ABOVE SIGNS		E-155M
		1	450	450	0.20																													W13 - 1		E-155M
3+100, RT.		1	450	450	0.20						1		2.4 X																					OM - 1		E-150M
3+105, LT.	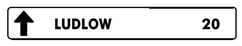	1	1800	250	0.45						2			8.4 X																						E-123M
3+130, RT.		2	600	300	0.36						0 ~~2~~			NO X																			X	M 3- 3, M 4- 6		E-136AM E-136BM
		1	600	600	0.36																													M 1 - 4		E-136AM E-136BM
		1	750	600	0.45																													M 6- 1		E-136AM
		1	525	375	0.20																															

FINAL POST LENGTHS ARE TO BE DETERMINED IN THE FIELD.
POST SIZES ARE COMPUTED BASED ON INFORMATION FURNISHED ON THE STANDARD SHEETS AND THE TRAFFIC AND SAFETY DIVISION'S "SIGN POST DESIGN GUIDELINE."

		m²	m²	EA.	m²		m	m	m	m	m	m		EA	kg	kg	kg		kg	kg	kg	kg					
								4.6	64.4																		
TOTALS		m² 8.88	m²	EA.	m²		m 69.0			m			kg		EA.	kg				EA.	EA.	kg					

PROJECT: WALLINGFORD-CLARENDON
PROJECT NO.: NH 2216(1)S

DESIGN FILE NAME: /pave/99pbl84/pbl84.dgn
IPARM FILE NAME: pbl84ssl4.i
SURVEYED BY: SJL, ACT
SQUAD LEADER: JAV

PLOT DATE: 13-NOV-2013 13:
SURVEY DATE:
DRAWN BY: ACT
SHEET: 46 OF 51