




FED. ROAD REG. NO.	STATE	FEDERAL AID PROJECT NO.	SHEET NO.	TOTAL SHEETS
1	N.Y.	0146001	29	92

BENNINGTON CONNECTOR S.H. 98-2
P.I.N. 1306.60
WHITEHOUSE BRIDGE - VERMONT STATE LINE S.H. 1426
RENSSELAER COUNTY

FILE NAME = \\SUS\NYS\DOT\CONTRACTS\1516\mp.tdgn
 DATE/TIME = 2/23/2004
 USER = 2225
 IN CHARGE OF T. KARRS
 DESIGNED BY D. EMERICH
 CHECKED BY D. EMERICH
 ESTIMATED BY D. EMERICH
 DRAFTED BY D. GOZALKOWSKI
 CHECKED BY D. GOZALKOWSKI
 C. KAHLBAUGH
 DRAFTED BY C. KAHLBAUGH
 CHECKED BY I. BURTNICK
 DATE 2/04

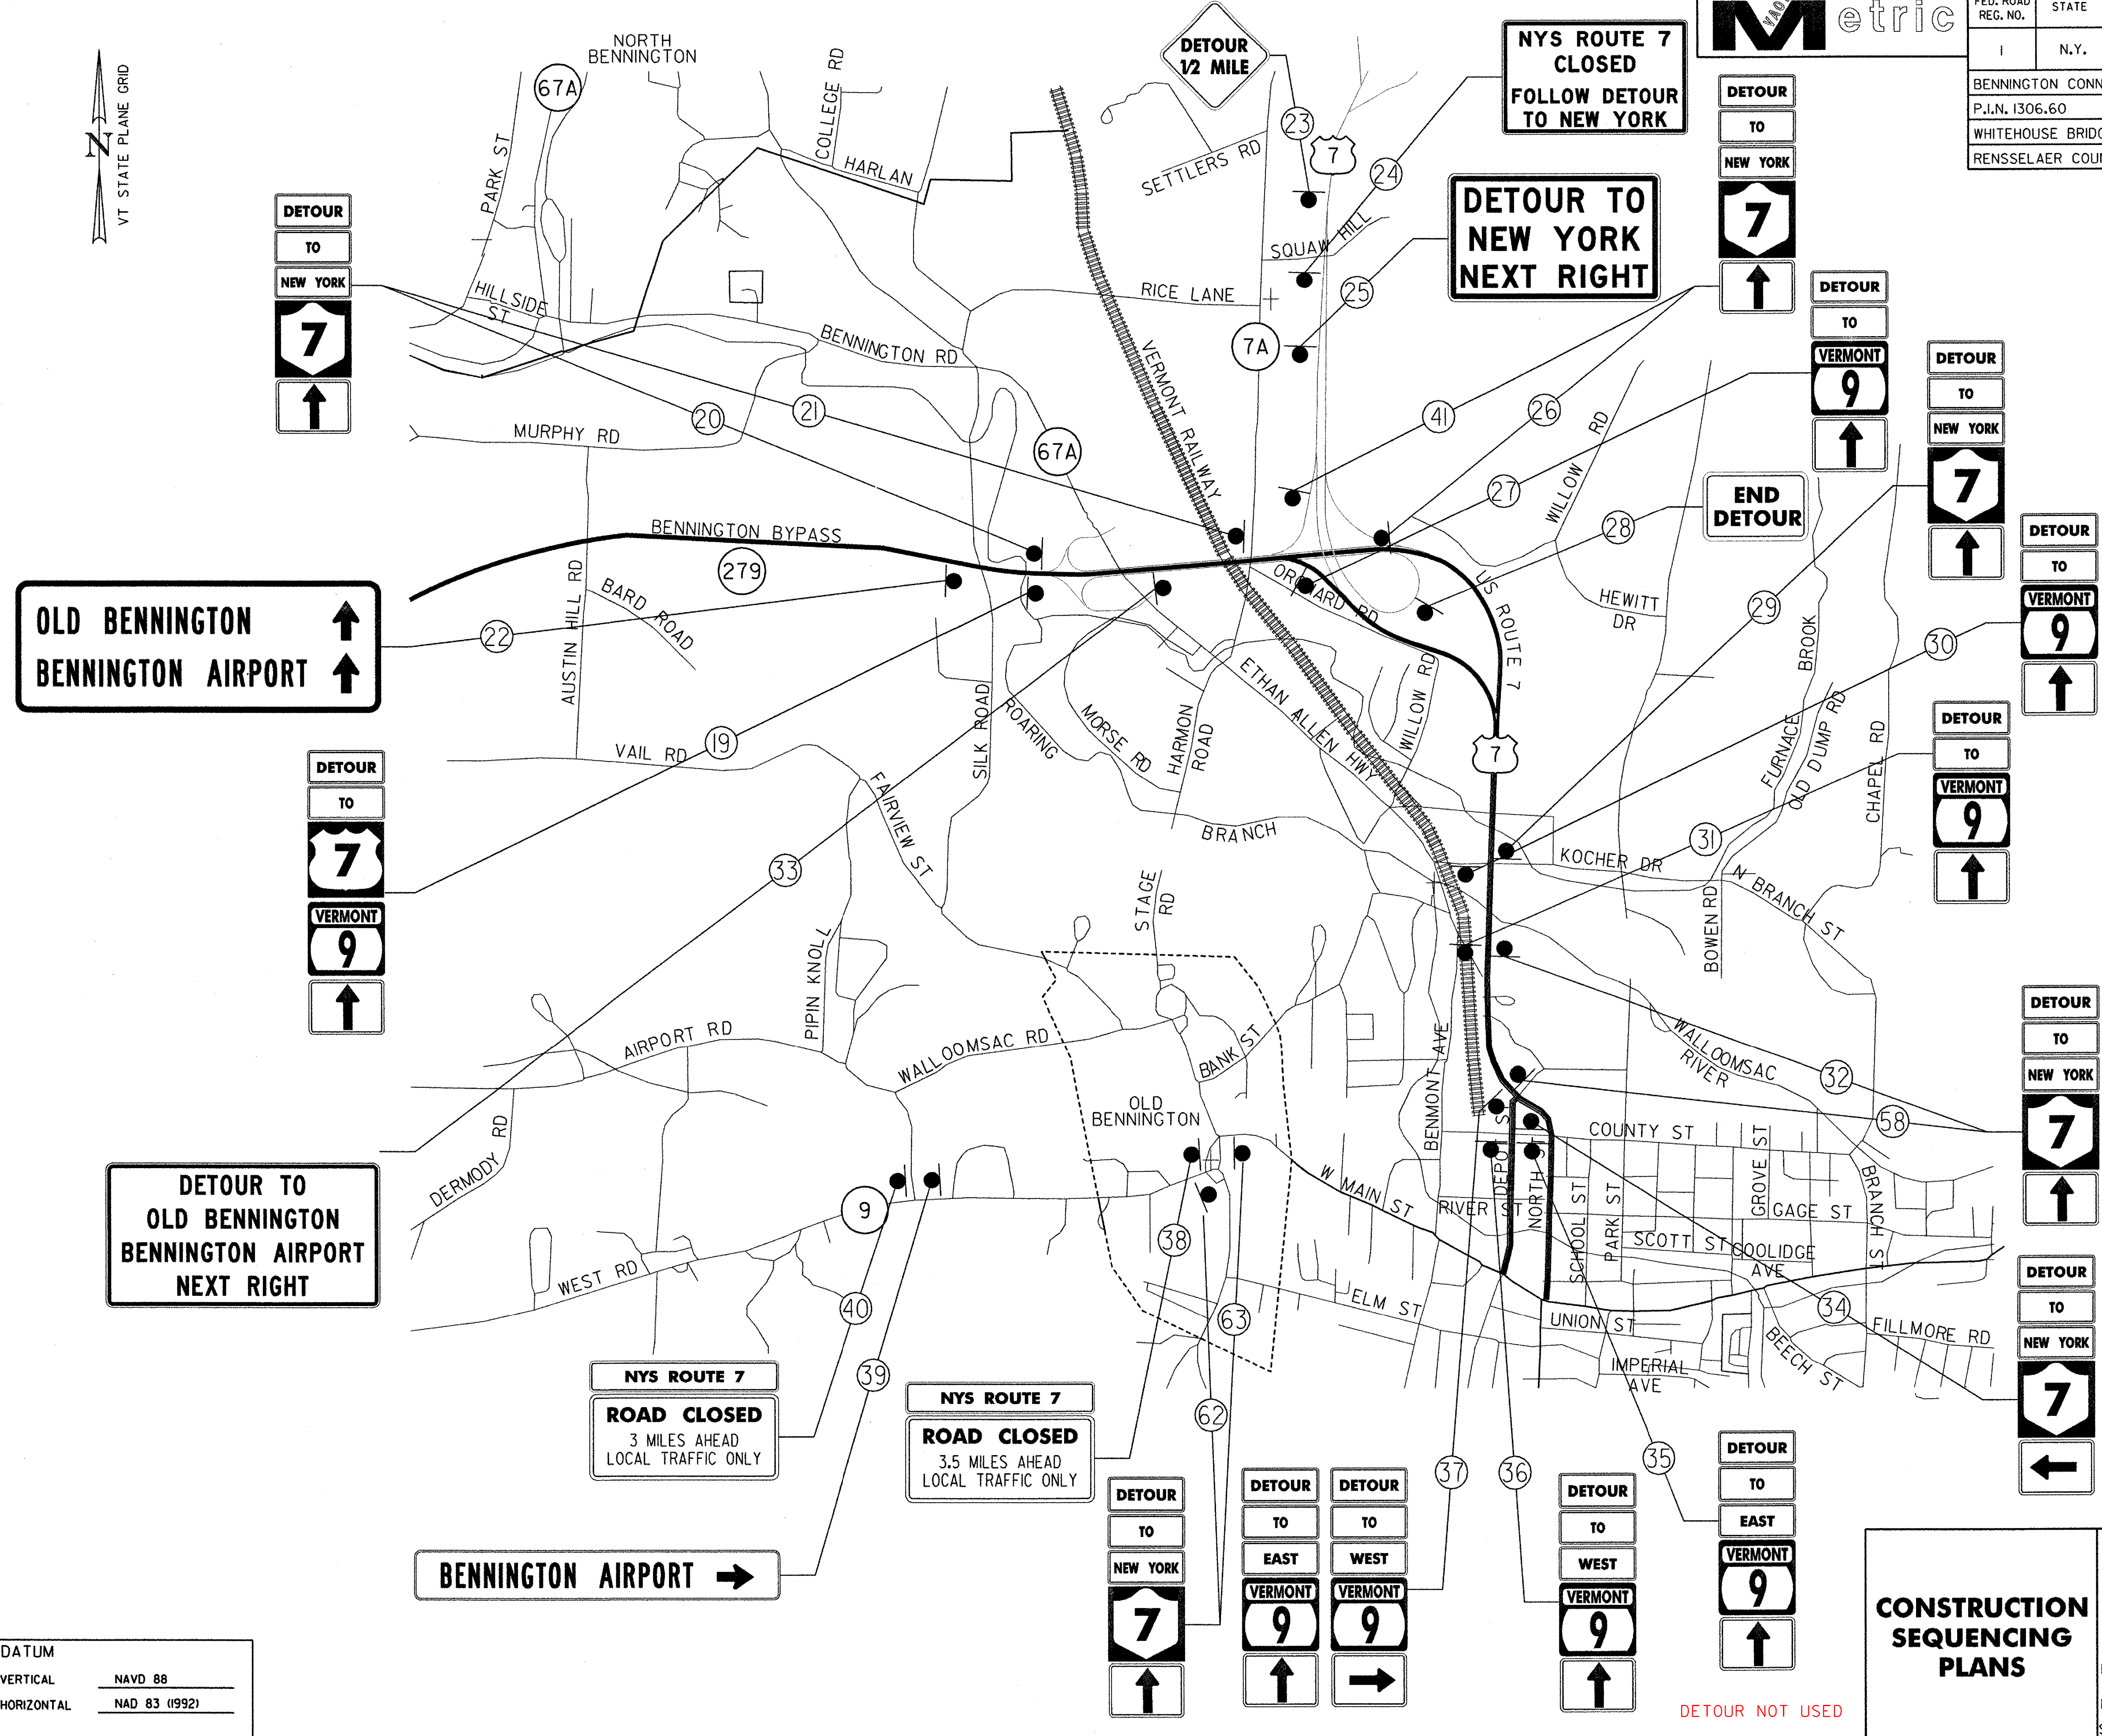

OLD BENNINGTON ↑
BENNINGTON AIRPORT ↑

DETOUR TO OLD BENNINGTON
BENNINGTON AIRPORT
 NEXT RIGHT

BENNINGTON AIRPORT →

NYS ROUTE 7
ROAD CLOSED
 3 MILES AHEAD
 LOCAL TRAFFIC ONLY

NYS ROUTE 7
ROAD CLOSED
 3.5 MILES AHEAD
 LOCAL TRAFFIC ONLY

NYS ROUTE 7
CLOSED
FOLLOW DETOUR
TO NEW YORK

DETOUR TO NEW YORK
 NEXT RIGHT

DETOUR TO NEW YORK
 ↑

DETOUR TO VERMONT
 ↑

END DETOUR

DETOUR TO NEW YORK
 ↑

DETOUR TO VERMONT
 ↑

DETOUR TO VERMONT
 ↑

DETOUR TO NEW YORK
 ↑

DETOUR TO NEW YORK
 ↑

DETOUR TO NEW YORK
 ↑

DETOUR TO EAST VERMONT
 ↑

DETOUR TO WEST VERMONT
 →

DETOUR TO WEST VERMONT
 ↑

DETOUR TO EAST VERMONT
 ↑

DETOUR NOT USED

LEGEND
 ——— DETOUR ROUTE

CONSTRUCTION SEQUENCING PLANS

SURVEYED BY C.H.A. & V.S.E. DATE 12/93
 DESIGNED BY D.W.E. DATE 2/04
 DRAWN BY C.A.K. DATE 2/04
 CHECKED BY T.P.K. DATE 2/04
 DESIGN FILE NO. 5116MPT.DGN
 PROJ. NAME BENNINGTON - HOOSICK
 D.P.I. 0146(1) C/1
 PROJ. NO. P.I.N. 1306.60
 SHEET 29 OF 92 DWG NO. CSP-5

DATUM

VERTICAL	NAVD 88
HORIZONTAL	NAD 83 (1992)