FED. ROAD REG. NO.	STATE	FEDERAL AID PROJECT NO.	SHEET NO.	TOTAL SHEETS
1	N.Y.	0146001	64	92

BENNINGTON CONNECTOR S.H. 98-2

P.I.N. 1306.60

WHITEHOUSE BRIDGE - VERMONT STATE LINE S.H. 1426

RENSSELAER COUNTY

NOTE:

1. SEE DWG'S. STD-1 TO STD-2 FOR SIGN TEXT DATA.

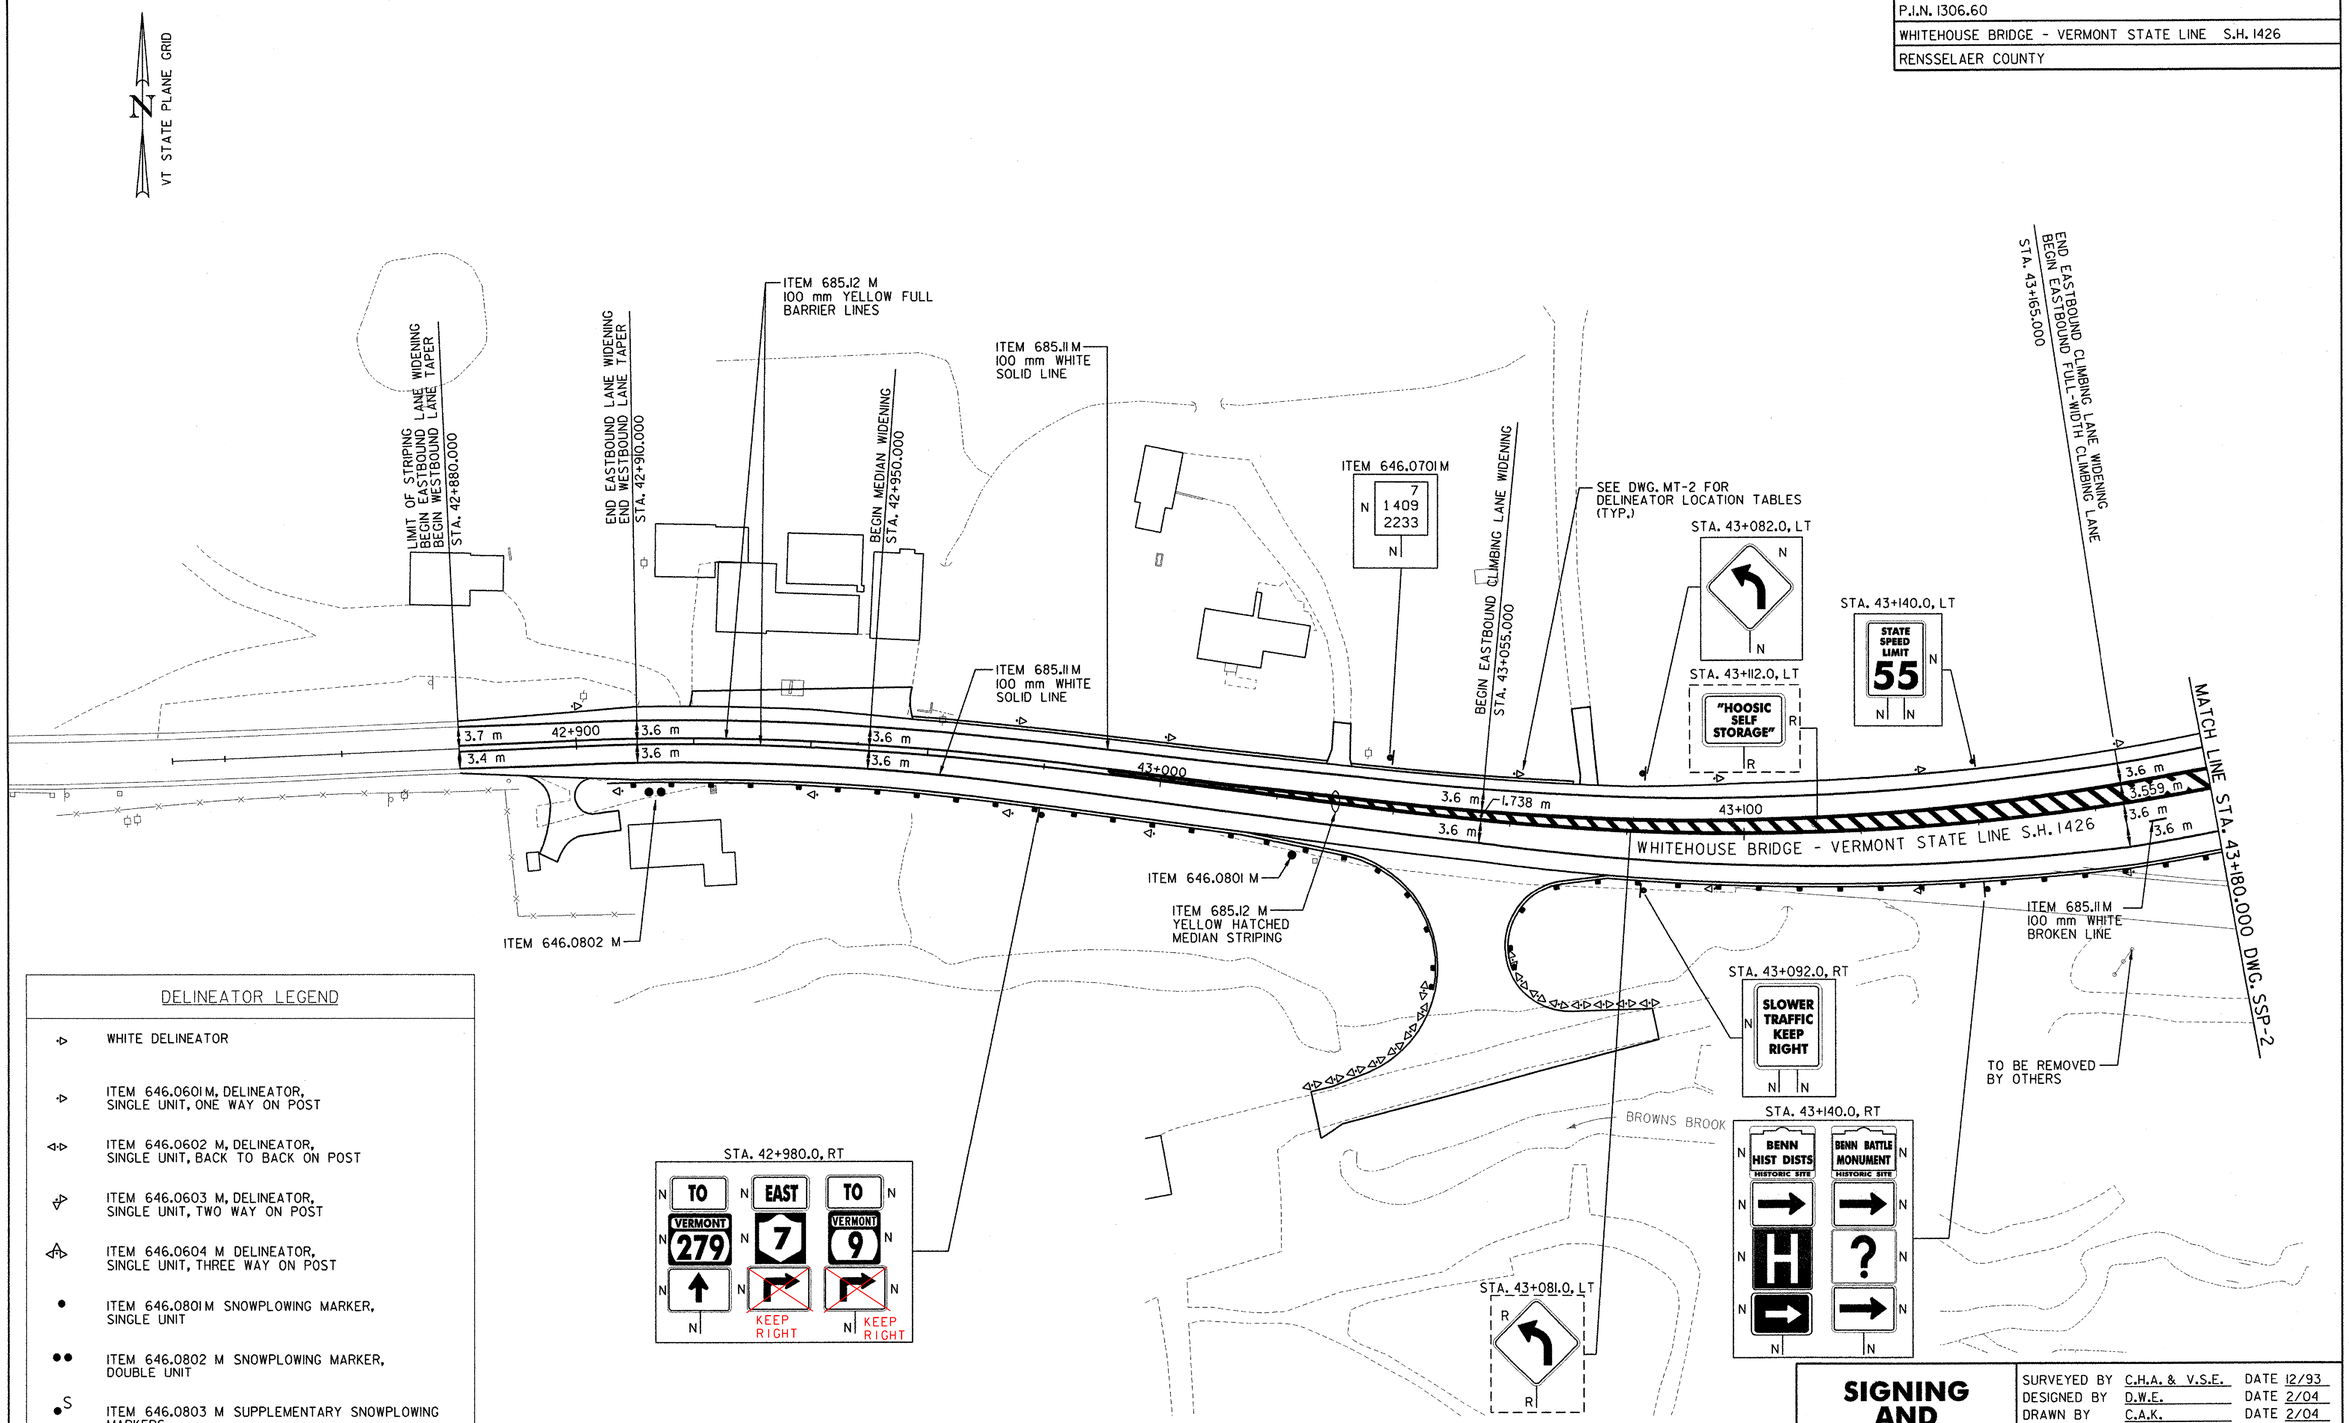

SIGNING AND STRIPING PLAN STA. 42+880 TO STA. 43+180

SURVEYED BY	C.H.A. & V.S.E.	DATE 12/93
DESIGNED BY	D.W.E.	DATE 2/04
DRAWN BY	C.A.K.	DATE 2/04
CHECKED BY	T.P.K.	DATE 2/04

DESIGN FILE NO. NYSSPI.DGN

PROJ. NAME BENNINGTON - HOOSICK D.P.I. 0146(1) C/1

PROJ. NO. P.I.N. 1306.60

SHEET 64 OF 92 DWG NO. SSP-1

CHECKED BY D. GOZALKOWSKI DRAFTED BY C. KAHLBAUGH CHECKED BY T. BURTNICK DATE 2/04

ESTIMATED BY D. EMERICH CHECKED BY D. GOZALKOWSKI

DESIGNED BY D. EMERICH CHECKED BY

IN CHARGE OF T. KARIS

FILE NAME = u:\5116\nysdot\contract1\nysspi.dgn
DATE/TIME = 2/23/2004
USER = 2225