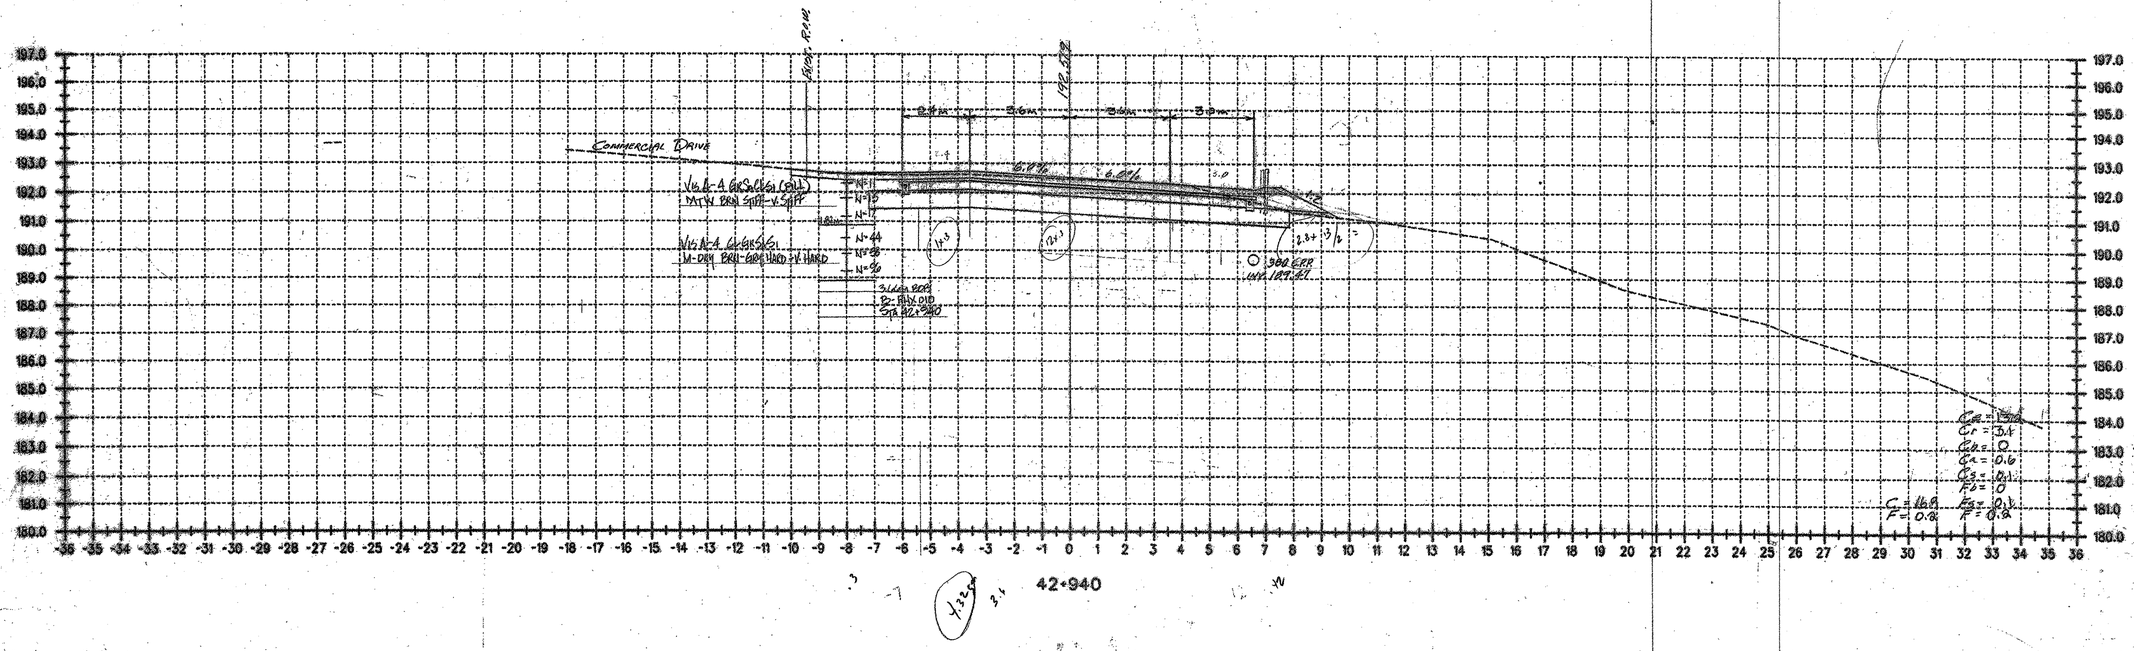

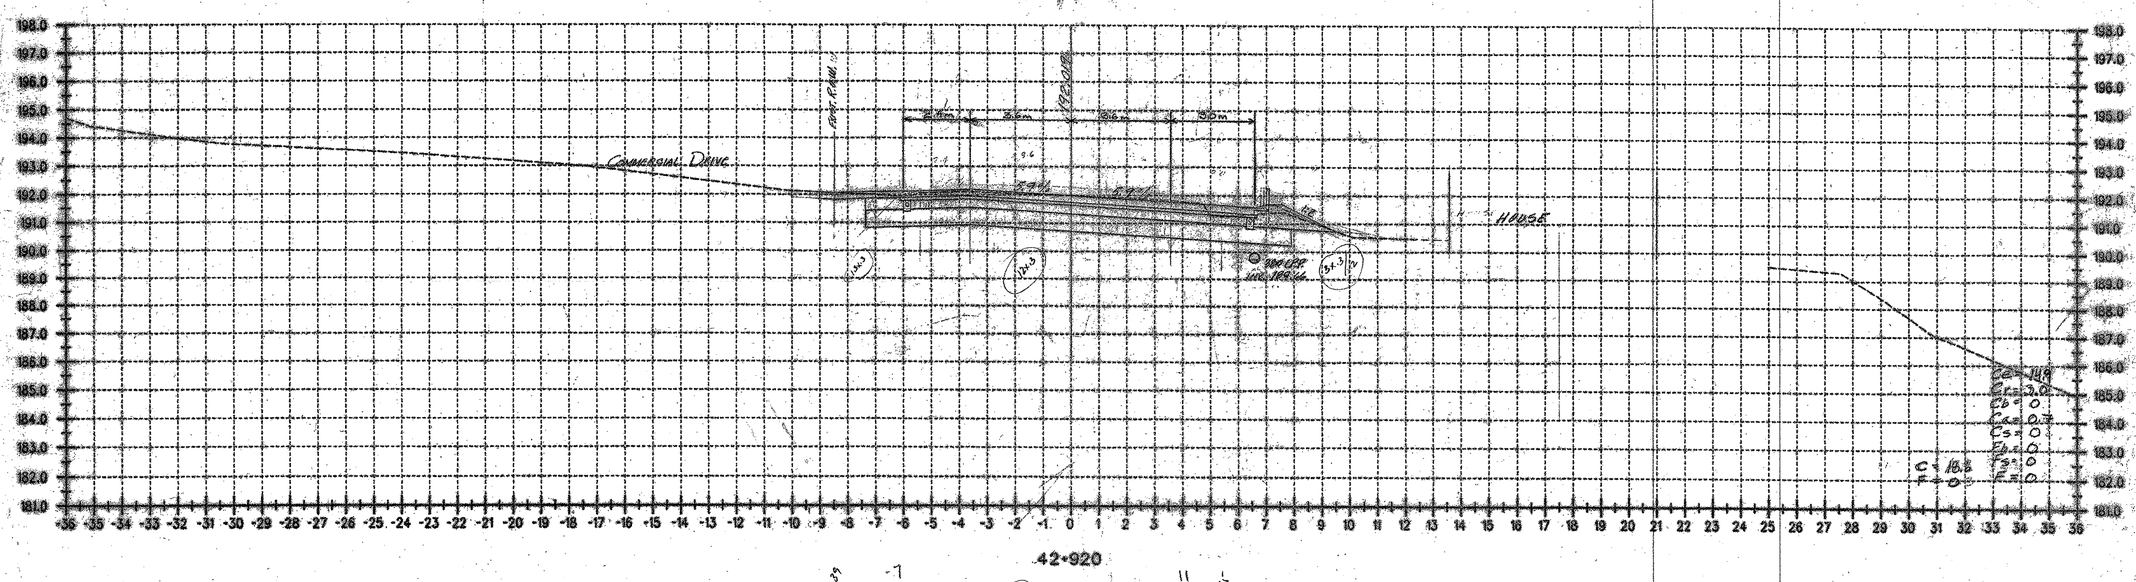

SURVEYED BY	C.H.A. & V.S.E. DATE 12/95
DRAWN BY	J.S.L. DATE 11/02
SQUAD LEADER	T.P.K.
DESIGN FILE NO.	N/A
IPARM FILE	DATE PLOTTED
PROJ. NAME	BENNINGTON - HOOSICK D.P.I. 0146(1)
PROJ. NO.	P.I.N. 1308.60.201
SHEET	74 OF 92 SHEETS

DATUM
VERTICAL NGVD 88
HORIZONTAL NAD 83 (1992)

ALL DIMENSIONS IN MILLIMETERS EXCEPT AS INDICATED
2 0 2 m
H 1:100
V 1:100