Metric

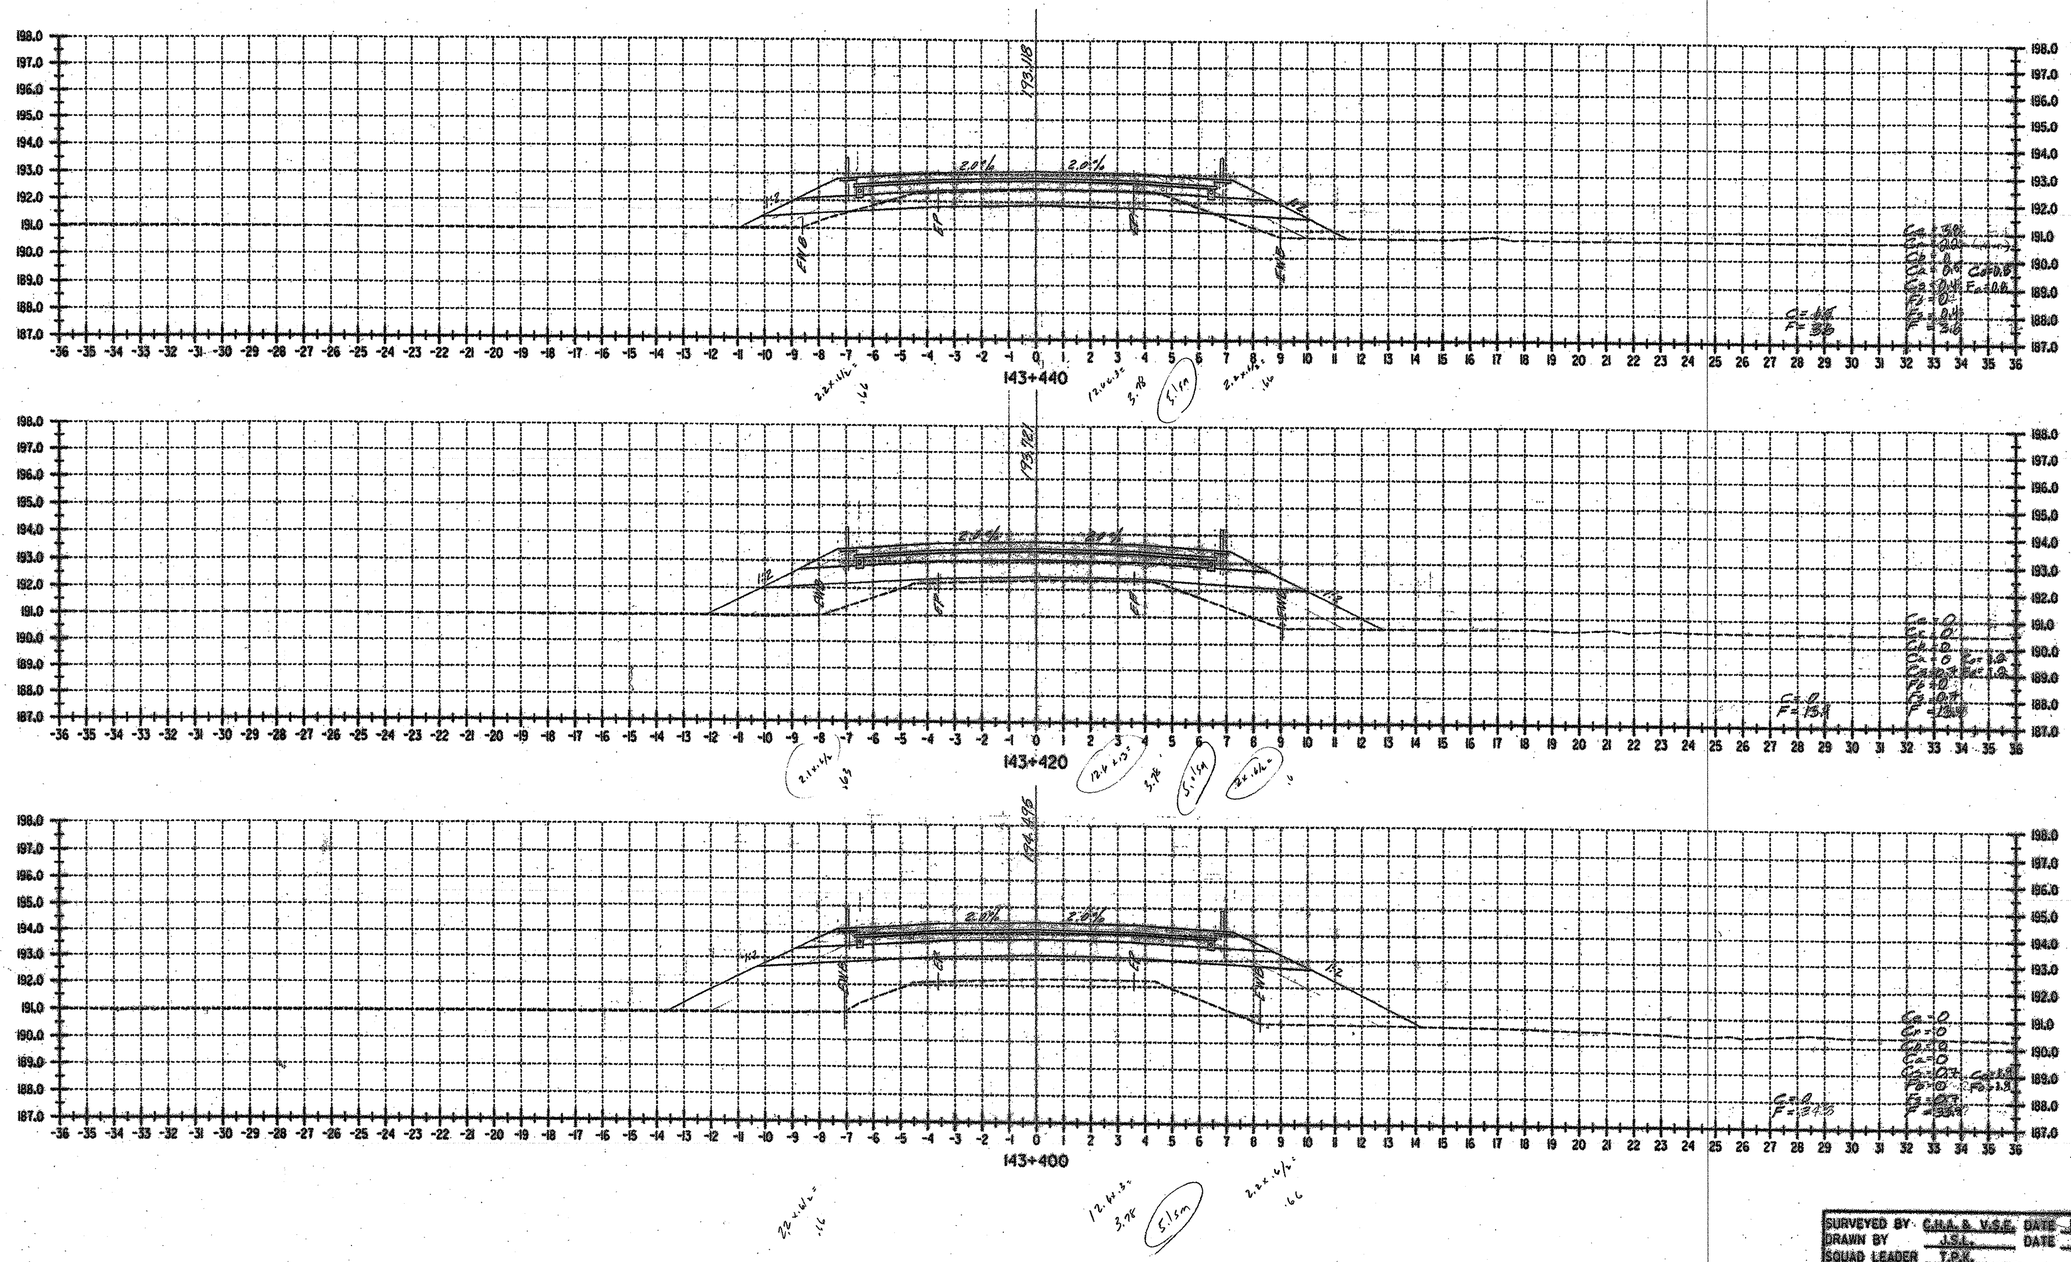

DATUM	
VERTICAL	NAVD 88
HORIZONTAL	NAD 83 (1992)

ALL DIMENSIONS IN MILLIMETERS EXCEPT AS INDICATED

2 0 2 m

H 1:100
V 1:100

SURVEYED BY C.H.A. & V.S.E. DATE 10/92
DRAWN BY J.S.L. DATE 11/92
SQUAD LEADER T.P.K.
DESIGN FILE NO. N/A
IPARM FILE _____ DATE PLOTTED _____
PROJ. NAME BENNINGTON - HODSICK D.P.I. 014600
PROJ. NO. P.I.N. 1306.60301
SHEET 84 OF 92 SHEETS