STATE OF VERMONT
AGENCY OF TRANSPORTATION

TRAFFIC SIGN SUMMARY SHEET

Next Metric

KILOMETER MARKER, STATION, OR SIGN NUMBER	SIGN LEGEND	SIGN DIMENSIONS EA	WIDTH (mm)	HEIGHT (mm)	NEW & SALVAGED SIGNS "A"	"B"	SALV SIGN	SALV TIS	EXIST POST RETAIN	EXIST POST SALVAGE	NEW SIGN POSTS NO. OF POSTS	FLANGED CHANNEL kg/m 1.7	3.0	4.5	SQUARE STEEL (mm) kg/m 44 2.8	50 3.2	63 5.0	ANCHOR	SLEEVE	TUBULAR ALUMINUM Ø (mm) kg/m 75 1.9	100 2.5	100 MOD 2.5	FOUNDATION	TUBULAR STEEL Ø (mm) kg/m 75 11.3	89 13.4	100 16.1	125 21.7	W-SHAPE STEEL FTG. SIZE 600 mm	750 mm	MASS	POST SIZE	SIGN FRAME REQUIRED	REMARKS	SIGN DETAIL DETAIL ON SHEET NUMBER	STD. SHEET NUMBER
VT. RTE 9 16+475.0, RT		1	1200	1200	1.44						2			~~X~~								X												[SIGN ID CODE VW-005]		E-150M
16+527.6, RT	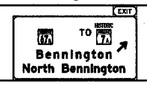	1 1	1400 7350	600 3750	0.84	27.56					3																		3	994.6	W310X44.5		[SIGN ID CODE EI-5] [SIGN ID CODE EI-IC]	TSD-3 TSD-3	
16+552.4, LT		1	900	1200	1.08						1										X												[SIGN ID CODE R4-6]		E-141M
16+636.6, LT		1	900	1200	1.08						1									X														[SIGN ID CODE R2-1]		E-142M
		1	150	200	0.03																													[SIGN ID CODE VD-700]		E-138M
16+680.0, RT		1	900	1200	1.08						1			X																				[SIGN ID CODE R2-1]		E-142M
	SHEET SUBTOTAL SHEET TSS-1 SUBTOTAL SHEET TSS-2 SUBTOTAL				5.55 9.03 5.81	27.56 10.08 2.48						- 2.5 14.1	- - -	14.4 25.9 38.8							7.3 21.9 7.3	11.1 - -	- - -	- 6 2	- 192.5 96.2	- - -	- 164.2 -	- - -		3 - -	994.6 - -	W310x44.5 - -				
	SHEET TSS-3 SUBTOTAL SHEET TSS-4 SUBTOTAL SHEET TSS-5 SUBTOTAL				10.32 4.62 4.71	- 2.99 32.04						7.5 27.0 8.1	- - -	43.2 38.8 36.7							7.3 - -	11.1 11.1 11.1	- - -	2 2 -	96.1 110.7 -	- - -	- - -	- - -		- - 3	- - 1234.8	- - W310x44.5				
	SHEET TSS-6 SUBTOTAL				6.45	32.04						5.4	-	16.8							24.5	11.1	-	-	-	-	-	-		3	1054.7	W310x44.5				
												m 64.6	m -	m 214.6	m	m	m	EA		kg 68.3	kg 55.5	kg		kg 495.5	kg -	kg 164.2	kg		EA.	kg					
	TOTALS				m^2 46.49	m^2 107.19	EA.	m^2				m 279.2			m					kg 123.8	EA. 12	kg 659.7		EA.	EA. 9	kg 3284.1							

RMT 2/3/06

AS-BUILT NOTE: SEE NOTE ON SHEET 158

FINAL POST LENGTHS ARE TO BE DETERMINED IN THE FIELD. POST SIZES ARE COMPUTED BASED ON INFORMATION FURNISHED ON THE STANDARD SHEETS AND THE THAFFIC & SAFETY DIVISION'S "SIGN POST DESIGN GUIDELINE."

PROJECT: BENNINGTON - HOOSICK
PROJECT NO.: D.P.I. 0146(1) C/3

DESIGN FILE NAME:
IPARM FILE NAME: N/A
SURVEYED BY: N/A
SQUAD LEADER: T.P.K.
DWG. NO. TSS-7

PLOT DATE: 11/01
SURVEY DATE: N/A
DRAWN BY: E.C.D.
SHEET: 164 OF 473

FILE NAME =u:\5116\VAOT\CONTRACT3\TSS-1.DGN
DATE/TIME =10/11/2001
USER =864