Metric

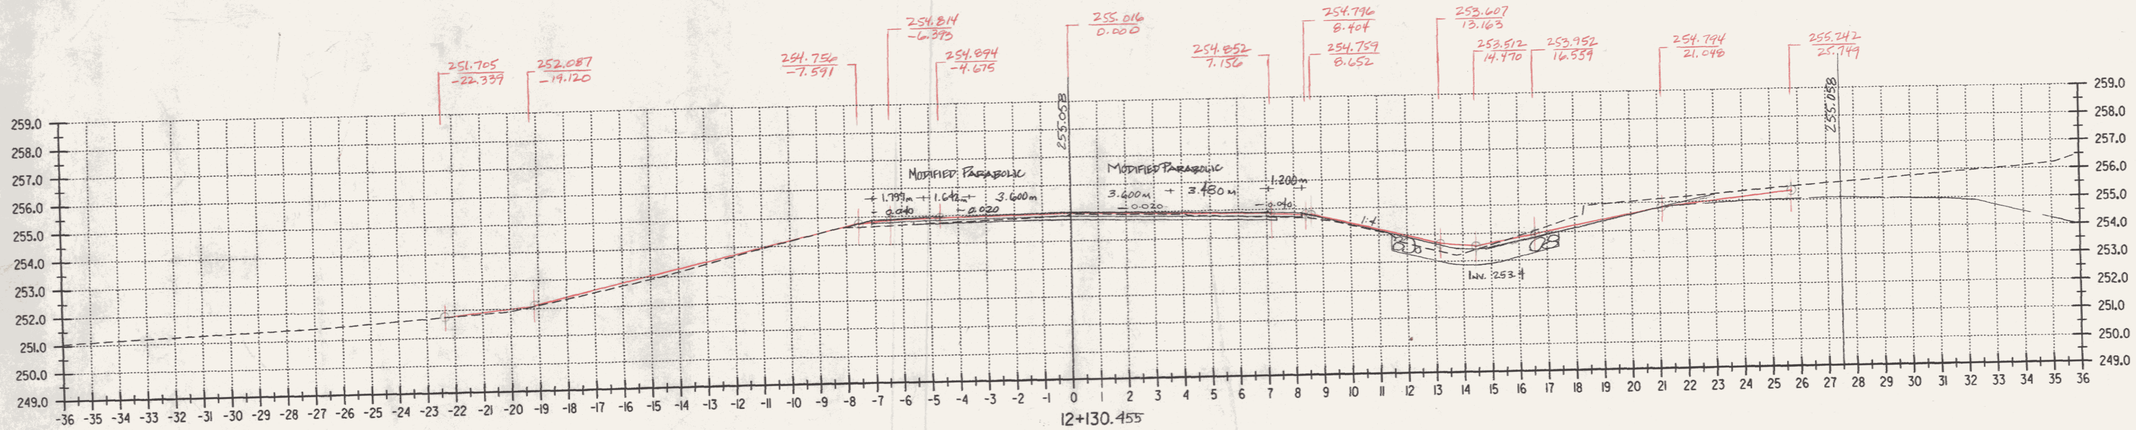

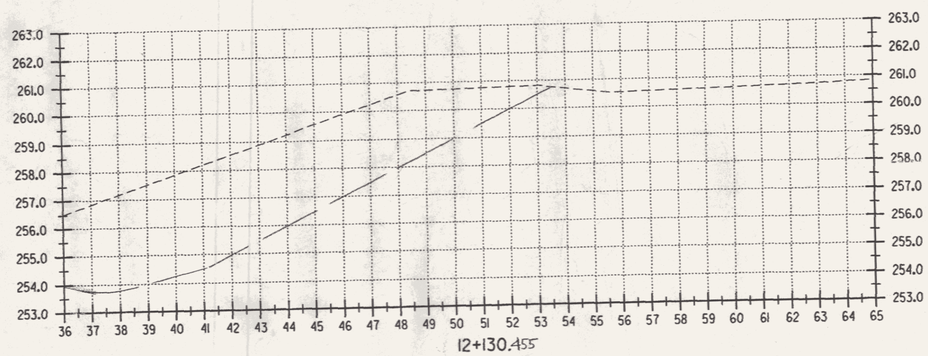

C = 0 $0m^2$
F = 0 $0m^2$
R = 0 $0m^2$

FG. RHT 2/17/05 | JKW 2/17/05

GENERAL NOTE:

LANE AND SHOULDER DIMENSIONS HAVE BEEN PROVIDED ON THE CROSS SECTIONS AT CRITICAL PAVEMENT TRANSITION POINTS. CROSS SECTIONS THAT ARE NOT DIMENSIONED SHOULD BE ASSUMED TO HAVE THE SAME LANE AND SHOULDER DIMENSIONS AS THE PREVIOUSLY DIMENSIONED CROSS SECTION.

DATUM
VERTICAL NAVD 88
HORIZONTAL NAD 83 (1992)

ALL DIMENSIONS IN MILLIMETERS EXCEPT AS INDICATED
2 0 2 m
H 1:100
V 1:100

SURVEYED BY C.H.A. & V.S.E. DATE 12/93
DRAWN BY J.S.L. DATE 7/01
SQUAD LEADER T.P.K.
DESIGN FILE NO. /5116/VAOT/VTSECT4.D
IPARM FILE ____ DATE PLOTTED ____
PROJ. NAME BENNINGTON - HOOSICK D.P.I. 0146(1) C/3
PROJ. NO. P.I.N. 1306.60
SHEET 307 OF 473 SHEETS

97 b 218