Metric

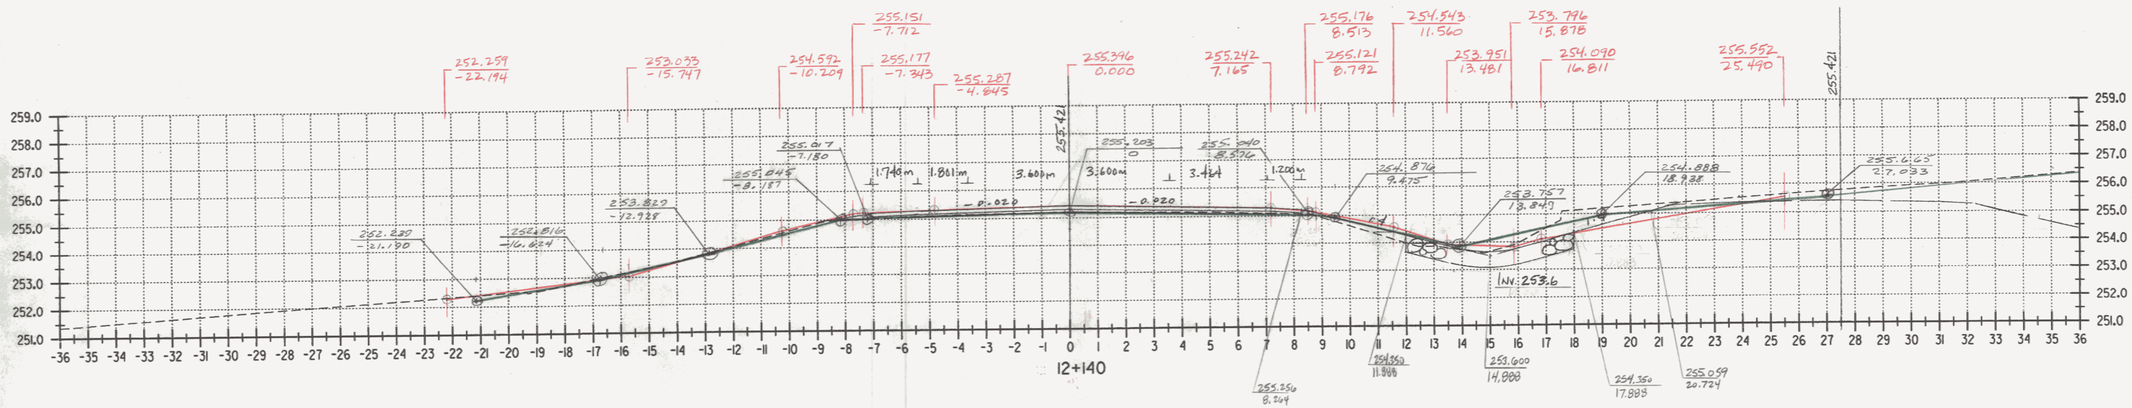


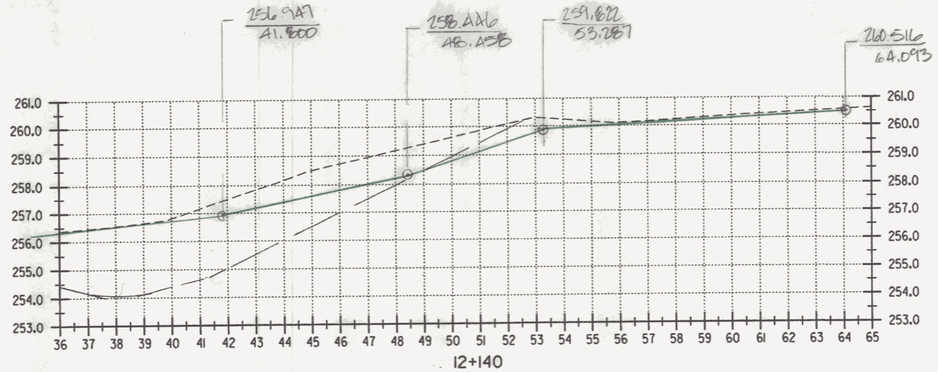


C = 0 1.79m²
F = 0 0m²
R = 0 0m²

OG Plotted by J.M 10/31/02
Checked by
FG. RHT 2/17/05 VIFW 2/17/05

| | |
|---|---|
| SURVEYED BY C.H.A. & V.S.E. | DATE 12/93 |
| DRAWN BY J.S.L. | DATE 7/01 |
| SQUAD LEADER T.P.K. | |
| DESIGN FILE NO. /5116/VAOT/VTSECT4.D | |
| IPARM FILE | DATE PLOTTED |
| PROJ. NAME BENNINGTON - HOOSICK D.P.I. 0146(1) C/3 | |
| PROJ. NO. P.I.N. 1306.60 | 12+140 |
| SHEET 308 OF 473 SHEETS | |

ALL DIMENSIONS IN MILLIMETERS EXCEPT AS INDICATED

2 0 2 m

H 1:100
V 1:100

DATUM

| | |
|---|---|
| VERTICAL | NAVD 88 |
| HORIZONTAL | NAD 83 (1992) |