Metric

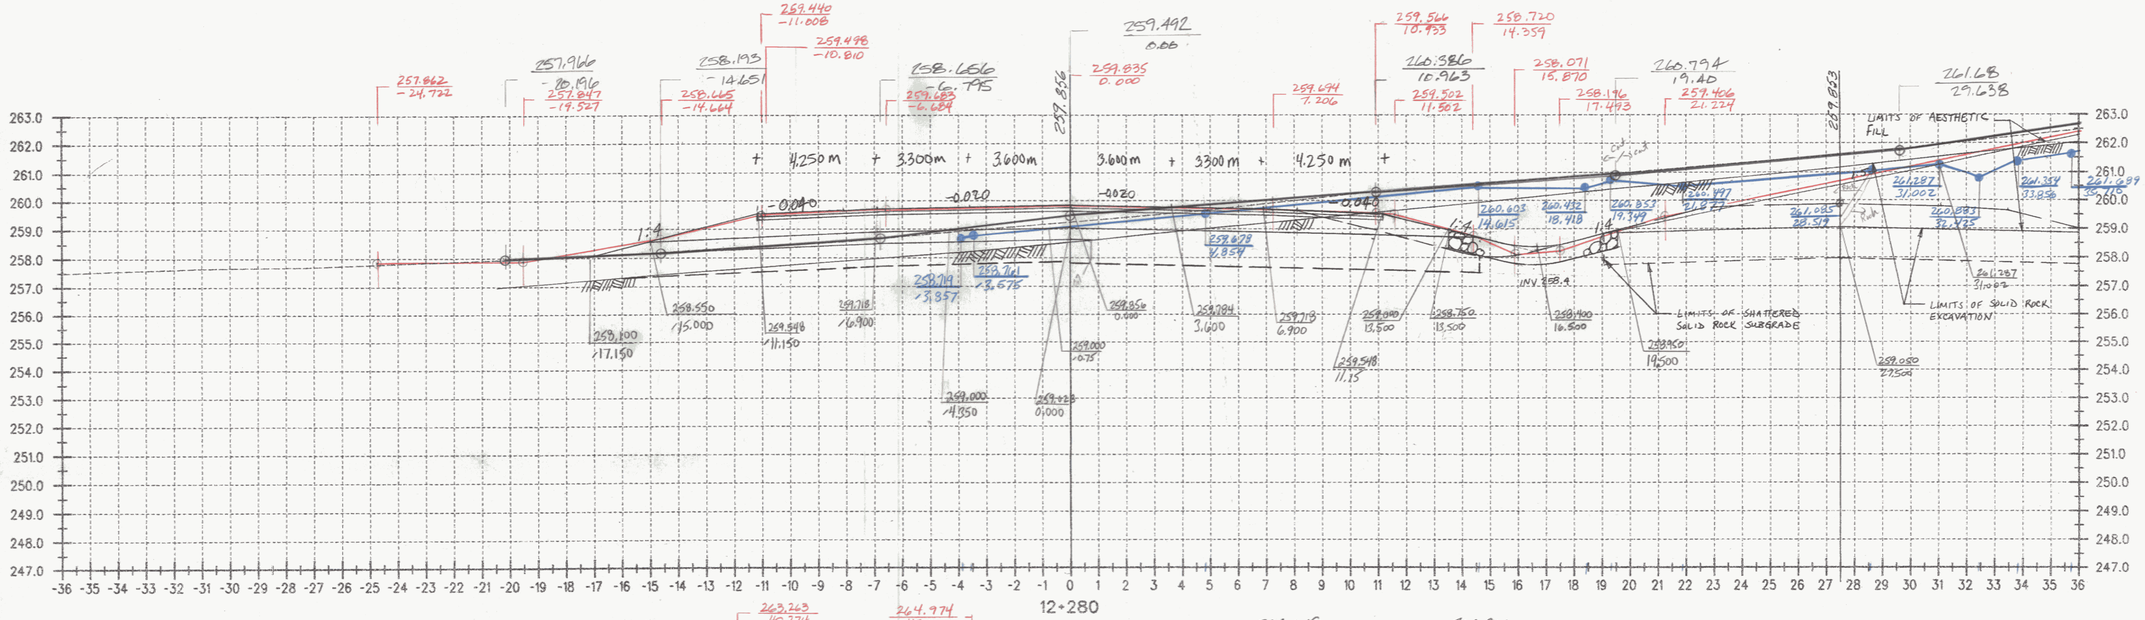

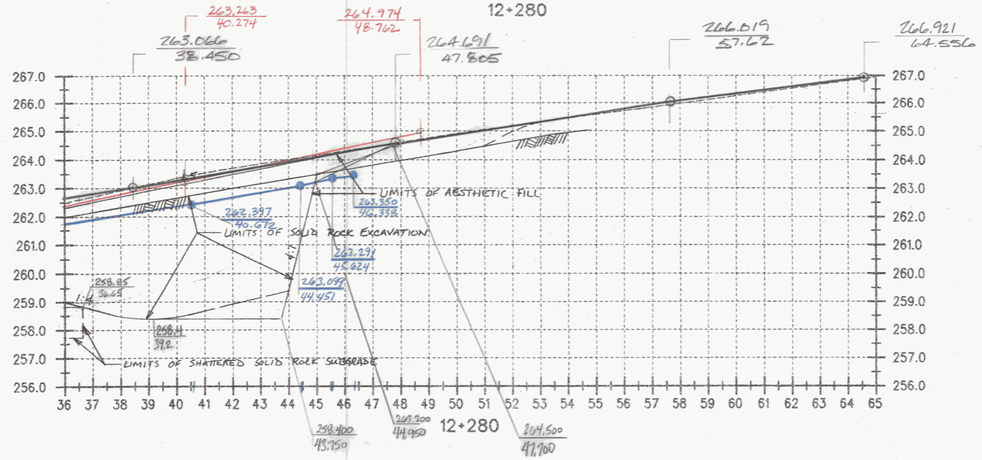

C = ~~127~~ 6.44 + 20.06 = 26.5 m²
F = 9 0 m²
R = 87 38.77 + 50.51 = 89.28 m²
AESTHETIC FILL = 68 65.49 m²

		CHECKED BY
DG	TR	RRM
Deck DH	1/17/03	
FG. RMT 3/9/05	✓ JFW 3/9/05	

DATUM
VERTICAL NAVD 88
HORIZONTAL NAD 83 (1992)

ALL DIMENSIONS IN MILLIMETERS EXCEPT AS INDICATED

2 0 2 m
H 1:100
V 1:100

SURVEYED BY C.H.A. & V.S.E. DATE
DRAWN BY J.S.L. DATE
SQUAD LEADER T.P.K.
DESIGN FILE NO. n/a
IPARM FILE DATE PLOTTED
PROJ. NAME BENNINGTON - HOOSICK D.P.I. 0146(1) C13
PROJ. NO. P.I.N. 1306.60.201
SHEET 313 OF 473 SHEETS