Metric

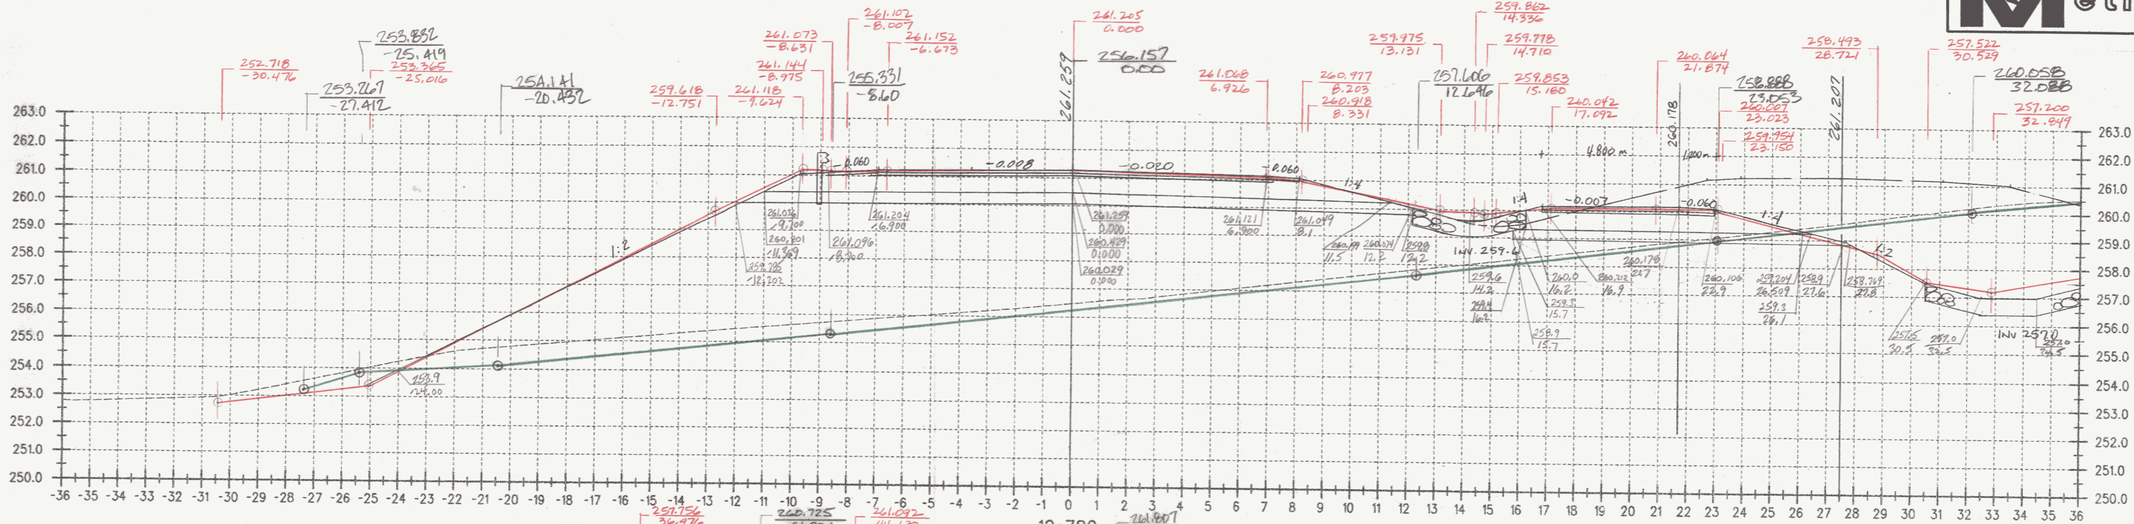

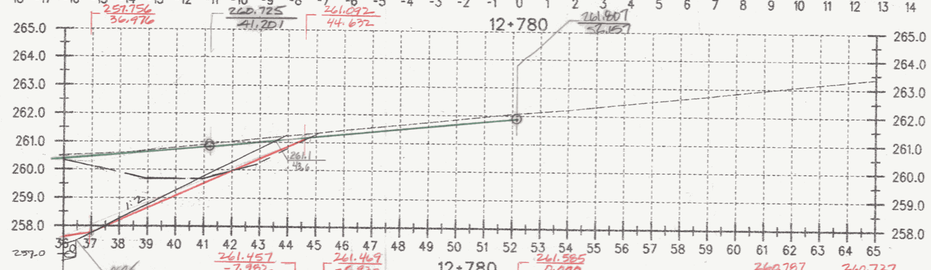

C= ~~36~~ 33.56 m²
F= ~~43~~ 130.01 m²
R= 0

OG TC RMT FG 4/5/05 V RON

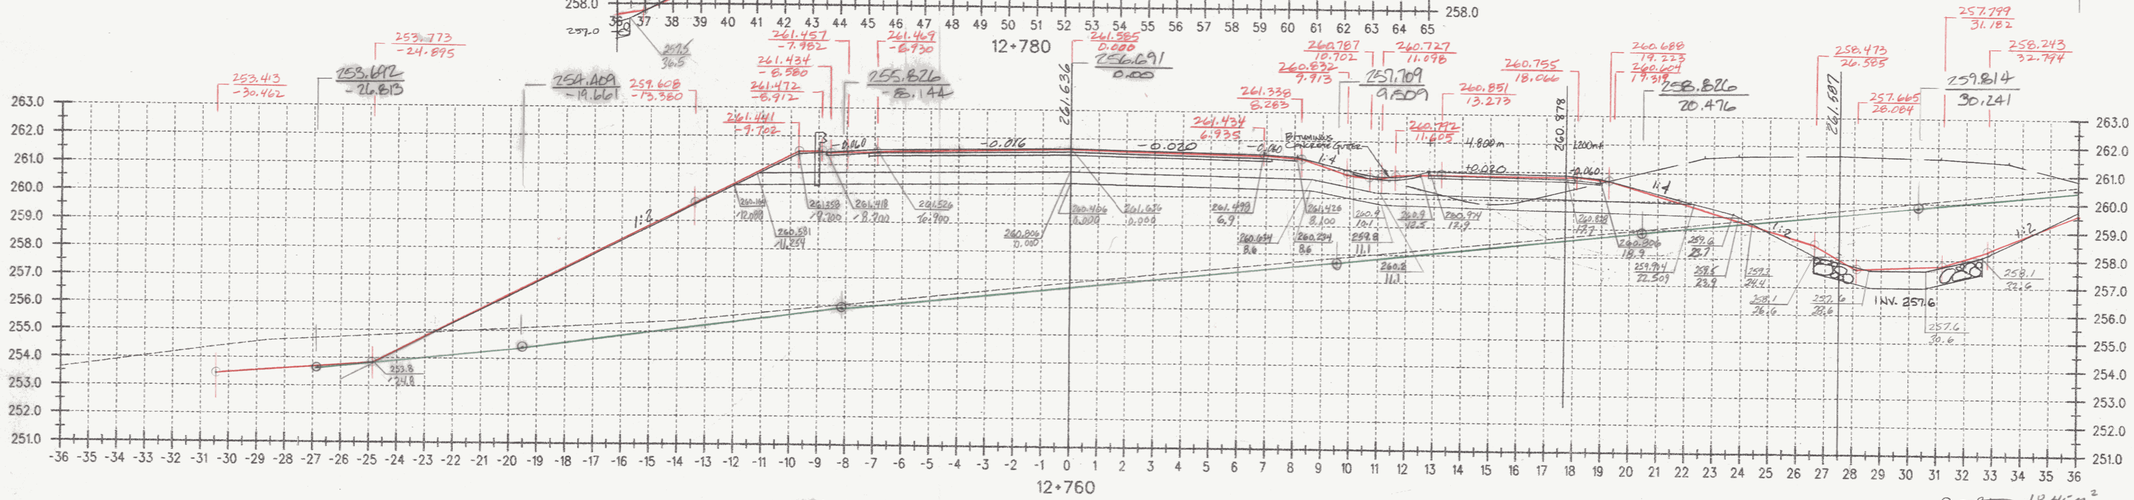

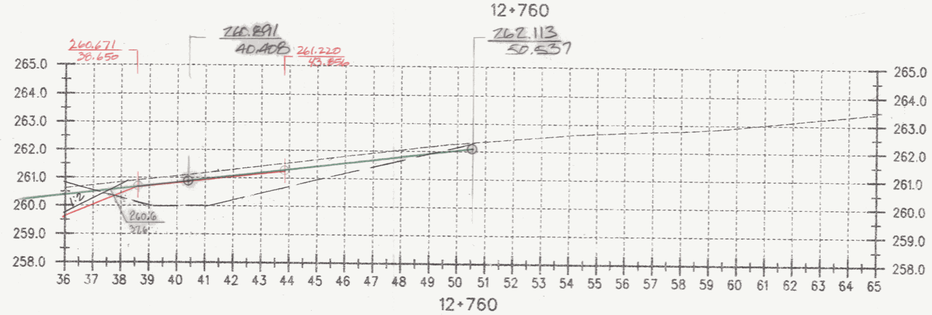

~~C= 27~~ 18.45 m²
~~F= 118~~ 129.40 m²
R= 0

OG TC RMT FG 4/5/05

DATUM
VERTICAL NAVD 88
HORIZONTAL NAD 83 (1992)

ALL DIMENSIONS IN MILLIMETERS EXCEPT AS INDICATED

2 0 2 m
H 1:100
V 1:100

SURVEYED BY C.H.A. & V.S.E. DATE
DRAWN BY J.S.L. DATE
SQUAD LEADER T.P.K.
DESIGN FILE NO. n/a
IPARM FILE DATE PLOTTED
PROJ. NAME BENNINGTON - HOOSICK D.P.I. 0146(1) C/3
PROJ. NO. P.I.N. 1306.60.201
SHEET 327 OF 473 SHEETS