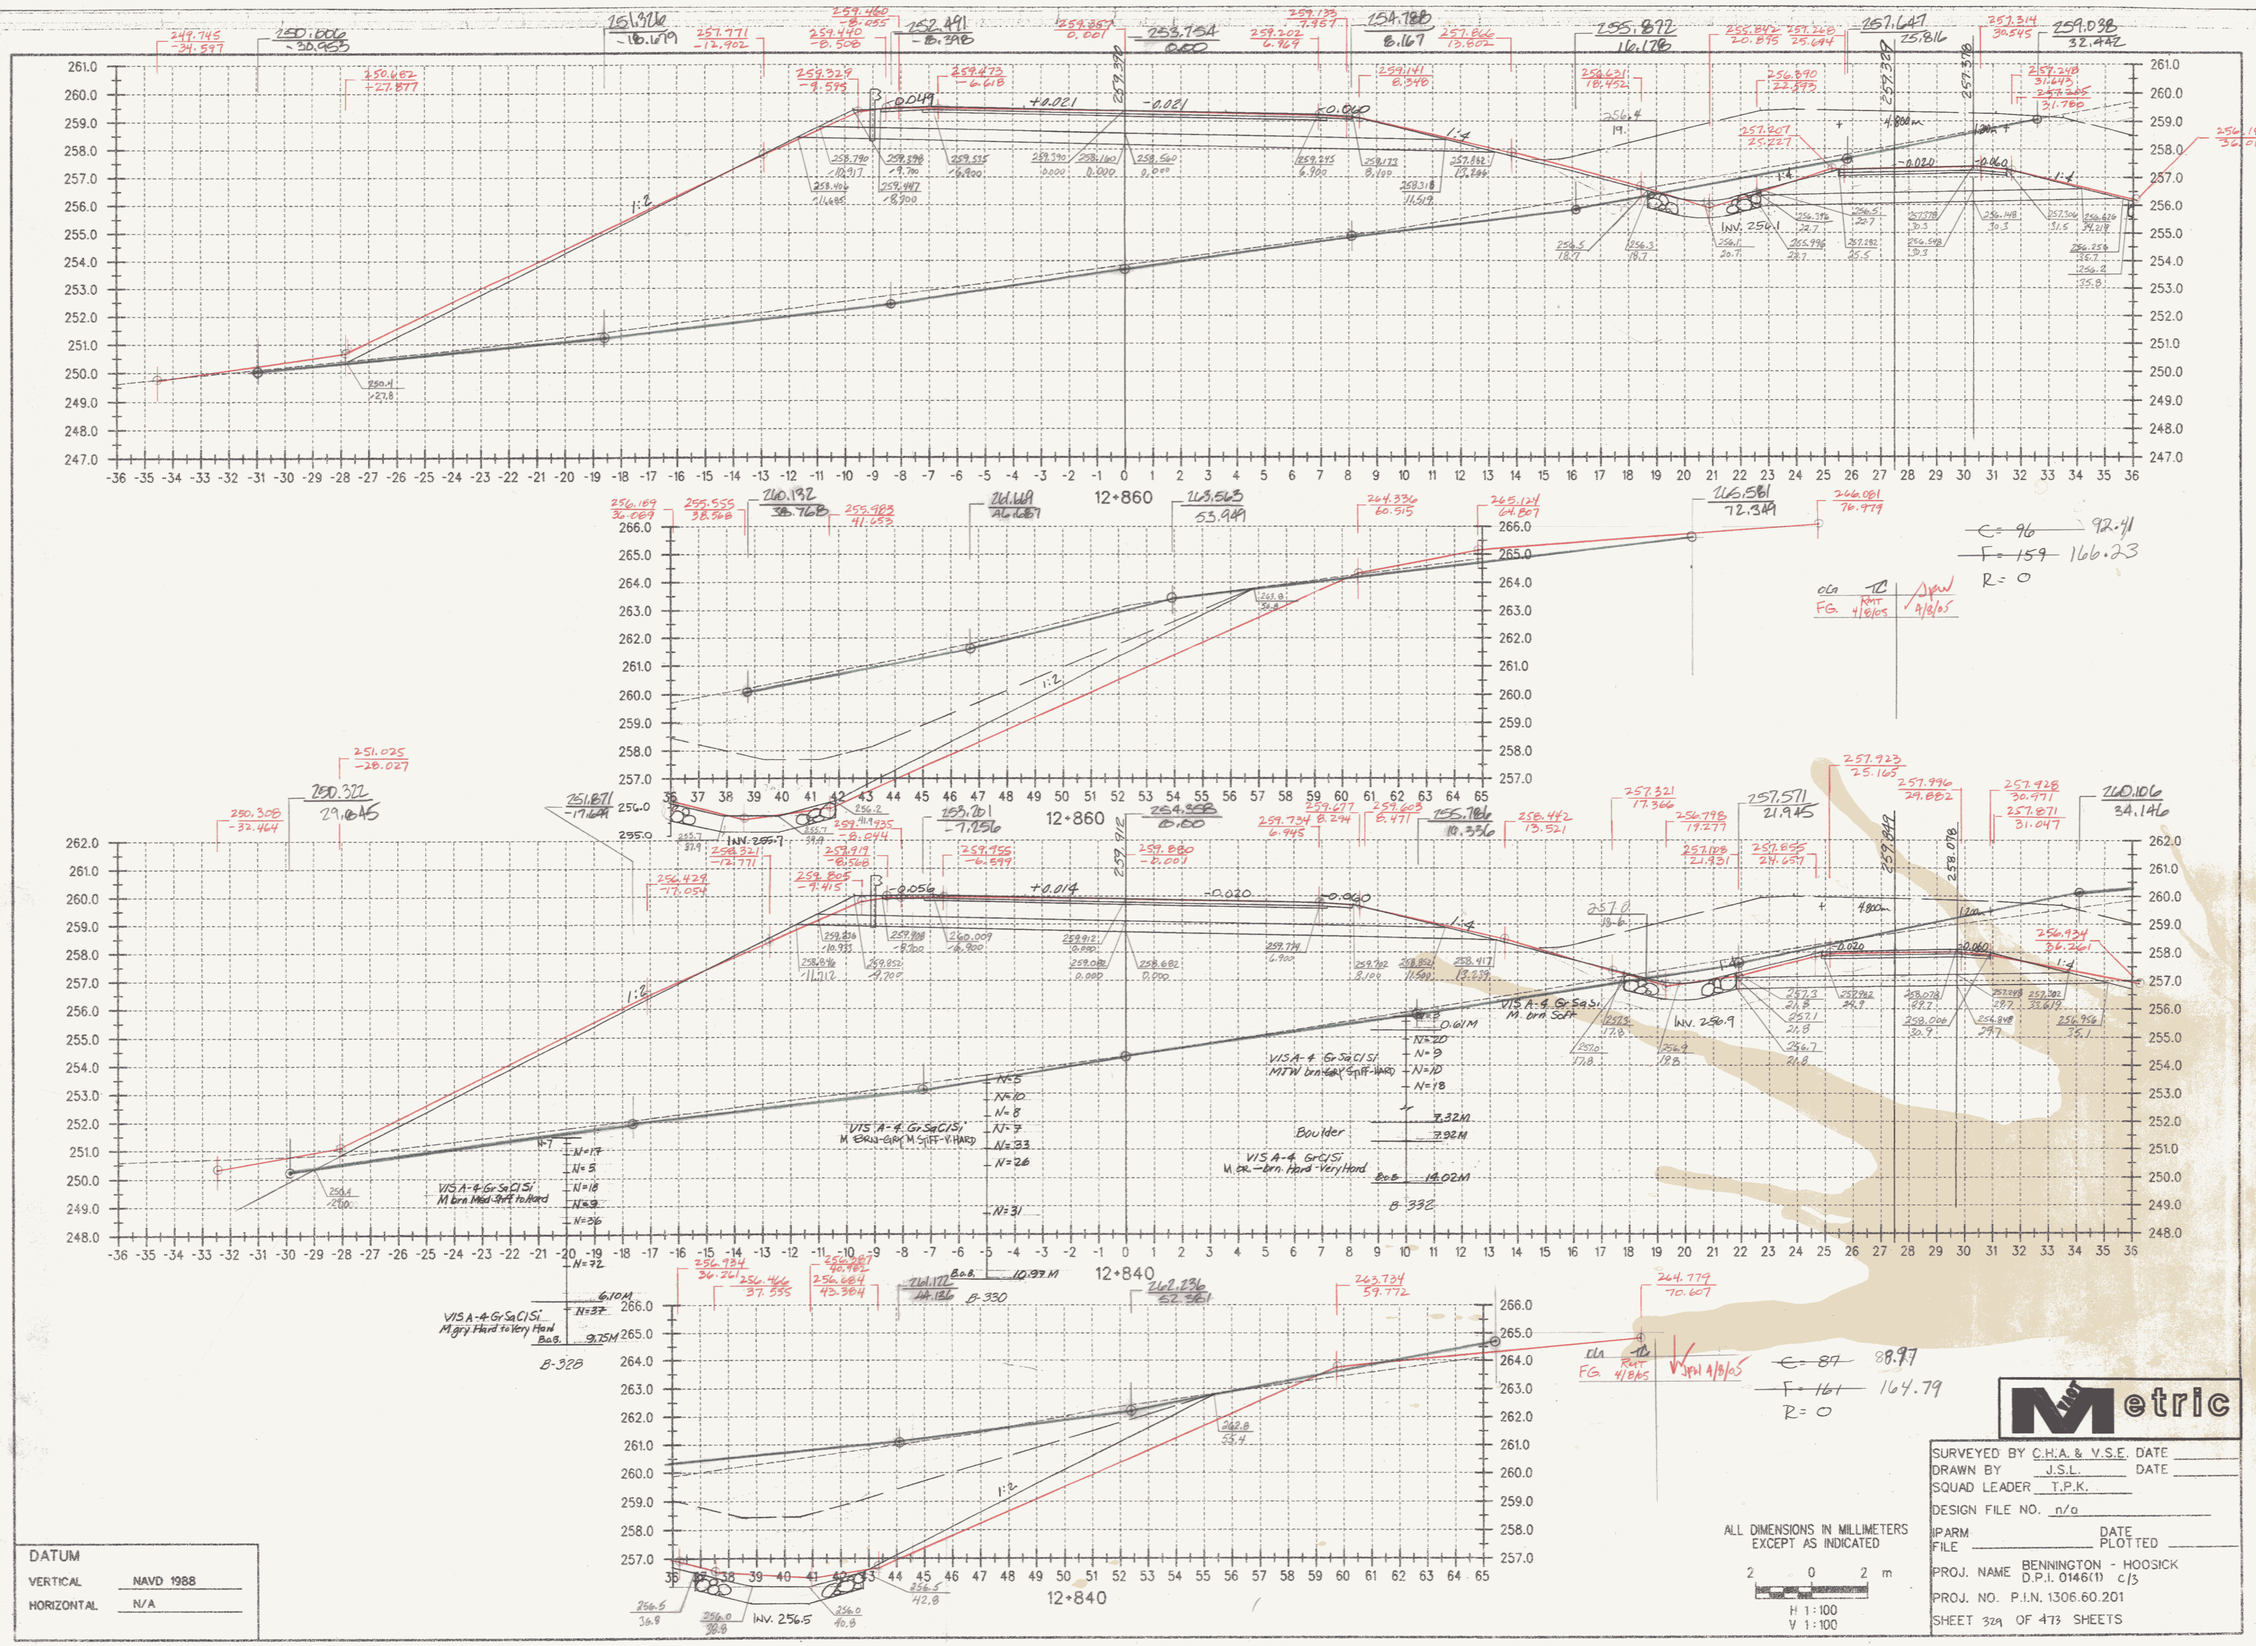

DATUM

VERTICAL	NAVD 1988
HORIZONTAL	N/A

ALL DIMENSIONS IN MILLIMETERS EXCEPT AS INDICATED

2 0 2 m

H 1:100
V 1:100

SURVEYED BY C.H.A. & V.S.E. DATE
DRAWN BY J.S.L. DATE
SQUAD LEADER T.P.K.
DESIGN FILE NO. n/a
IPARM FILE DATE PLOTTED
PROJ. NAME BENNINGTON - HOOSICK D.P.I. 0146(1) c/3
PROJ. NO. P.I.N. 1306.60.201
SHEET 329 OF 473 SHEETS