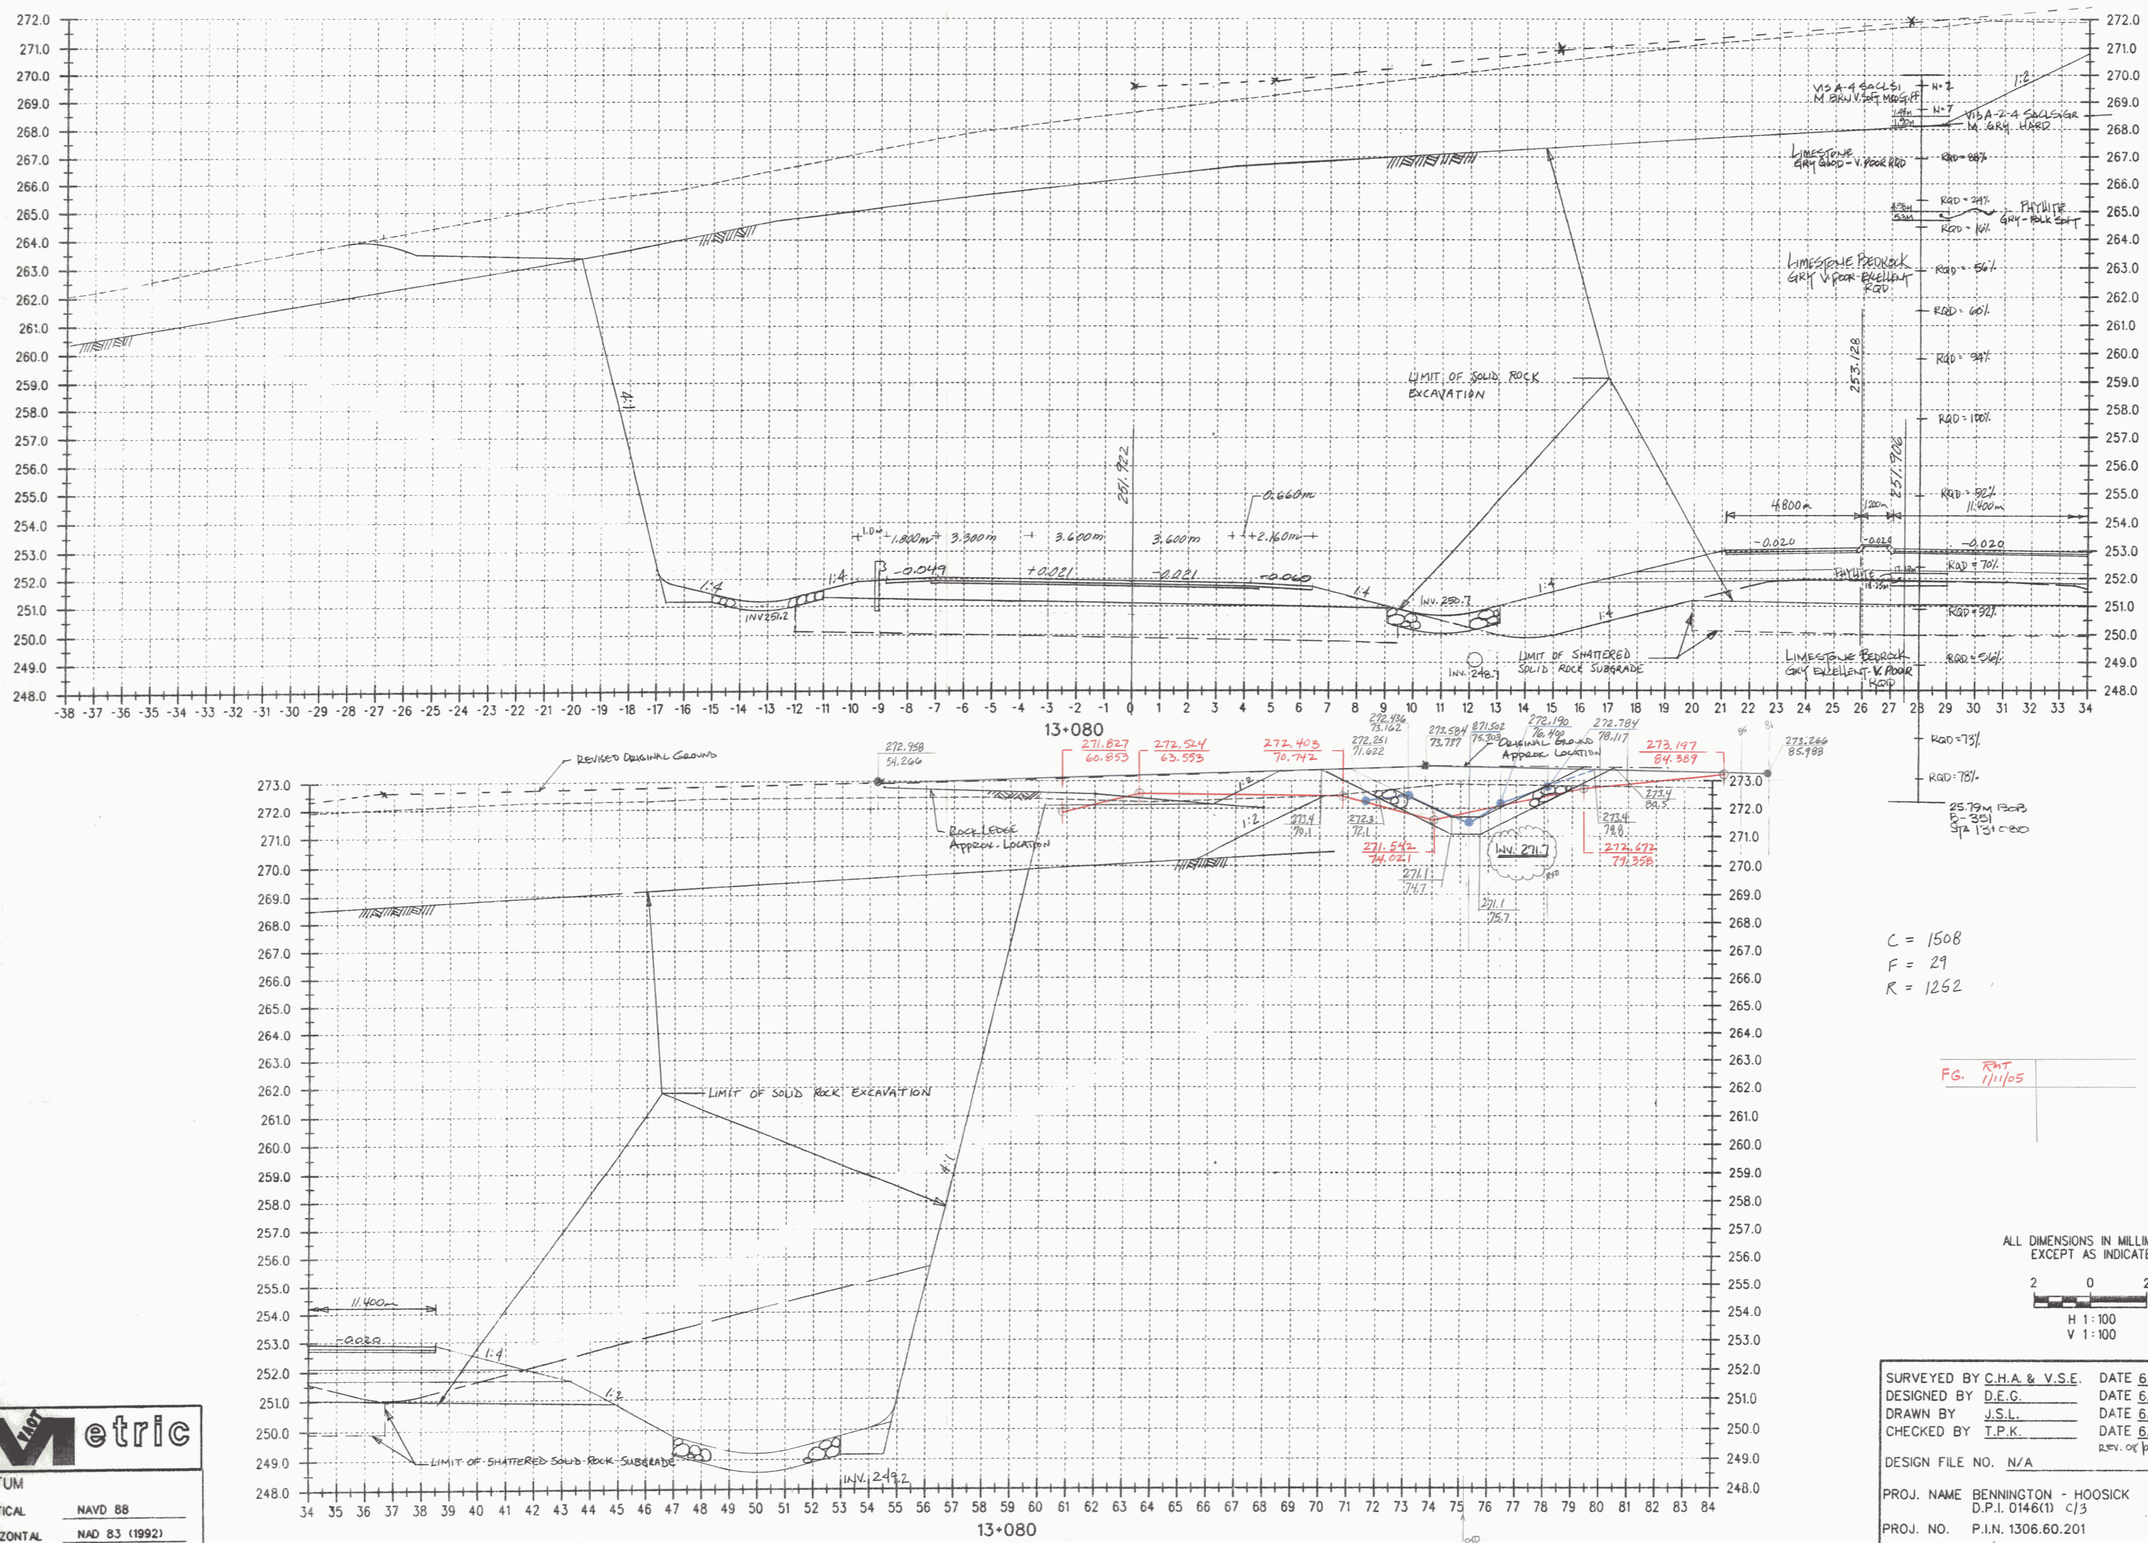
13+080
LIMIT OF SOLID ROCK EXCAVATION
LIMIT OF SHATTERED SOLID ROCK SUBGRADE
LIMESTONE BEDROCK GRY EXCELLENT - V. POOR RQD
PHYLLITE GRY - POOR SOFT
INV. 251.2
INV. 250.7
INV. 249.7
INV. 271.7
INV. 249.2
REVISED ORIGINAL GROUND
ORIGINAL GROUND APPROX. LOCATION
ROCK LEDGE APPROX. LOCATION
C = 1508
F = 29
R = 1252
FG. RMT 1/11/05
ALL DIMENSIONS IN MILLIMETERS EXCEPT AS INDICATED
H 1:100
V 1:100
SURVEYED BY C.H.A. & V.S.E. DATE 6/95
DESIGNED BY D.E.G. DATE 6/95
DRAWN BY J.S.L. DATE 6/95
CHECKED BY T.P.K. DATE 6/95
DESIGN FILE NO. N/A
PROJ. NAME BENNINGTON - HOOSICK D.P.I. 0146(1) C/3
PROJ. NO. P.I.N. 1306.60.201
SHEET 340 OF 473
DWG No. -
Metric
DATUM
VERTICAL NAVD 88
HORIZONTAL NAD 83 (1992)