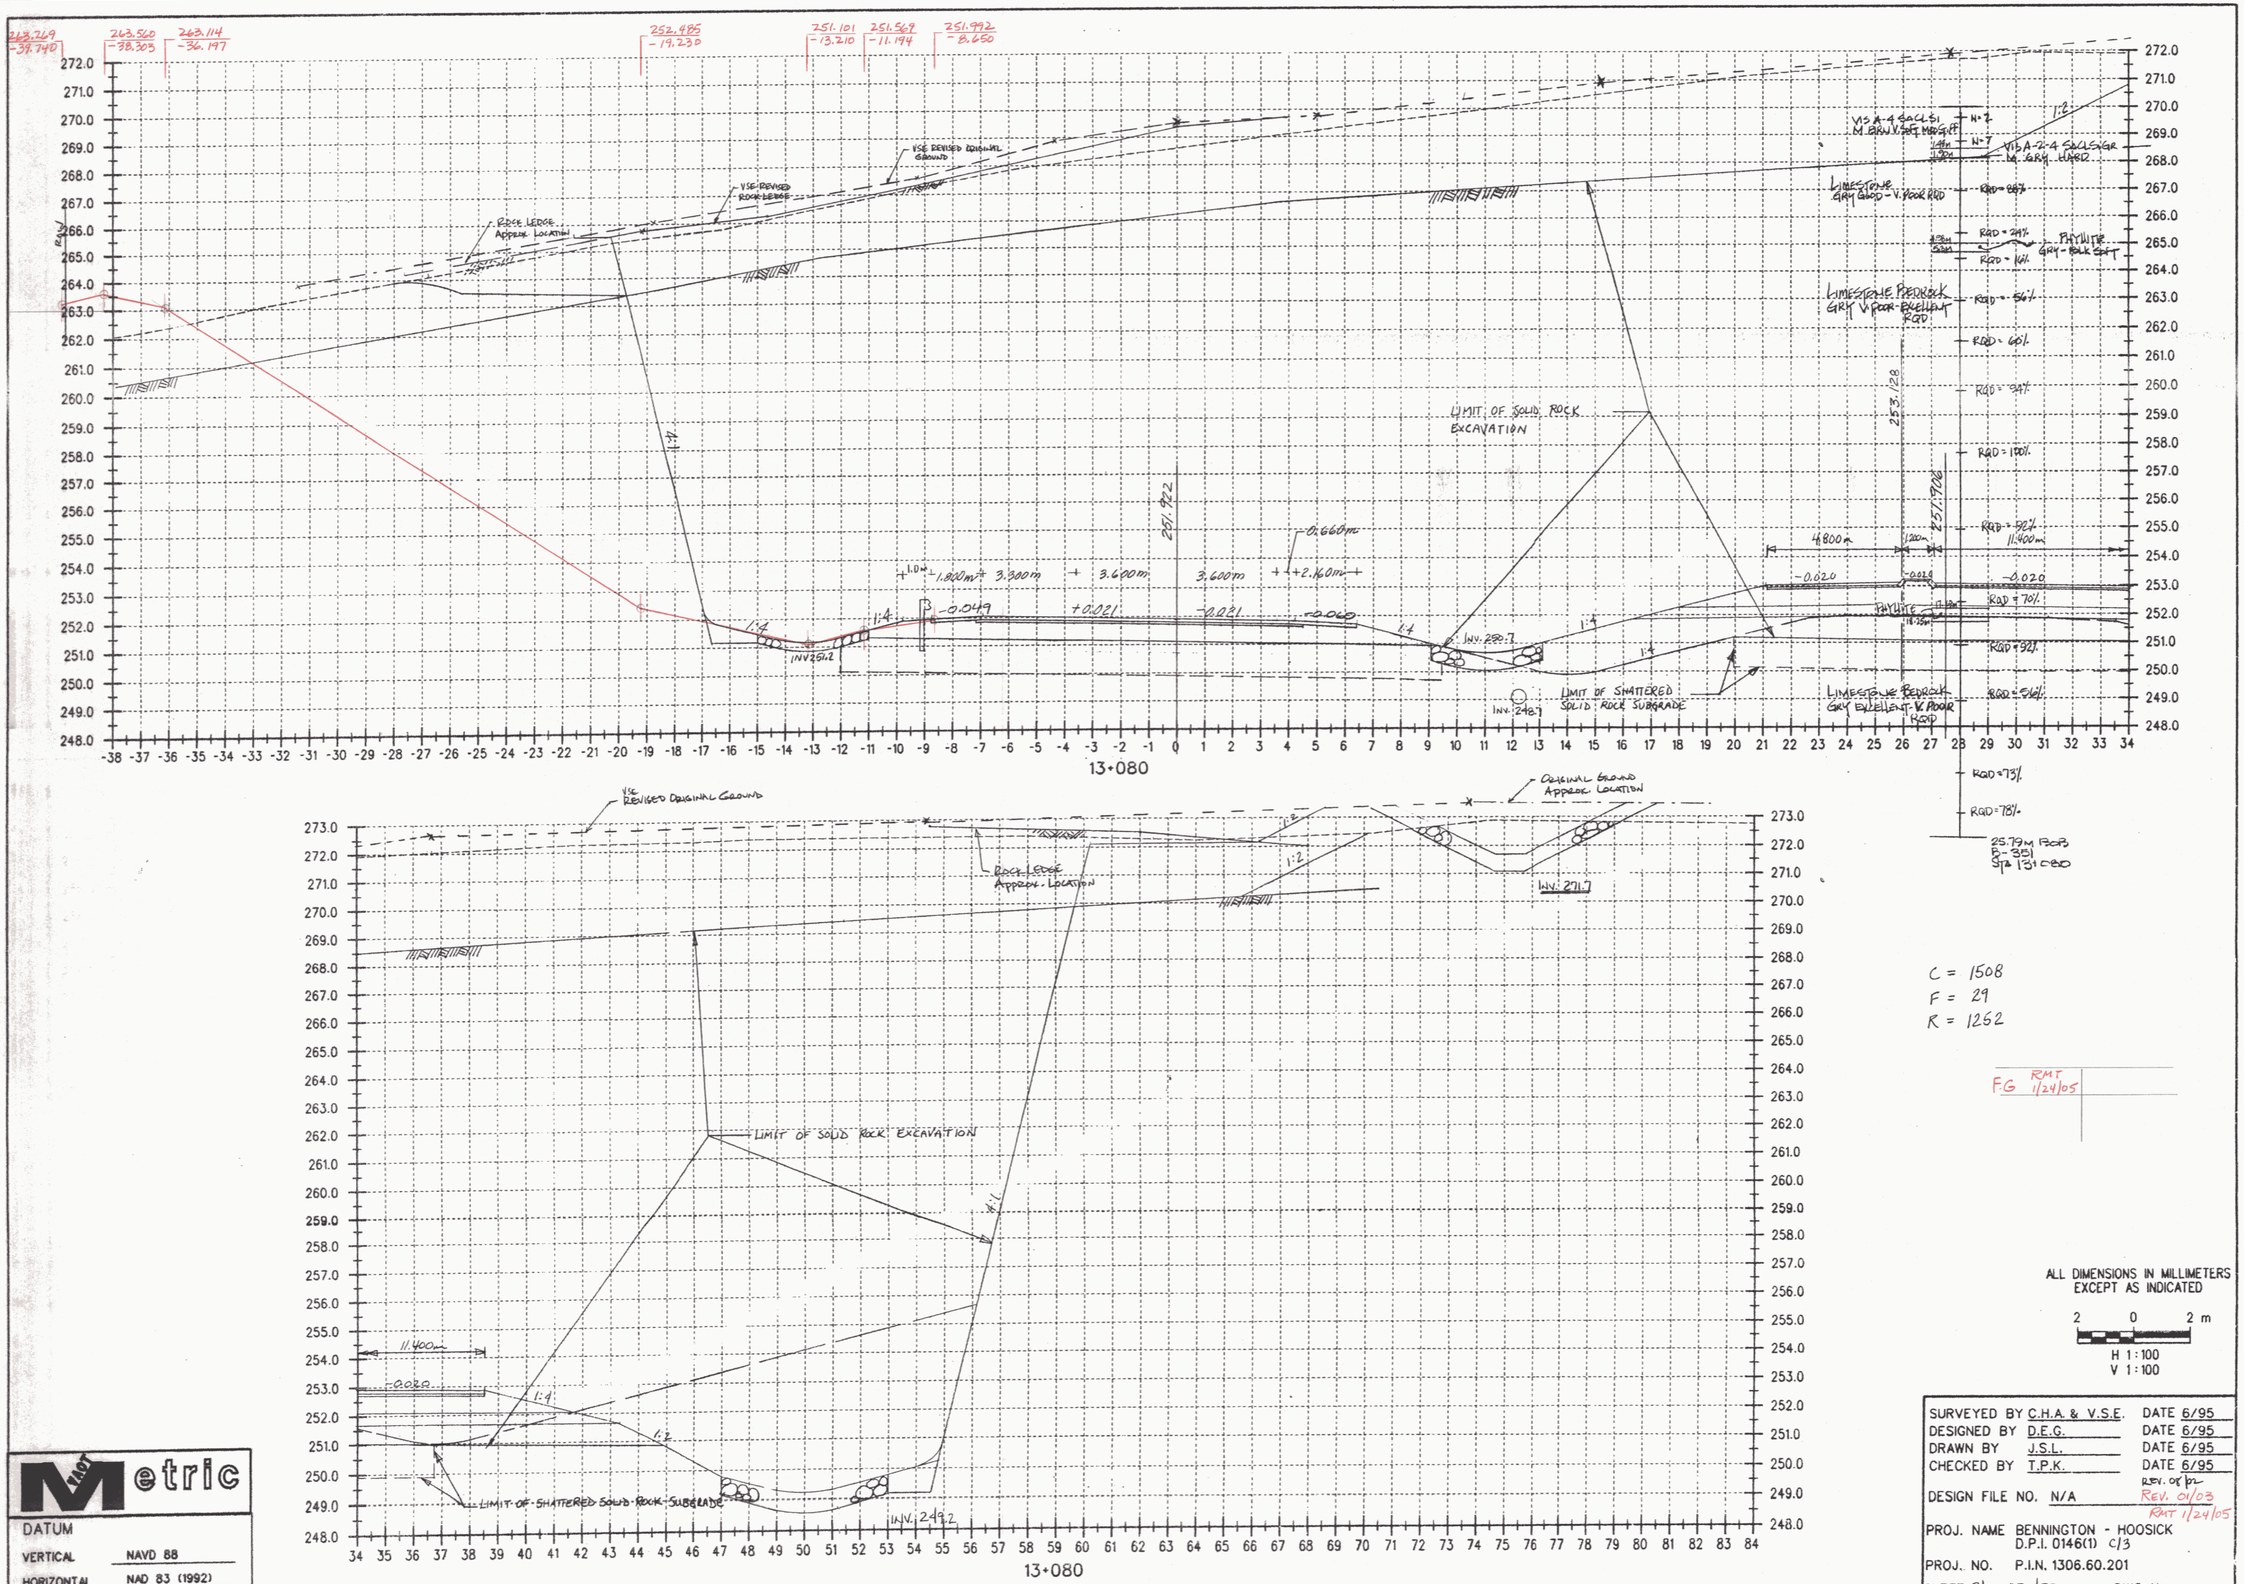
13+080
USE REVISED ORIGINAL GROUND
USE REVISED ROCK LEDGE
ROCK LEDGE APPROX. LOCATION
LIMIT OF SOLID ROCK EXCAVATION
LIMIT OF SHATTERED SOLID ROCK SUBGRADE
ORIGINAL GROUND APPROX. LOCATION
LIMESTONE GRY GRAY - V. POOR RQD
PHYLLITE GRY - ROCK SOFT
LIMESTONE BEDROCK GRY V. POOR - EXCELLENT RQD
LIMESTONE BEDROCK GRY EXCELLENT - V. POOR RQD
INV. 251.2
INV. 250.7
INV. 249.7
INV. 271.7
INV. 249.2
11.400m
4.800m
-0.020
C = 1508
F = 29
R = 1252
F.G RMT 1/24/05
ALL DIMENSIONS IN MILLIMETERS EXCEPT AS INDICATED
2 0 2 m
H 1:100
V 1:100
SURVEYED BY C.H.A. & V.S.E. DATE 6/95
DESIGNED BY D.E.G. DATE 6/95
DRAWN BY J.S.L. DATE 6/95
CHECKED BY T.P.K. DATE 6/95
REV. OF PL
DESIGN FILE NO. N/A REV. 01/03
RMT 1/24/05
PROJ. NAME BENNINGTON - HOOSICK D.P.I. 0146(1) C/3
PROJ. NO. P.I.N. 1306.60.201
SHEET 340 OF 473 DWG No. -
Metric
DATUM
VERTICAL NAVD 88
HORIZONTAL NAD 83 (1992)