Metric

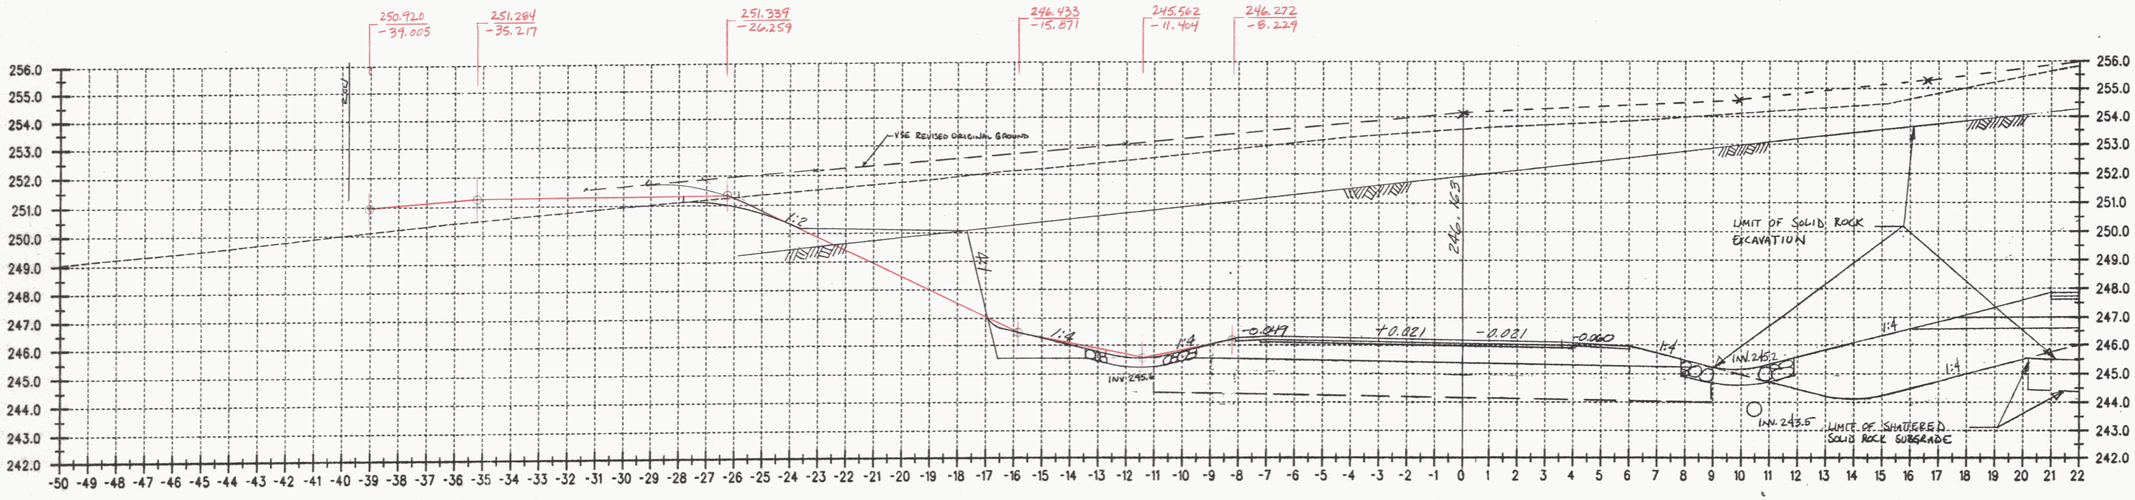

13+240

FG. RMT 1/24/05

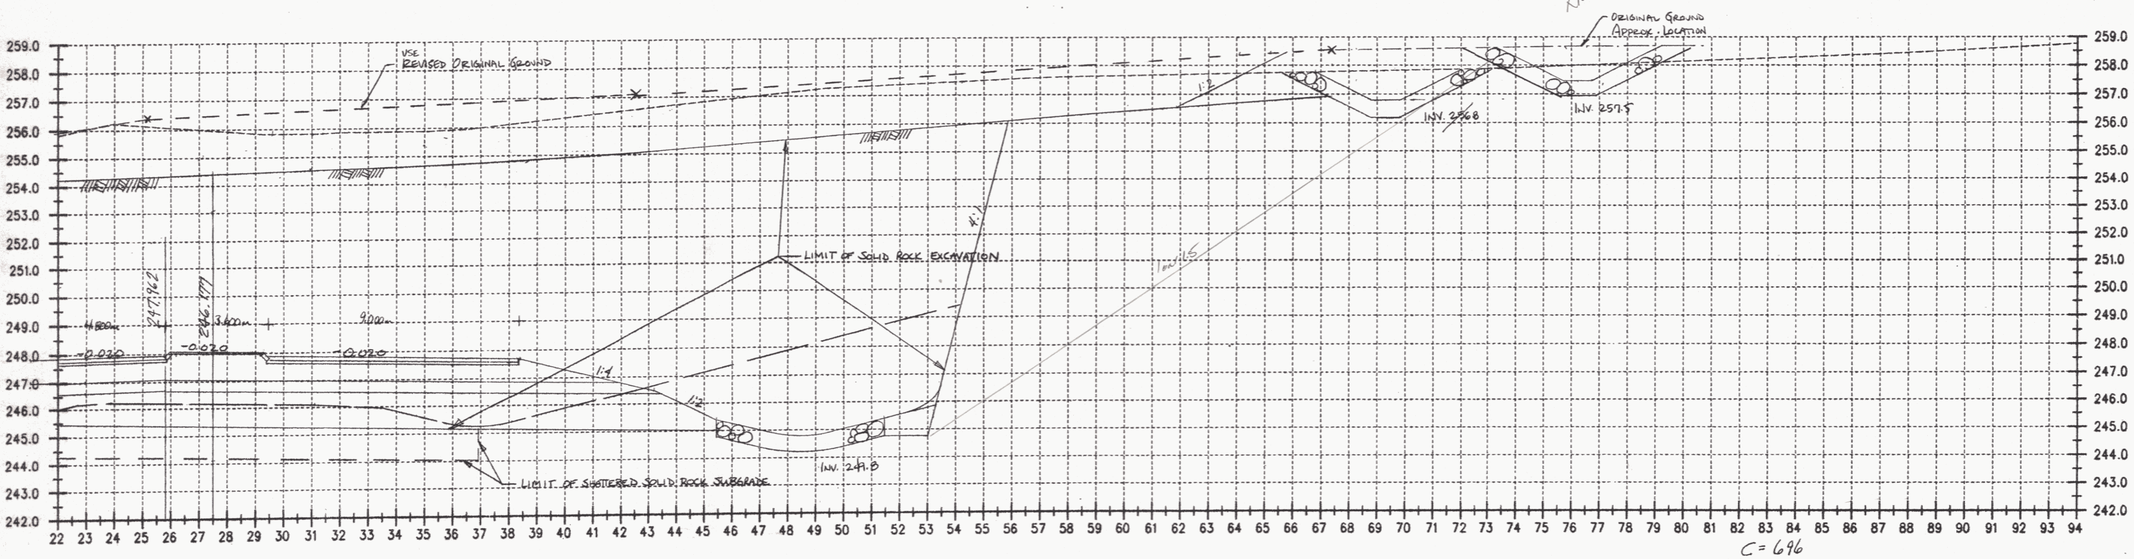

13+240

C = 696
F = 42
R = 567

ALL DIMENSIONS IN MILLIMETERS EXCEPT AS INDICATED

2 0 2 m

H 1:100
V 1:100

SURVEYED BY C.H.A. & V.S.E.	DATE
DRAWN BY J.S.L.	DATE
SQUAD LEADER T.P.K.	REV. 08/02
DESIGN FILE NO. N/A	
IPARM FILE	DATE PLOTTED
PROJ. NAME BENNINGTON - HOOSICK D.P.I. 0146(1) C/3	REV. 01/03
PROJ. NO. P.I.N. 1306.60.201	RMT 1/24/05
SHEET 34B OF 43 SHEETS	

DATUM

VERTICAL	NAVD 1988
HORIZONTAL	N/A