Metric

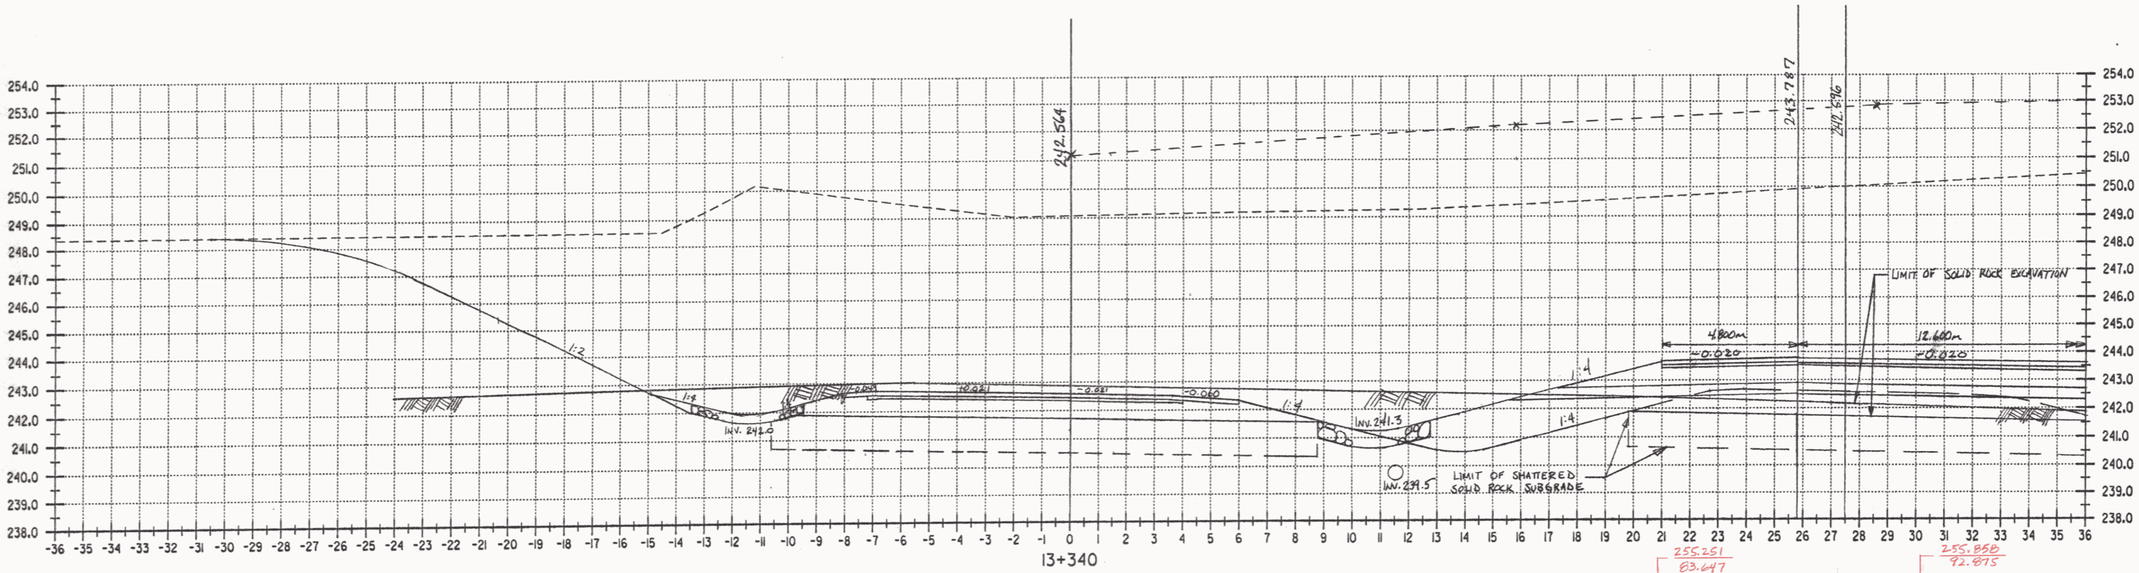

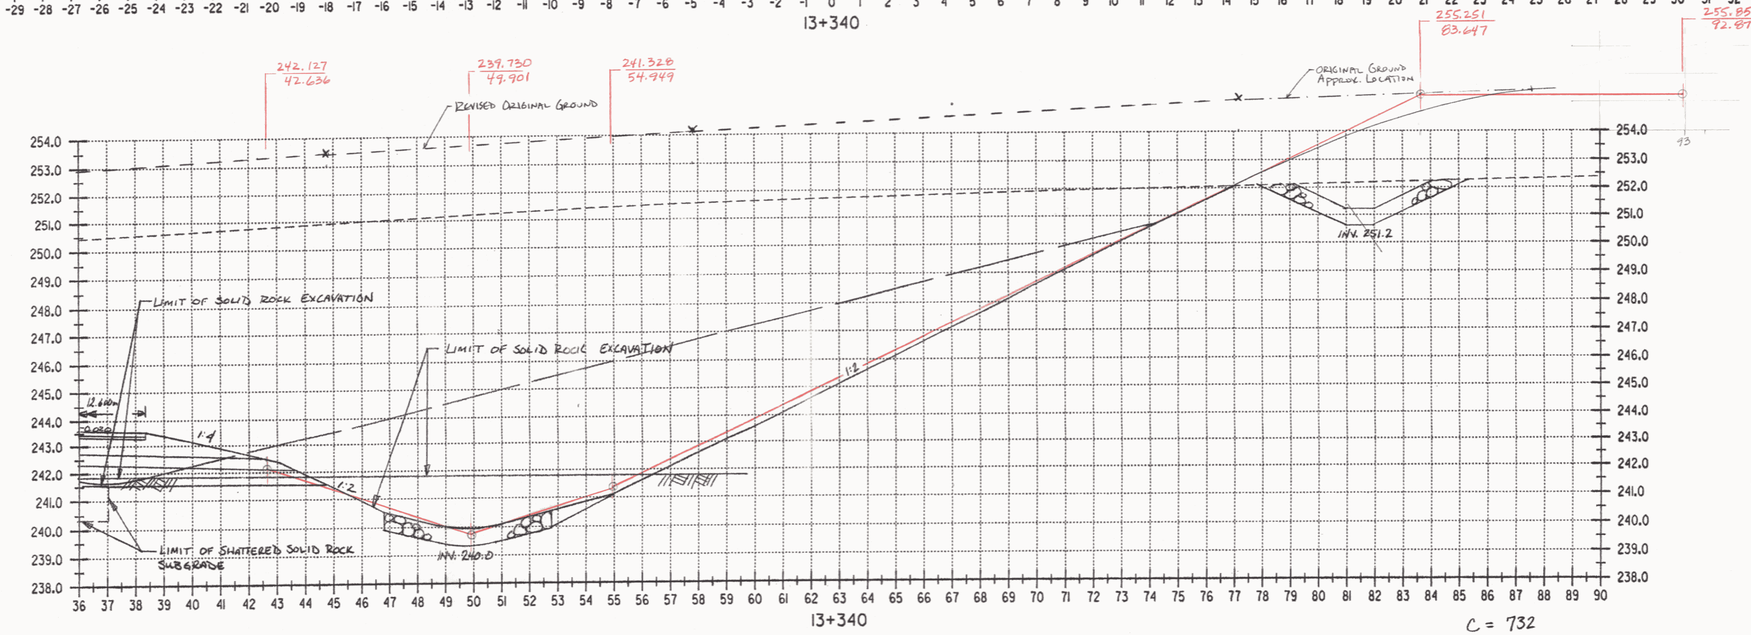

FG. RMT 1/26/05

C = 732
F = 23
R = 61

ALL DIMENSIONS IN MILLIMETERS EXCEPT AS INDICATED

2 0 2 m

H 1:100
V 1:100

SURVEYED BY	C.H.A. & V.S.E. DATE 12/93
DRAWN BY	J.S.L. DATE 7/01
SQUAD LEADER	T.P.K. REV. 08/02
DESIGN FILE NO.	/5116/VAOT/VTSECT4.D
IPARM FILE	DATE PLOTTED
PROJ. NAME	BENNINGTON - HOOSICK D.P.I. 0146(1) C/3
PROJ. NO.	P.I.N. 1306.60
SHEET	353 OF 473 SHEETS

DATUM	
VERTICAL	NAVD 88
HORIZONTAL	NAD 83 (1992)

R3D