Metric

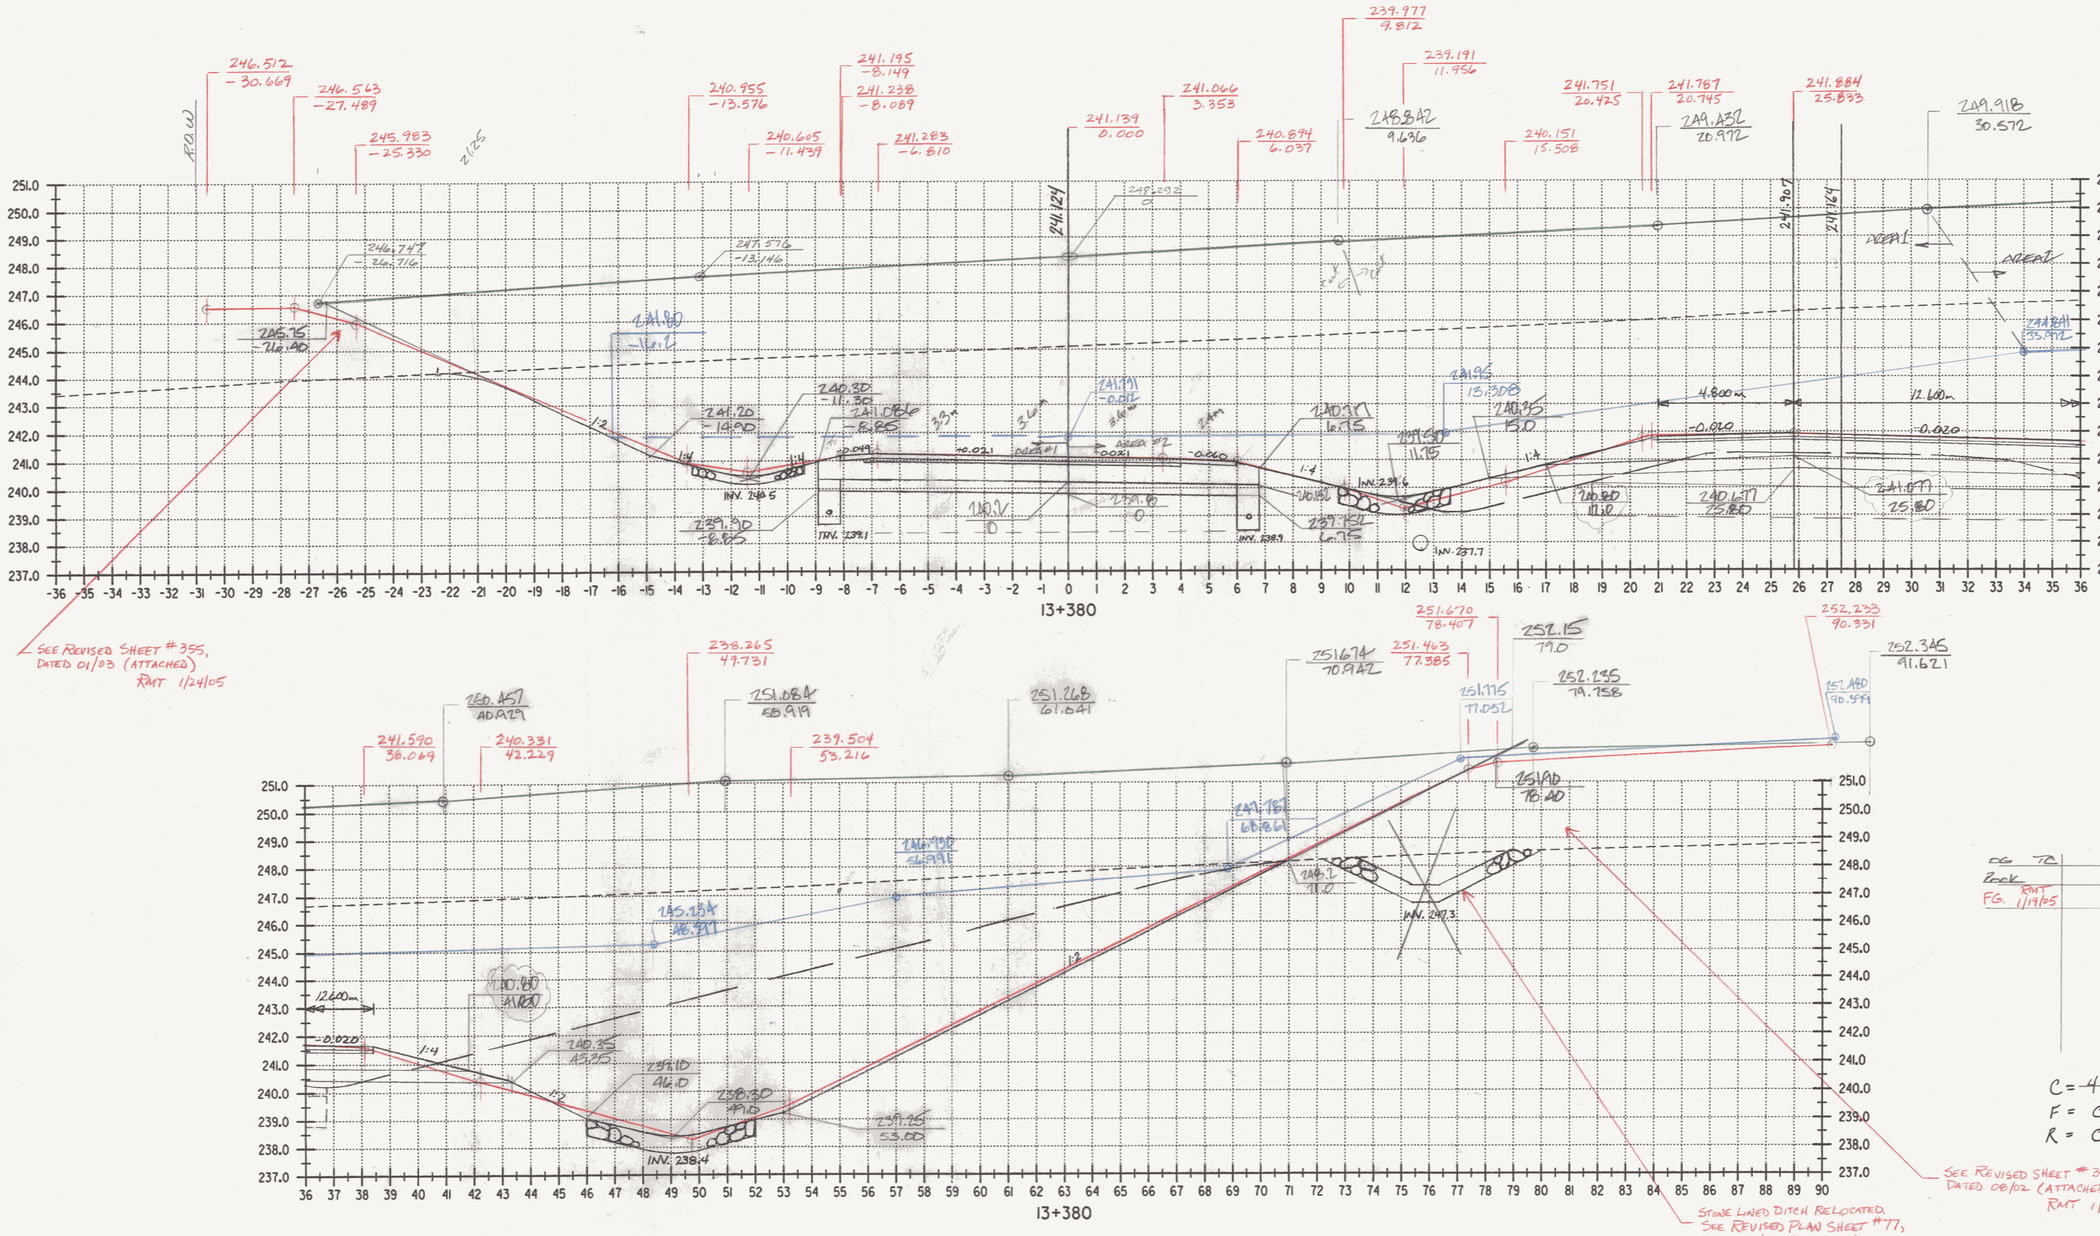

C = ~~474~~
F = 0 $0m^2$
R = 0 261.13 SM

DATUM	
VERTICAL	NAVD 88
HORIZONTAL	NAD 83 (1992)

ALL DIMENSIONS IN MILLIMETERS EXCEPT AS INDICATED

2 0 2 m

H 1:100
V 1:100

SURVEYED BY C.H.A. & V.S.E.	DATE 12/93
DRAWN BY J.S.L.	DATE 7/01
SQUAD LEADER T.P.K.	
DESIGN FILE NO. /5116/VAOT/VTSECT4.D	
IPARM FILE	DATE PLOTTED
PROJ. NAME BENNINGTON - HOOSICK D.P.I. 0146(1) C/3	
PROJ. NO. P.I.N. 1306.60	
SHEET 355 OF 473 SHEETS	