VAOT Metric

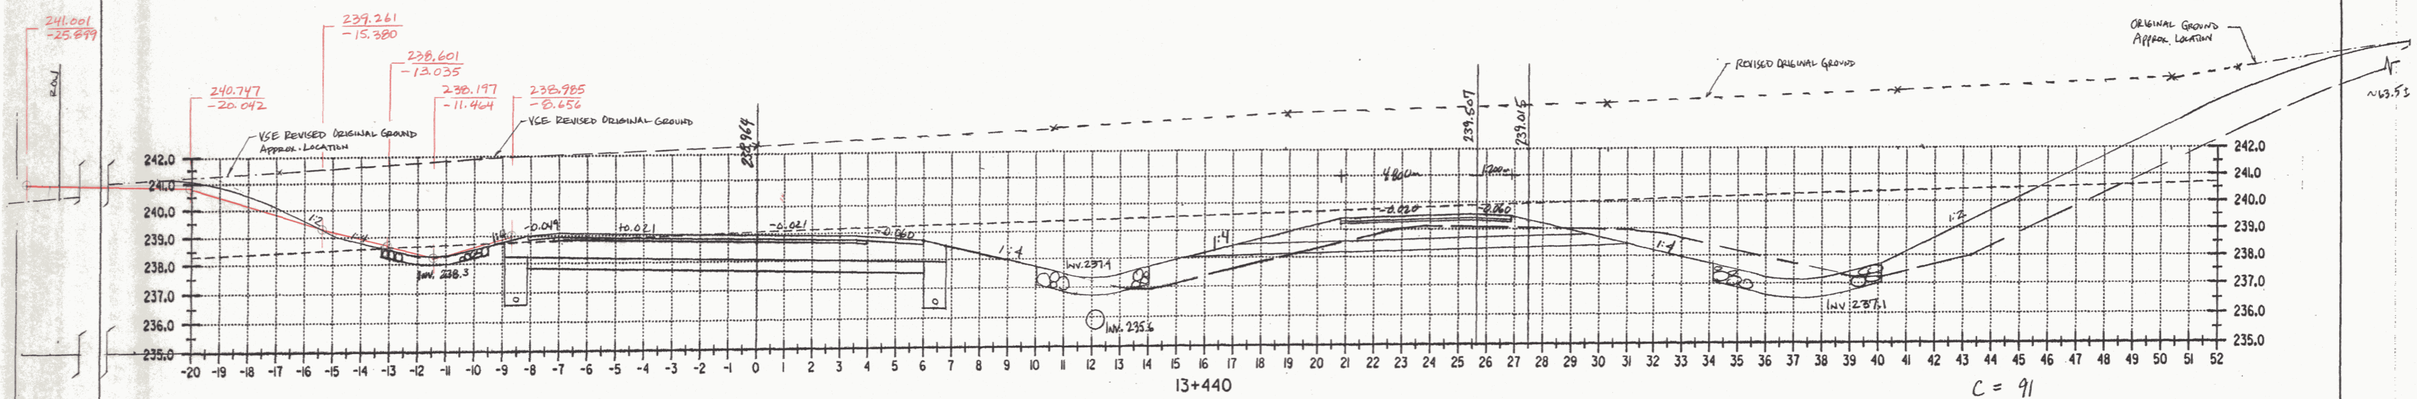


C = 91
F = 0
R = 0

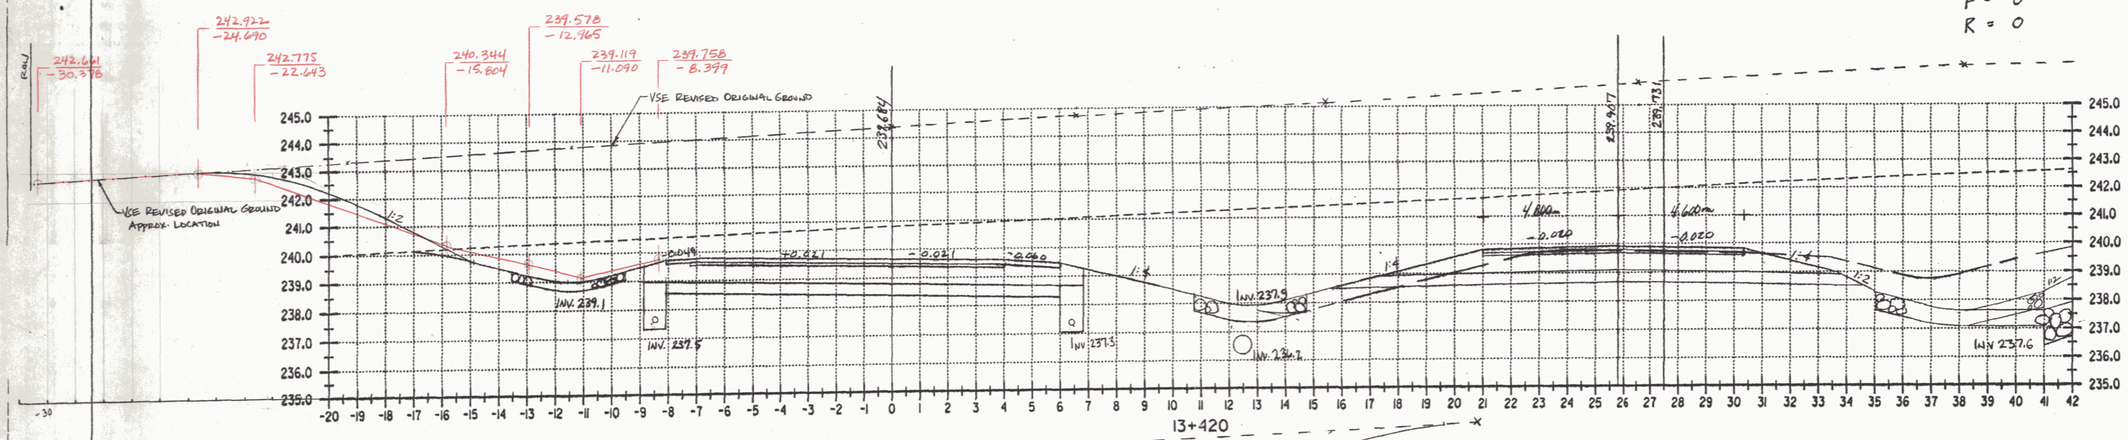


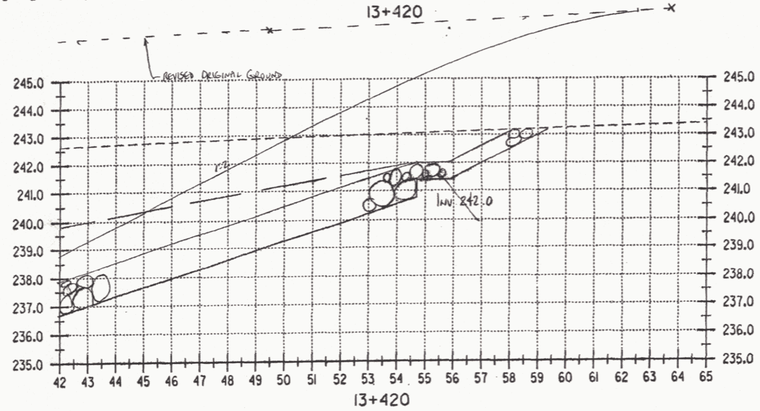


FG. RMT 1/21/05

C = 203
F = 0
R = 0

ALL DIMENSIONS IN MILLIMETERS
EXCEPT AS INDICATED

2 0 2 m

H 1:100
V 1:100

| | |
|---|---|
| SURVEYED BY | C.H.A. & V.S.E. DATE 12/93 |
| DRAWN BY | J.S.L. DATE 7/01 |
| SQUAD LEADER | T.P.K. Rev. 08/02 |
| DESIGN FILE NO. | /5116/VAOT/VTSECT4.D |
| IPARM FILE | DATE PLOTTED |
| PROJ. NAME | BENNINGTON - HOOSICK D.P.I. 0146(1) C/3 REV. 01/03 RMT 1/21/05 |
| PROJ. NO. P.I.N. 1306.60 | |
| SHEET 357 OF 473 SHEETS | |

DATUM

| | |
|---|---|
| VERTICAL | NAVD 88 |
| HORIZONTAL | NAD 83 (1992) |