Metric

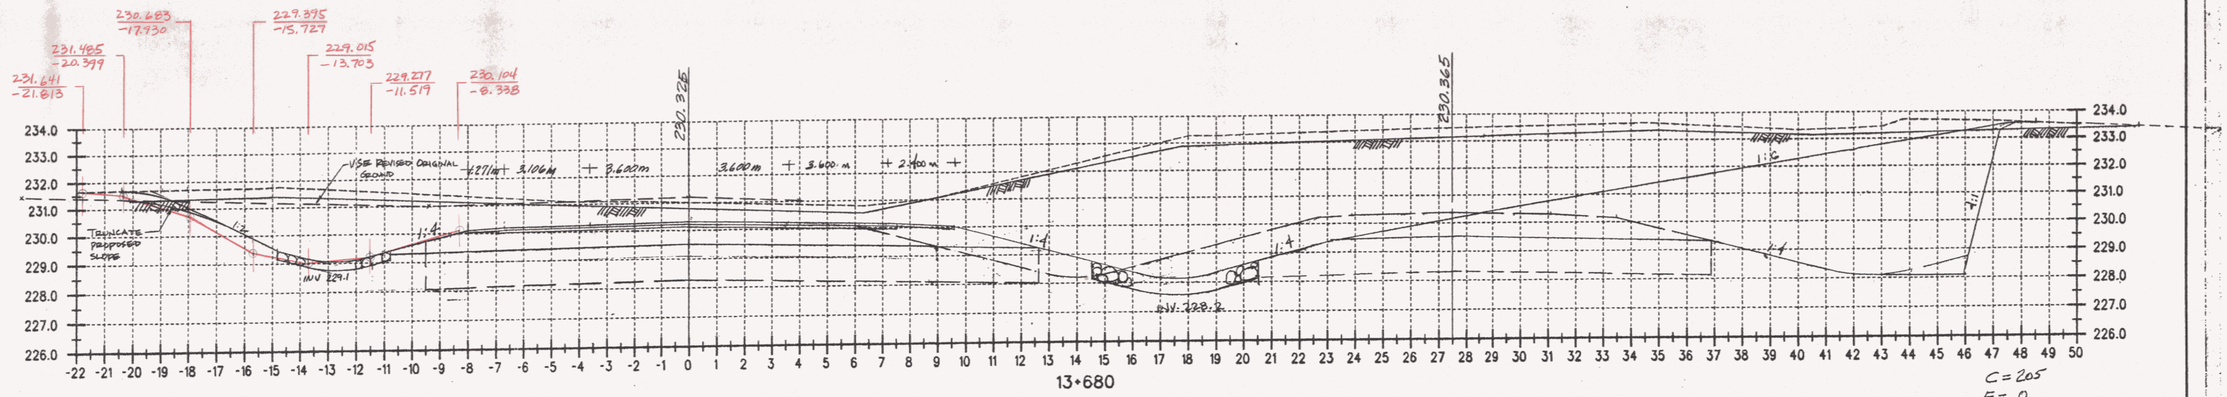

C = 205
F = 0
R = 187
AESTHETIC FILL = 56

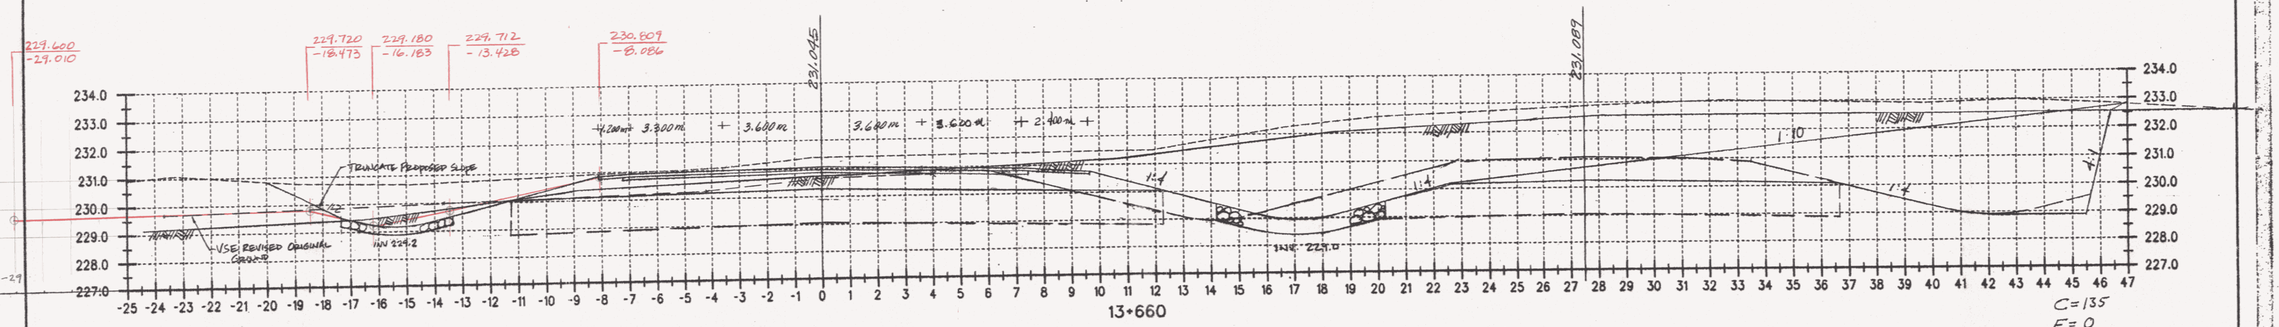

C = 135
F = 0
R = 102
AESTHETIC FILL = 38

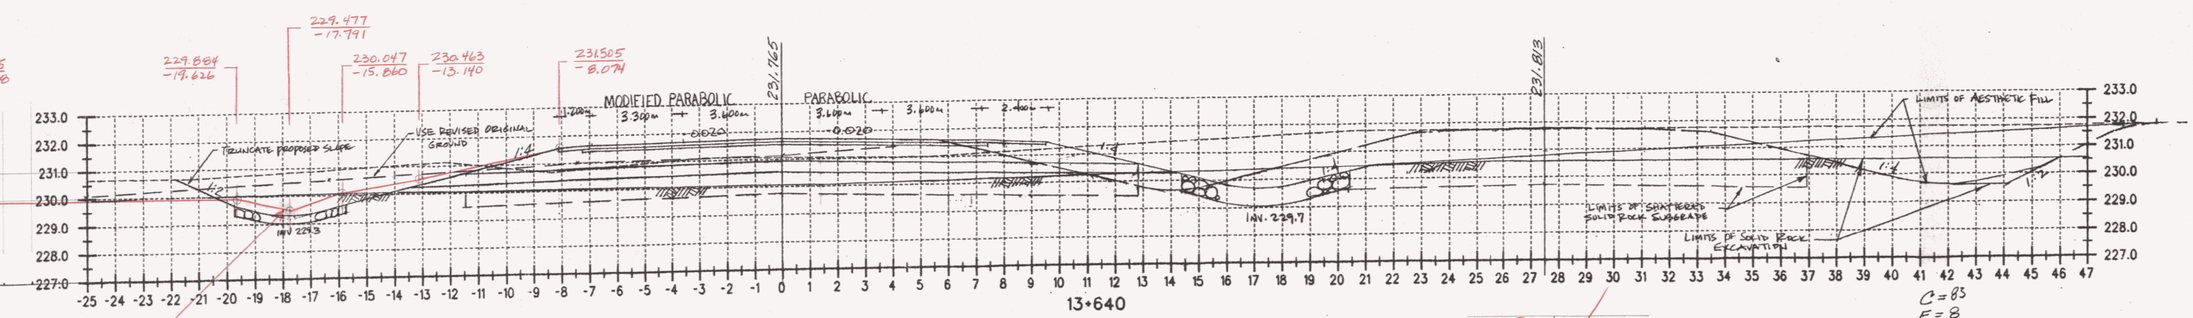

END REVISED DITCH LOCATION PER REVISED PLAN SHEET # 78, DATED 01/03 (ATTACHED)
RMT 1/27/05

FG. RMT 1/31/05

C = 83
F = 8
R = 12
AESTHETIC FILL = 19

SURVEYED BY C.H.A. & V.S.E.	DATE
DRAWN BY J.S.L.	DATE
SQUAD LEADER T.P.K.	
DESIGN FILE NO. N/A	
IPARM FILE	DATE PLOTTED
PROJ. NAME BENNINGTON - HOOSICK D.P.I. 0148(1) C/3	
PROJ. NO. P.I.N. 1306.60.201	REV. 01/03 RMT 1/27/05
SHEET 361 OF 473 SHEETS	

ALL DIMENSIONS IN MILLIMETERS EXCEPT AS INDICATED

2 0 2 m
H 1:100
V 1:100

DATUM	
VERTICAL	NAVD 88
HORIZONTAL	NAD 83 (1992)