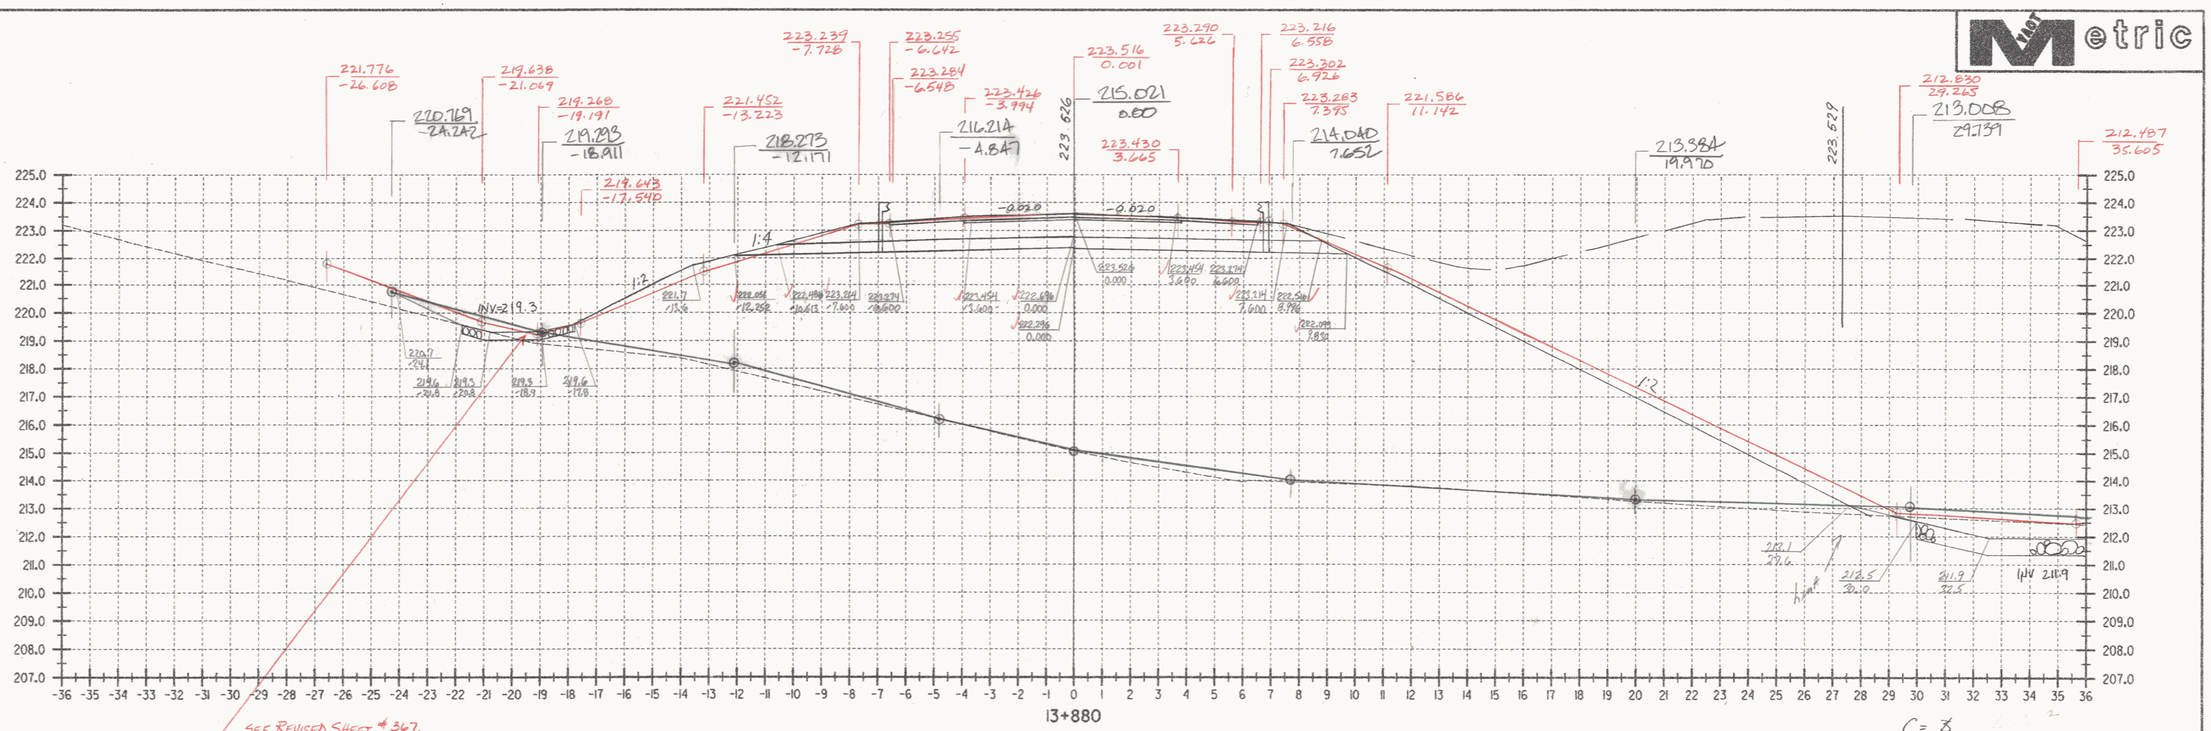

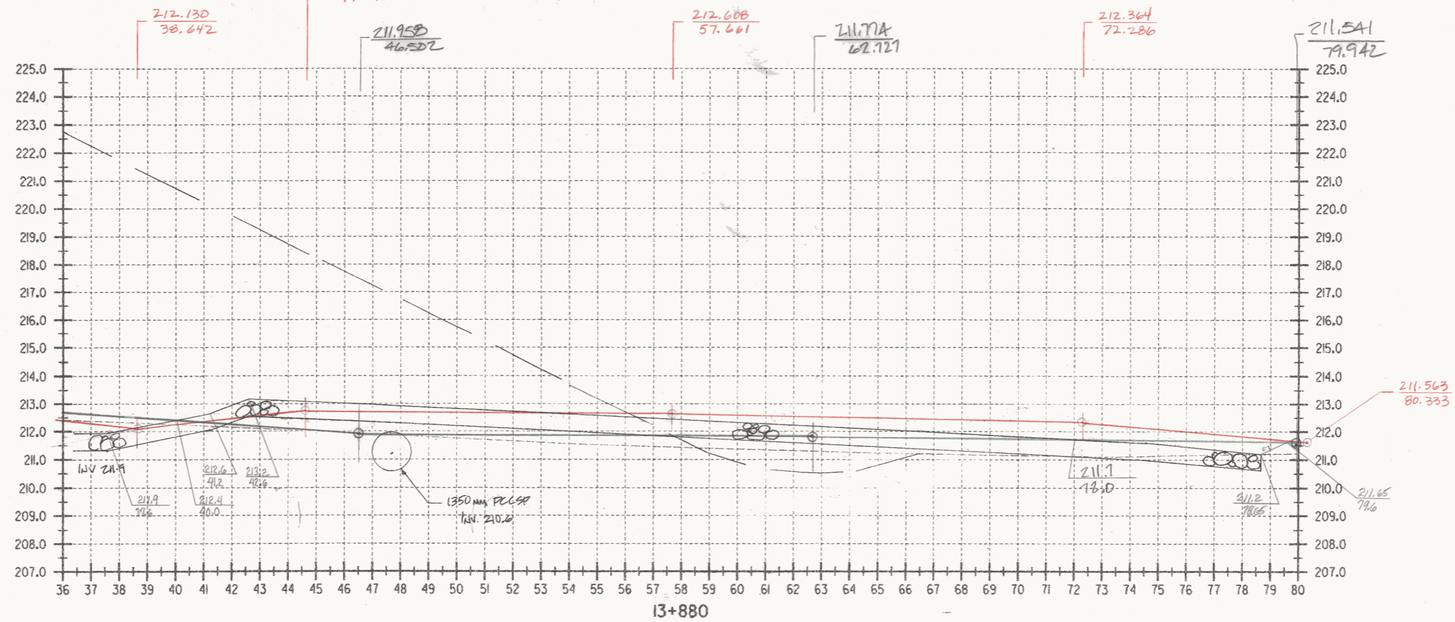

DATUM	
VERTICAL	NAVD 88
HORIZONTAL	NAD 83 (1992)

ALL DIMENSIONS IN MILLIMETERS EXCEPT AS INDICATED

2 0 2 m

H 1:100
V 1:100

SAND + SUBBASE TEMP CHECKED BY B.L. 1/15/04

SURVEYED BY	C.H.A. & V.S.E.	DATE	12/93
DRAWN BY	J.S.L.	DATE	6/98
SQUAD LEADER	T.P.K.		
DESIGN FILE NO.	/5116/VAOT/VTSECT3.D		
IPARM FILE		DATE PLOTTED	
PROJ. NAME	BENNINGTON - HOOSICK D.P.I. 0146(1) C/3		
PROJ. NO.	P.I.N. 1306.60		
SHEET 367 OF 473 SHEETS			