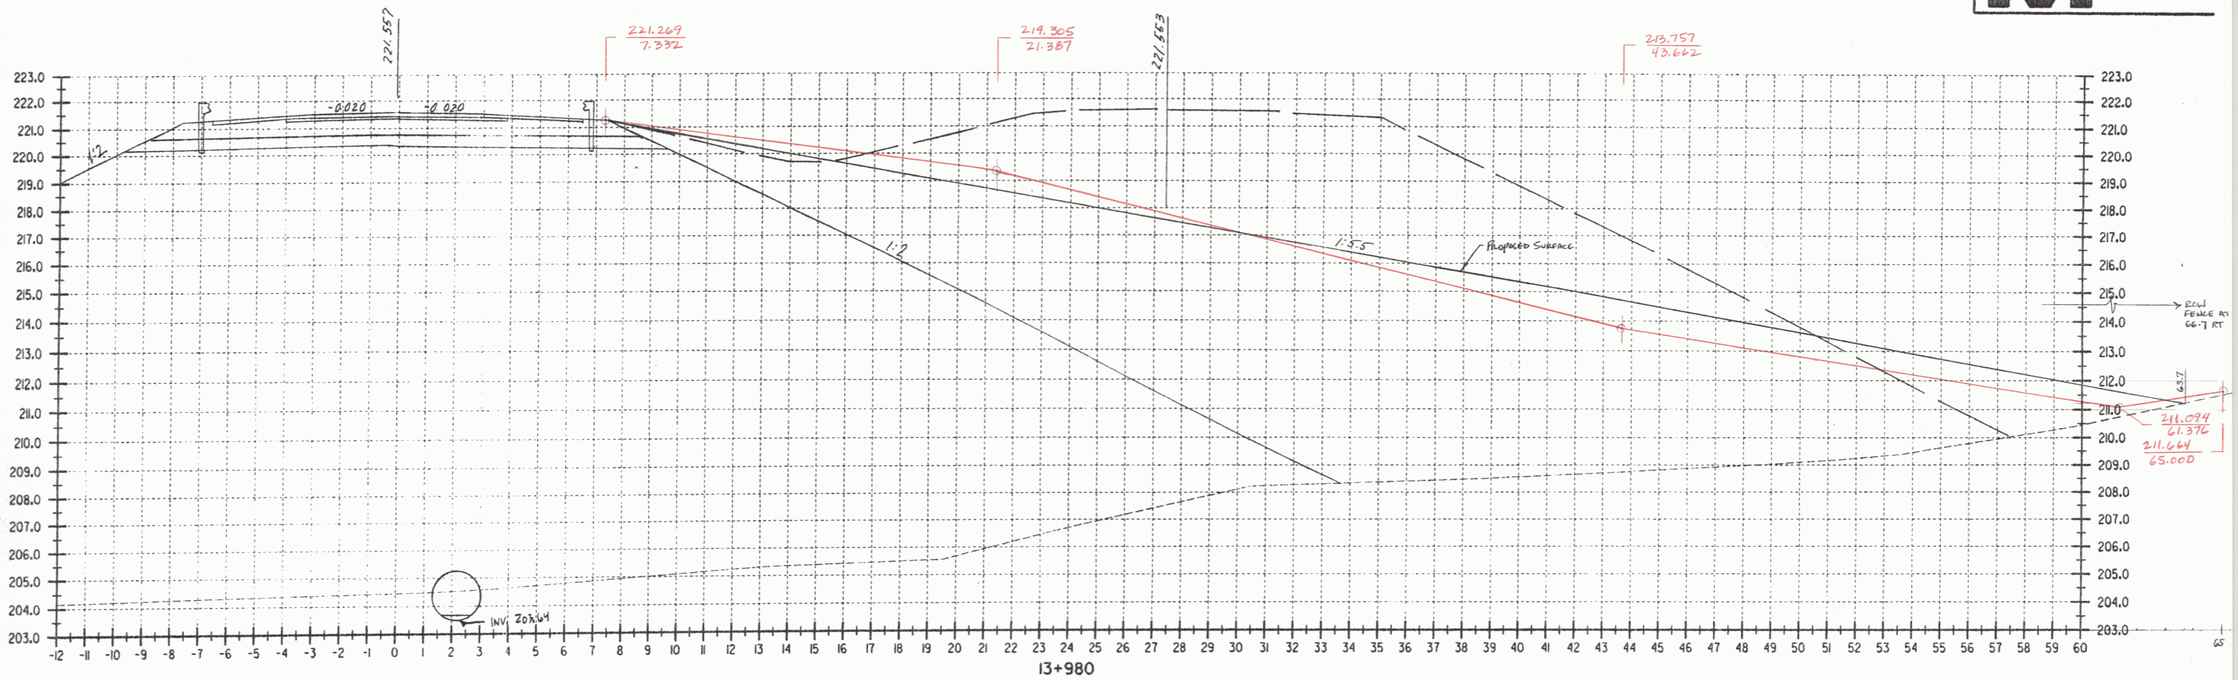

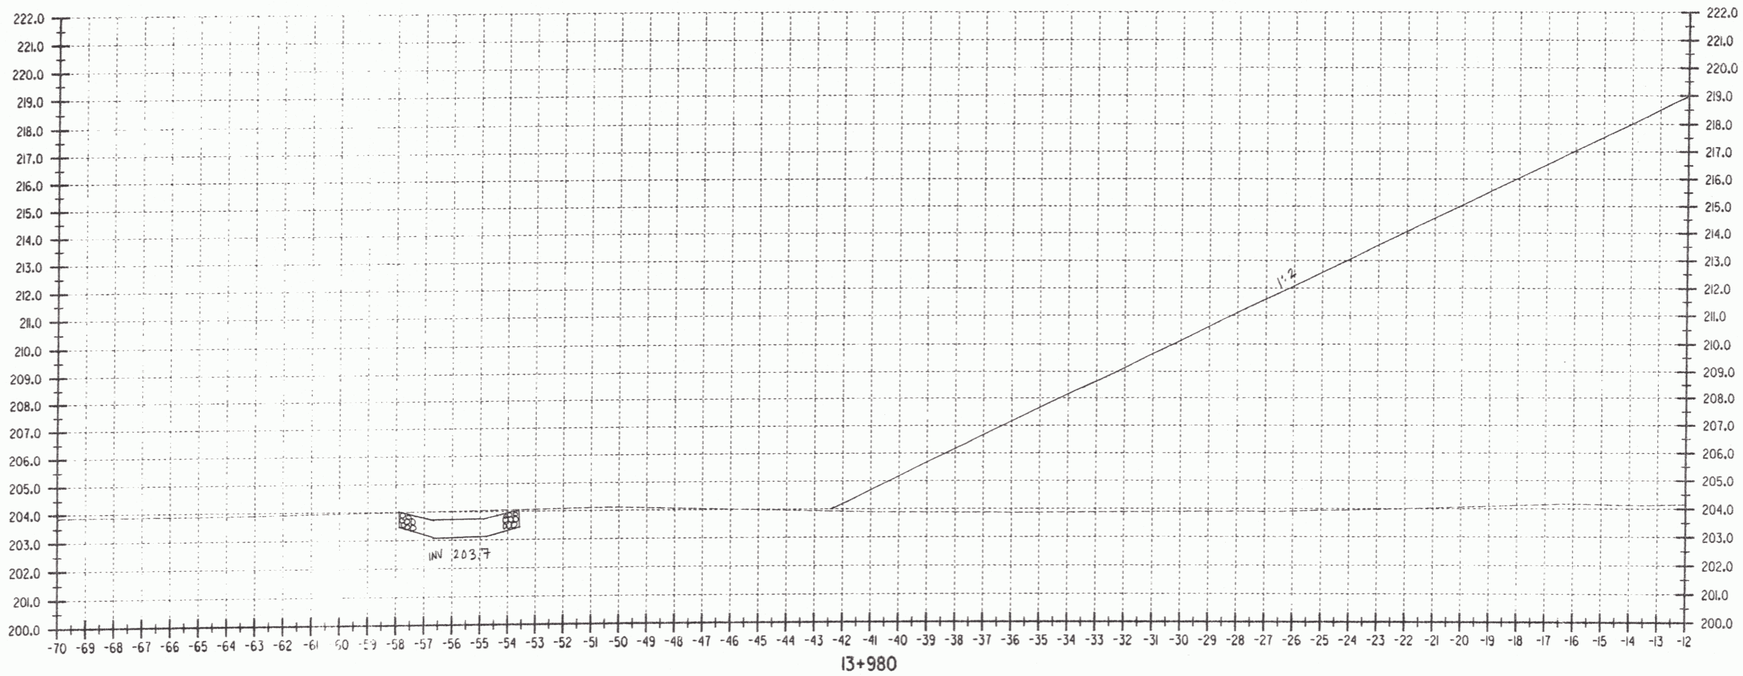

FG. RMT 2/1/05

C = 1
F = 748
R = 0
NET F = 217

SURVEYED BY C.H.A. & V.S.E.	DATE 12/93
DRAWN BY J.S.L.	DATE 6/98
SQUAD LEADER T.P.K.	REV. 01/03 - A
DESIGN FILE NO. /5116/VAOT/VTSECT3.D	RMT 2/1/05
IPARM FILE	DATE PLOTTED
PROJ. NAME BENNINGTON - HOOSICK D.P.I. 0146(1) C/3	
PROJ. NO. P.I.N. 1306.60	
SHEET 372 OF 473 SHEETS	

ALL DIMENSIONS IN MILLIMETERS EXCEPT AS INDICATED

2 0 2 m

H 1:100
V 1:100

DATUM

VERTICAL	NAVD 88
HORIZONTAL	NAD 83 (1992)