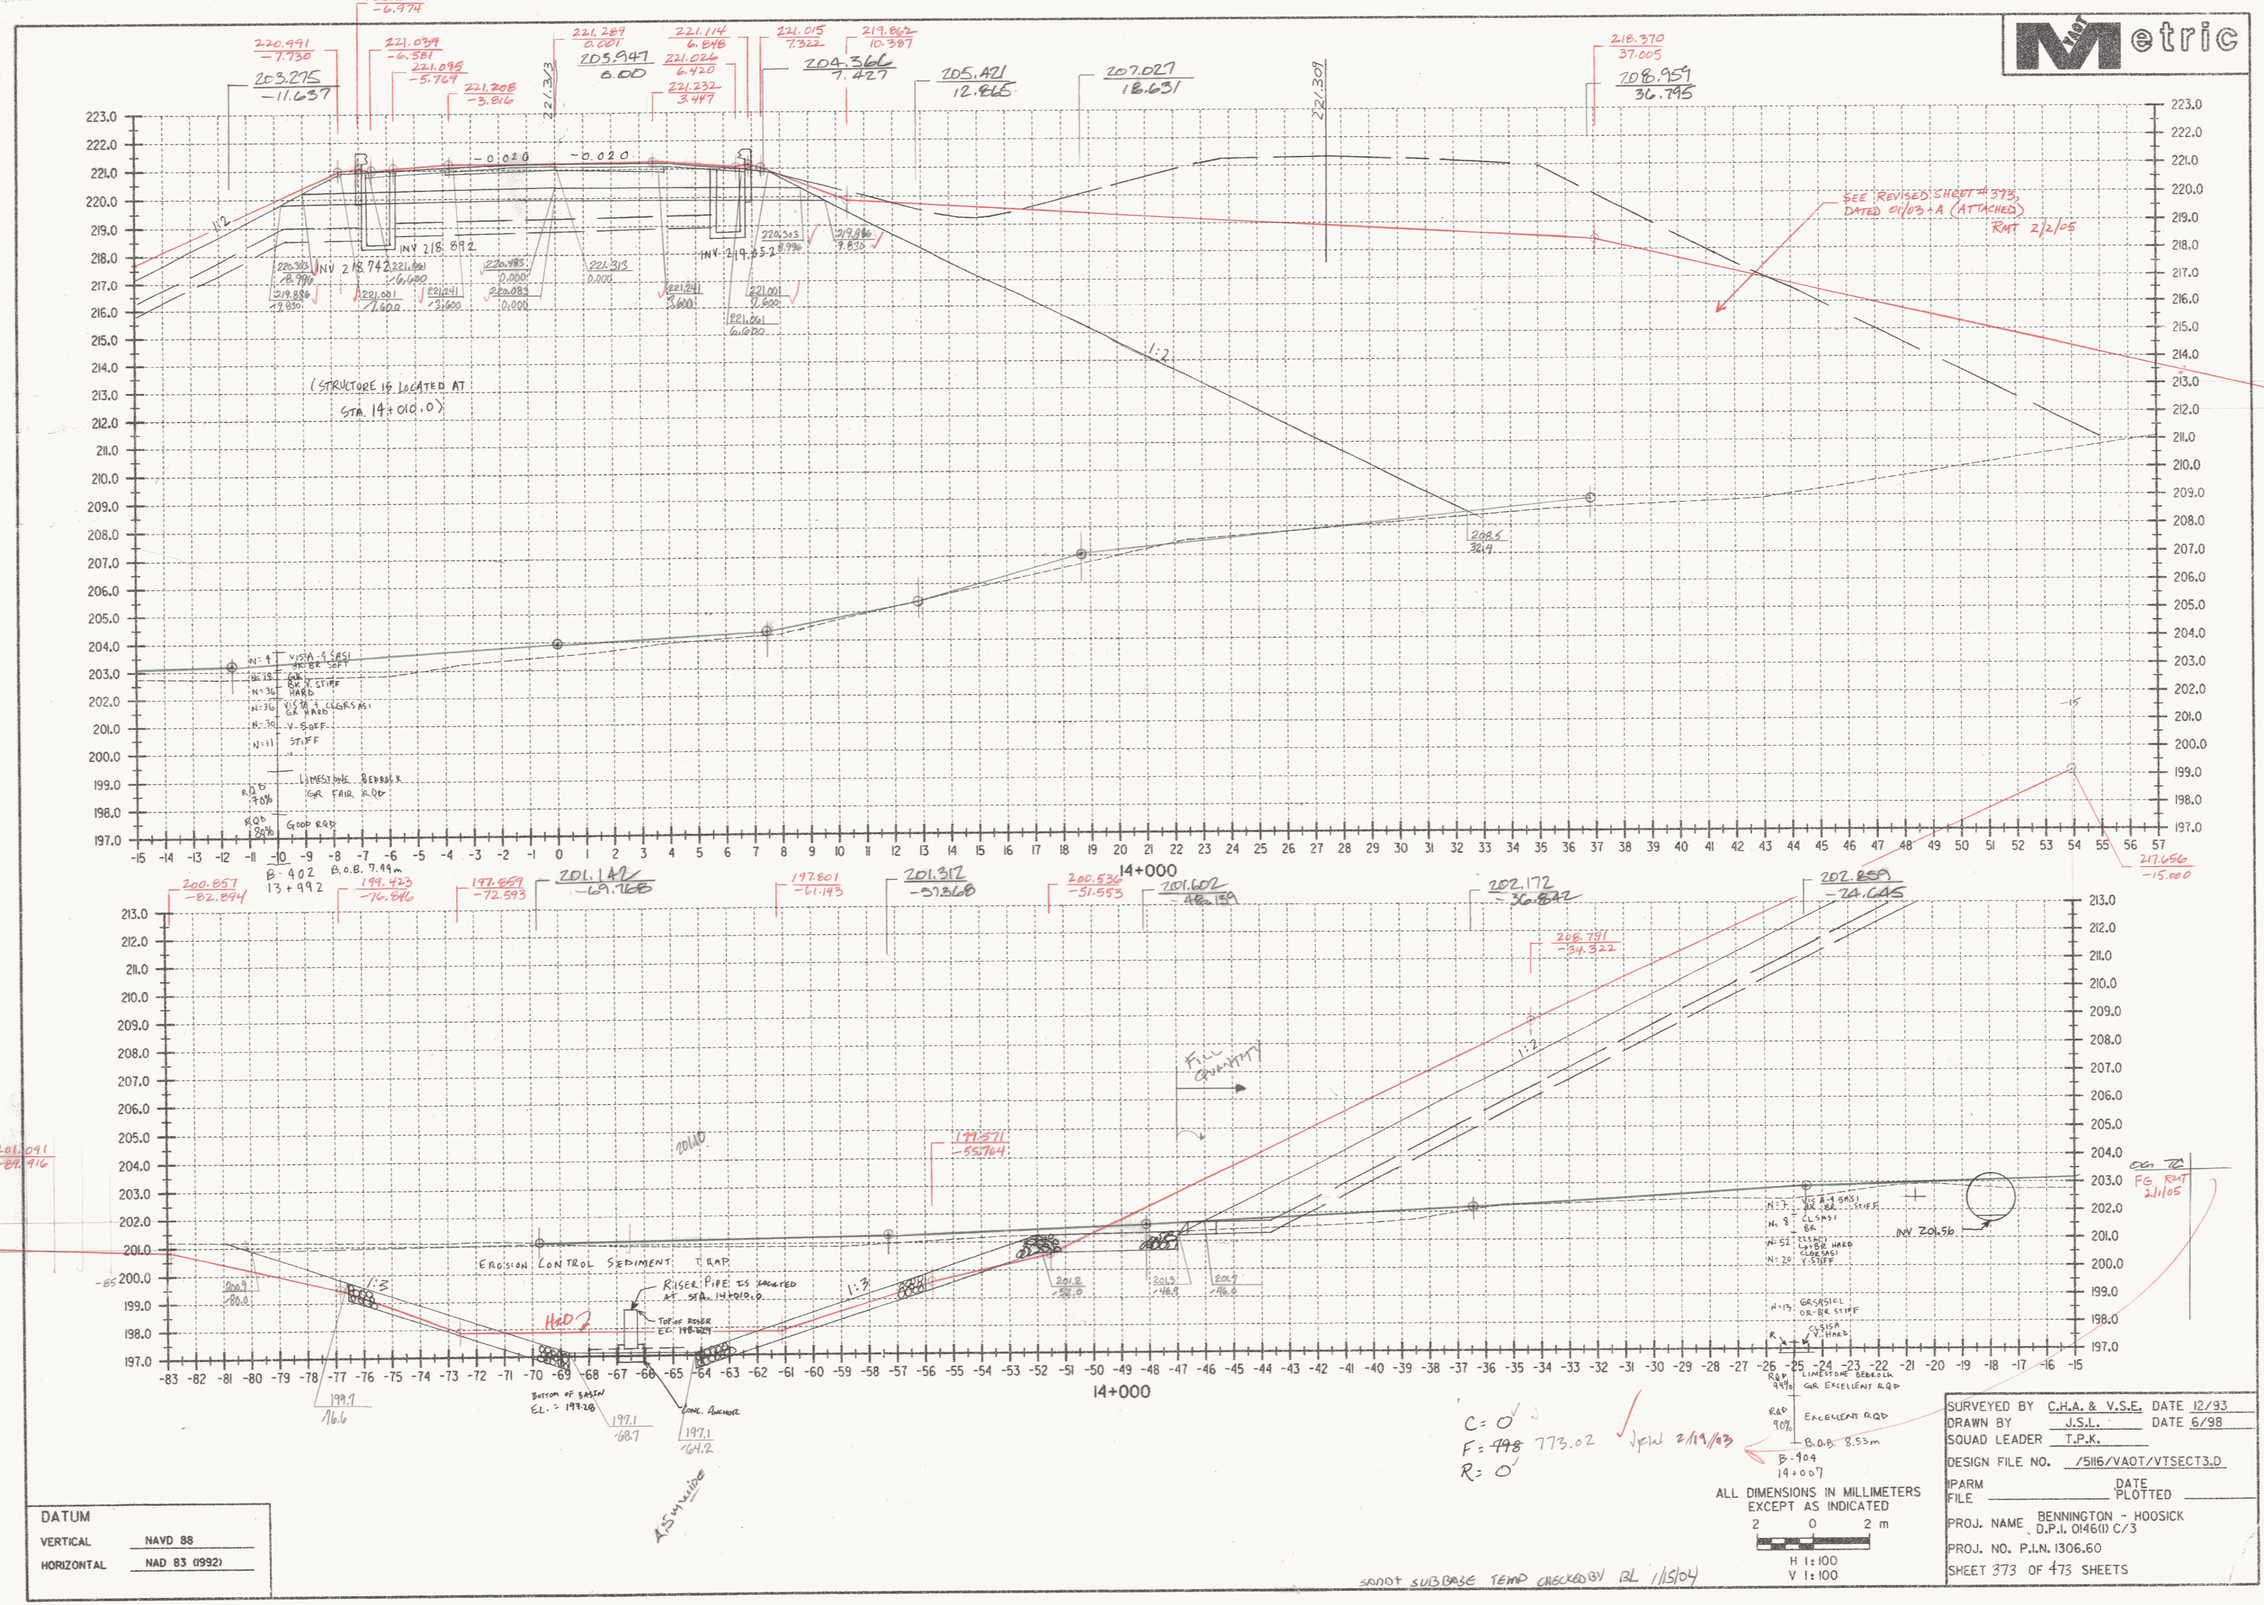
Metric
14+000
SEE REVISED SHEET #373, DATED 01/03 + A (ATTACHED)
RMT 2/2/05
(STRUCTURE IS LOCATED AT STA. 14+010.0)
INV 218.892
INV 218.742
INV 219.352
1:2
1:3
EROSION CONTROL SEDIMENT TRAP
RISER PIPE IS LOCATED AT STA. 14+012.0
TOPSOIL RESER
BOTTOM OF BASIN EL. = 197.26
CONC. ANCHOR
FILL QUANTITY
INV 201.56
B-402
13+992
B.O.B. 7.99m
B-404
14+007
B.O.B. 8.53m
C= 0'
F= ~~198~~ 773.02
R= 0'
JPW 2/19/03
ALL DIMENSIONS IN MILLIMETERS EXCEPT AS INDICATED
H 1:100
V 1:100
SANDY SUBBASE TEMP CHECKED BY RL 1/15/04
FG RMT 2/1/05
DATUM
VERTICAL NAVD 88
HORIZONTAL NAD 83 (1992)
SURVEYED BY C.H.A. & V.S.E. DATE 12/93
DRAWN BY J.S.L. DATE 6/98
SQUAD LEADER T.P.K.
DESIGN FILE NO. /5116/VAOT/VTSECT3.D
IPARM FILE
DATE PLOTTED
PROJ. NAME BENNINGTON - HOOSICK D.P.I. 0146(1) C/3
PROJ. NO. P.I.N. 1306.60
SHEET 373 OF 473 SHEETS