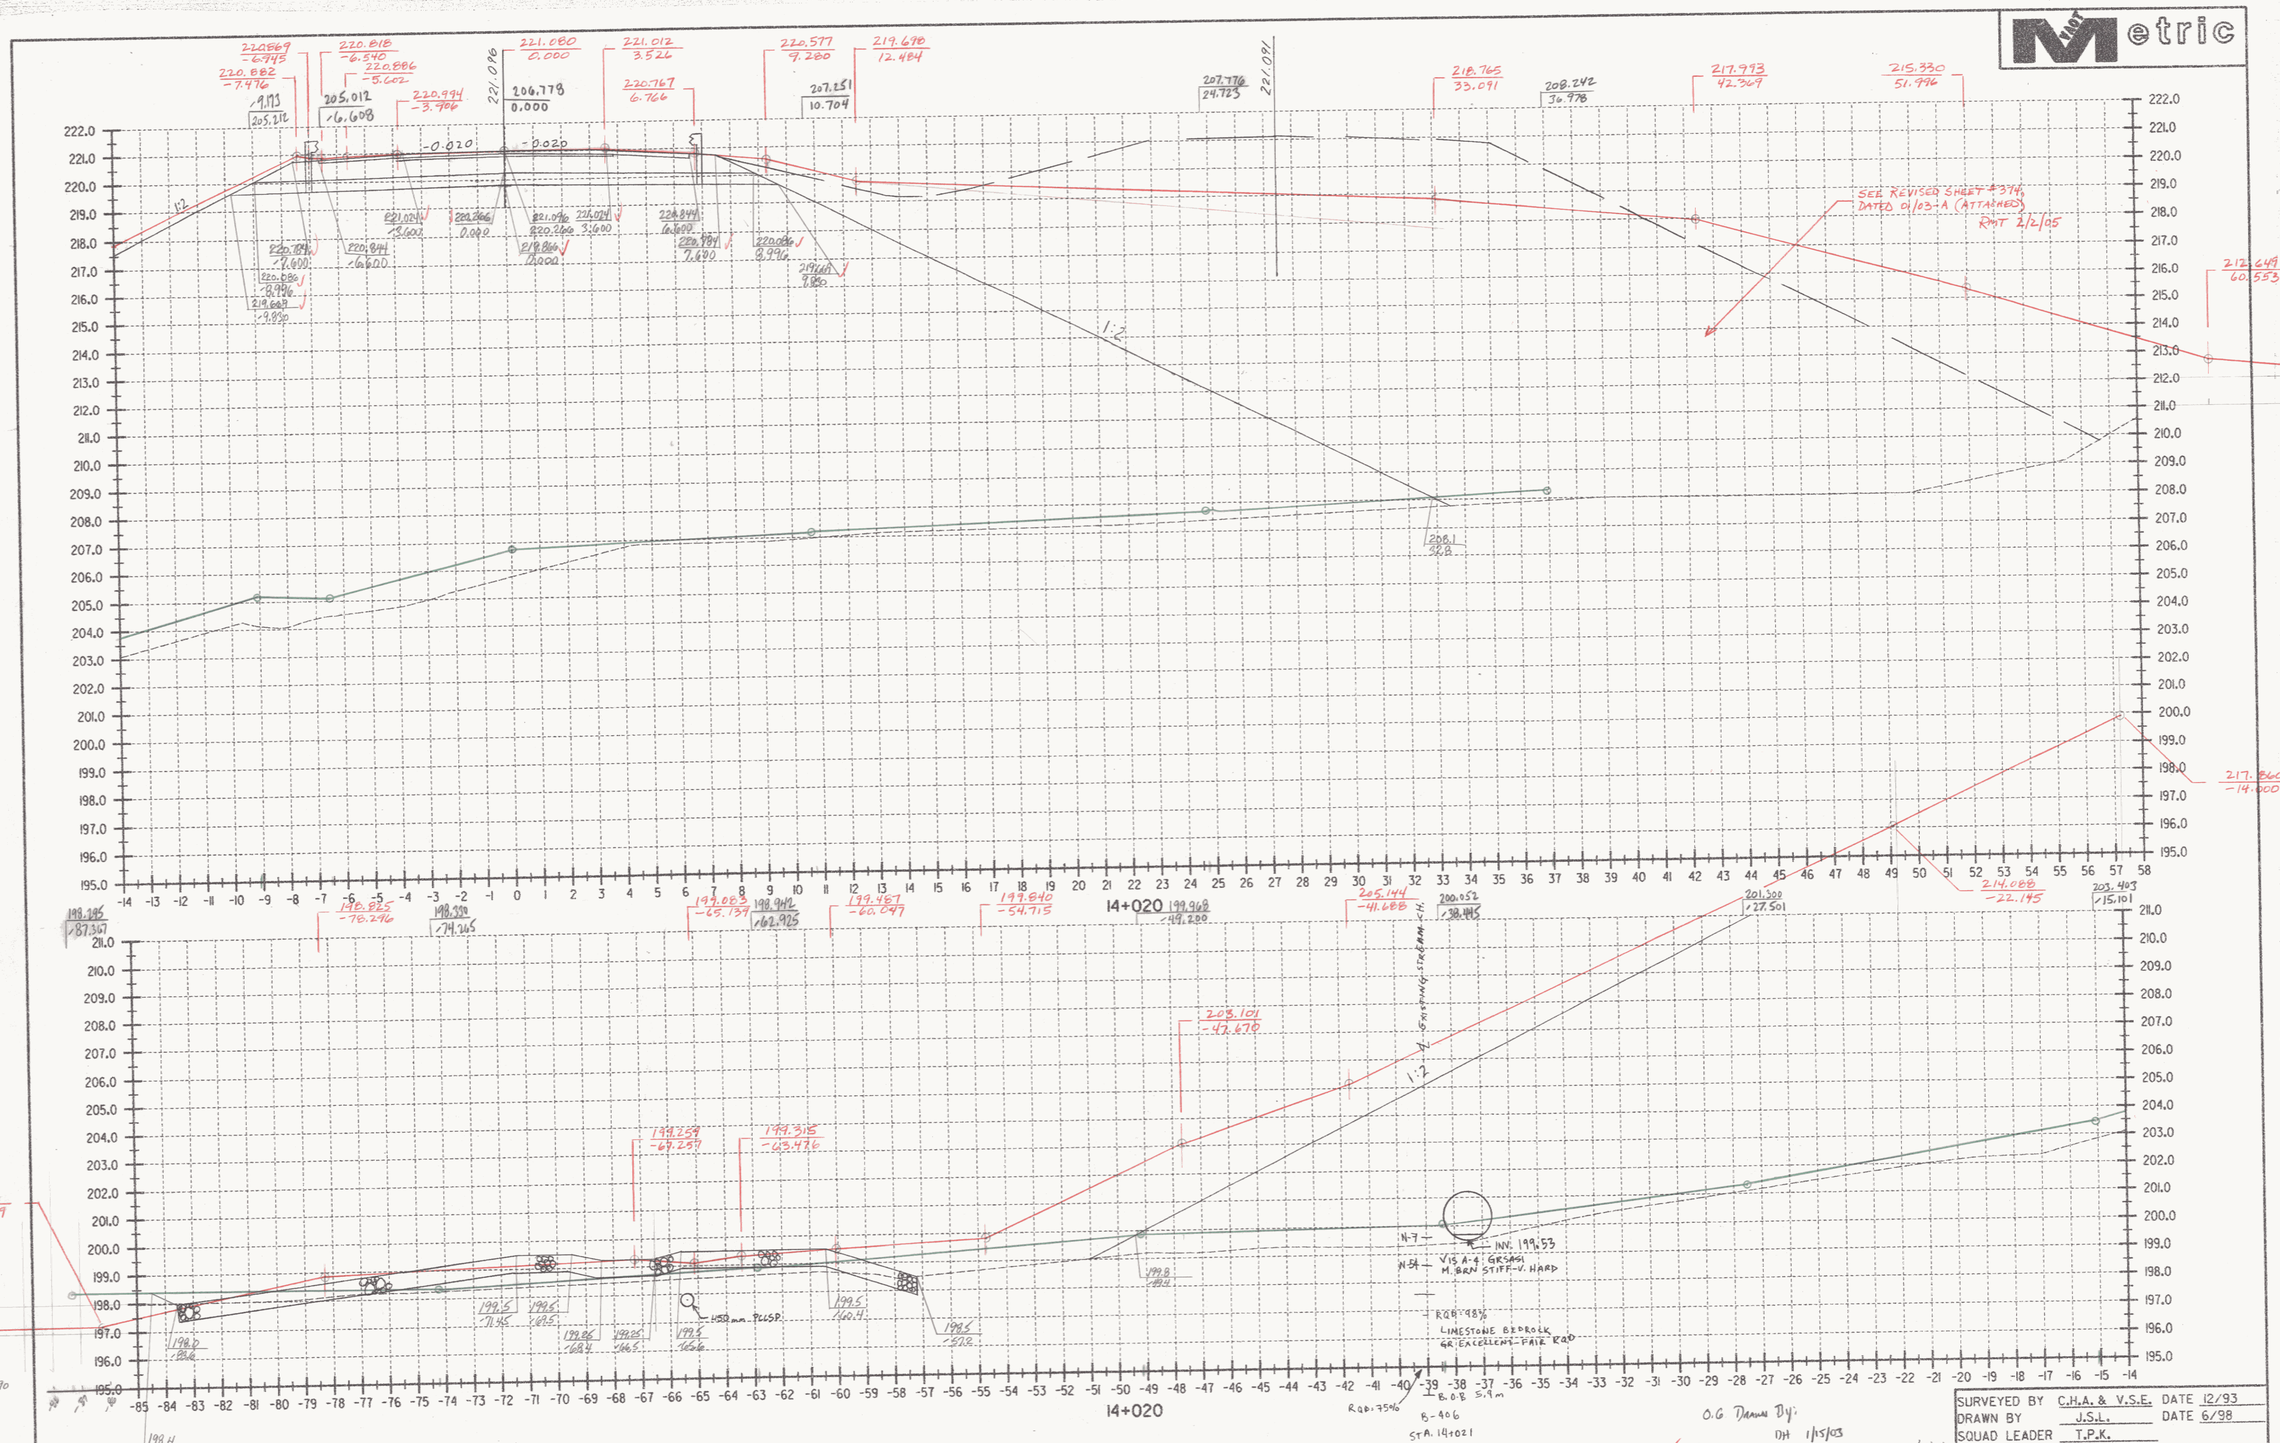
Metric
14+020
SEE REVISED SHEET #374, DATED 01/03-A (ATTACHED)
RMT 2/2/05
1:2
-0.020
221.096
206.778
0.000
207.776
24.723
208.242
30.976
207.251
10.704
205.012
16.608
205.212
9.193
218.765
33.091
217.993
42.369
215.330
51.996
212.649
60.553
212.331
64.273
217.860
-14.000
214.088
-22.145
203.403
15.101
201.300
27.501
200.052
38.145
199.968
49.200
205.144
-41.688
203.101
-42.670
199.840
-54.715
197.487
-60.047
197.083
-65.139
199.942
162.925
198.394
174.265
198.225
-76.296
198.185
187.367
199.259
-69.257
199.315
-63.476
198.212
-86.259
198.201
-90.244
N-7
INV. 199.53
N-54
VIS A-4 GRS4M1
M. BRN STIFF-V. HARD
RQD-98%
LIMESTONE BEDROCK
GR. EXCELLENT-FAIR RQD
B-406
STA. 14+021
O.G. Drawn By:
DH 1/15/03
SWMDTSUB13A66 TEMP CHECKED BL, 1/15/04
C= 0
F= ~~780~~ 734.87
R= 0
FG RMT 2/2/05
ALL DIMENSIONS IN MILLIMETERS EXCEPT AS INDICATED
H 1:100
V 1:100
DATUM
VERTICAL NAVD 88
HORIZONTAL NAD 83 (1992)
SURVEYED BY C.H.A. & V.S.E. DATE 12/93
DRAWN BY J.S.L. DATE 6/98
SQUAD LEADER T.P.K.
DESIGN FILE NO. /5116/VAOT/VTSECT3.D
PARM FILE
DATE PLOTTED
PROJ. NAME BENNINGTON - HOOSICK D.P.I. 0146(1) C/3
PROJ. NO. P.I.N. 1306.60
SHEET 374 OF 473 SHEETS