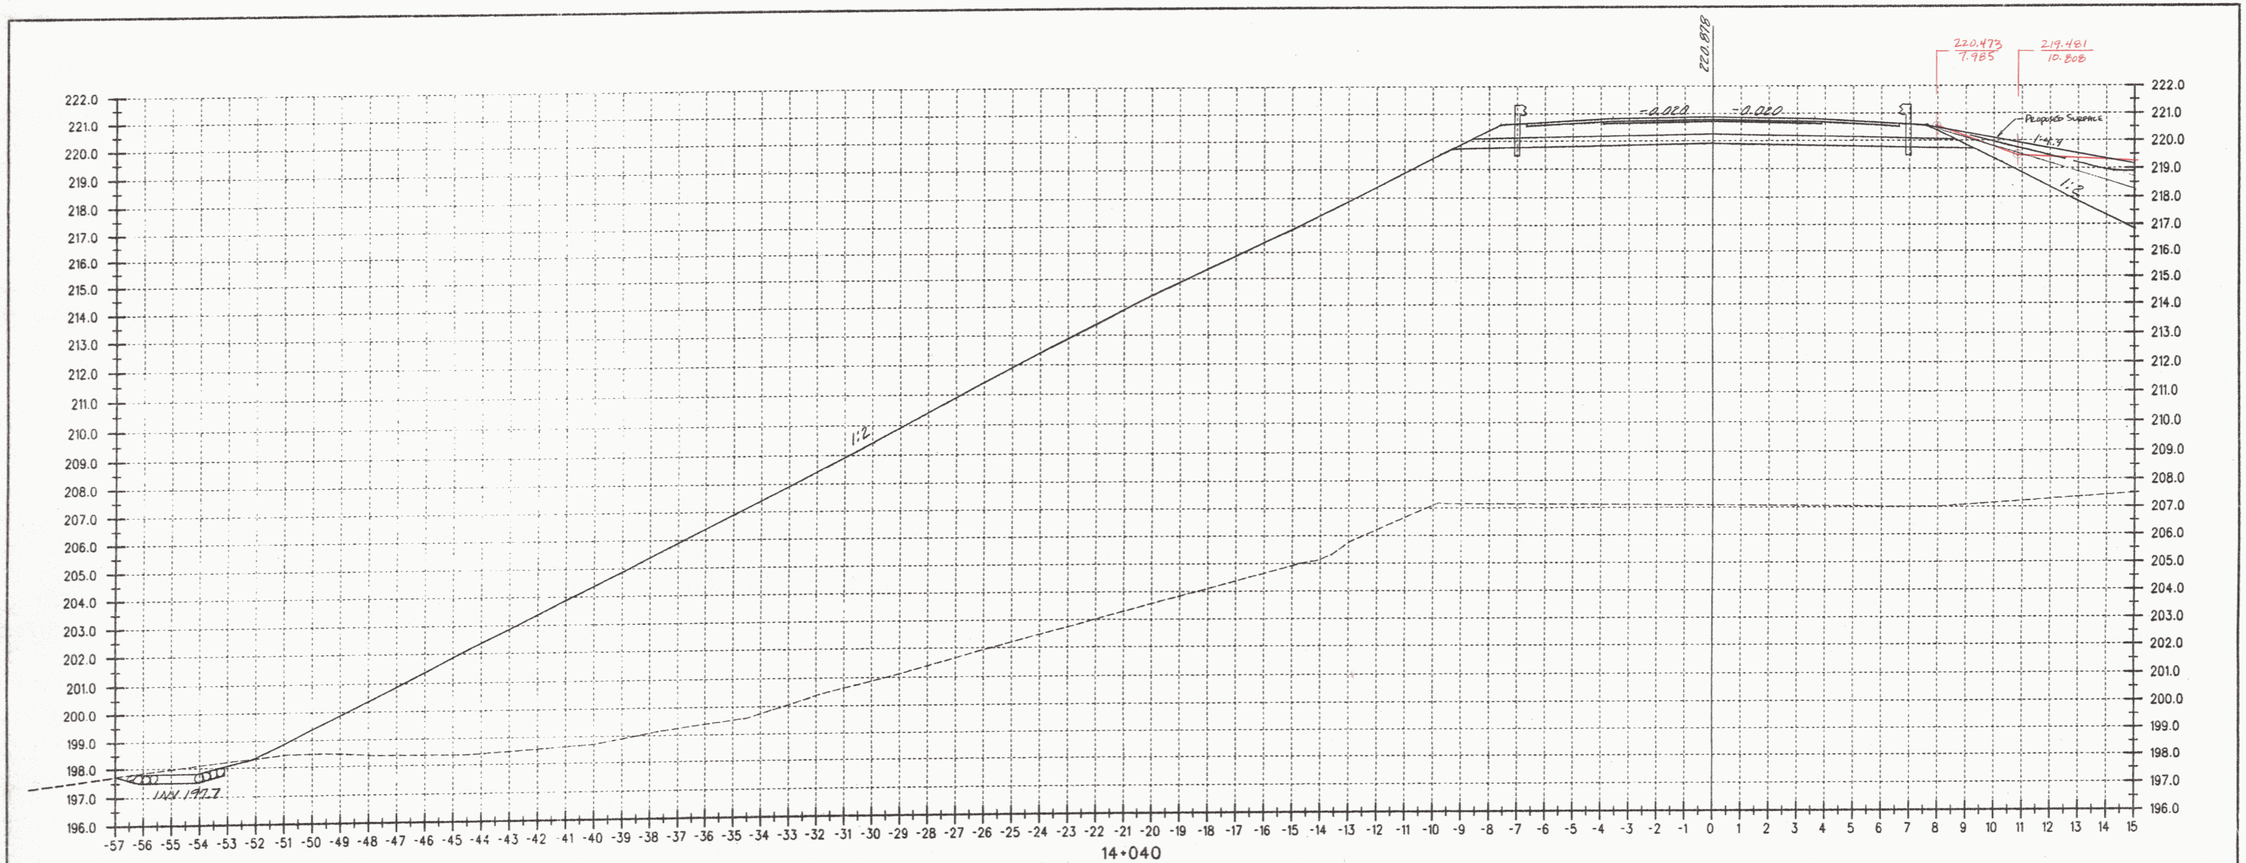

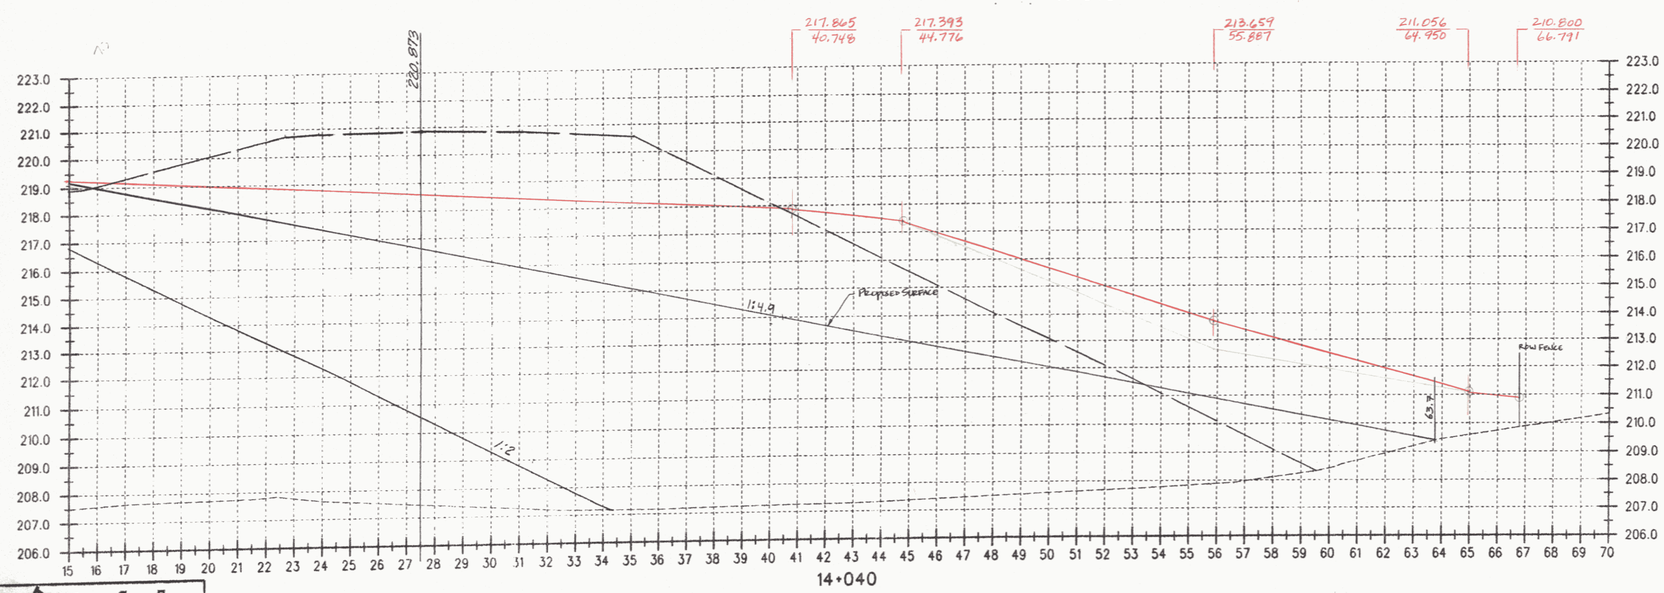

FG. RMT 2/2/05

C = 0
F = 713
R = 0
NET F = 237

SURVEYED BY C.H.A. & V.S.E.	DATE
DRAWN BY J.S.L.	DATE
SQUAD LEADER T.P.K.	REV. 01/03 - A RMT 2/2/05
DESIGN FILE NO. N/A	
PARM FILE	DATE PLOTTED
PROJ. NAME BENNINGTON - HOOSICK D.P.I. 0146(1) C/3	
PROJ. NO. P.I.N. 1306.60.201	
SHEET 375 OF 473 SHEETS	

ALL DIMENSIONS IN MILLIMETERS EXCEPT AS INDICATED

2 0 2 m

H 1:100
V 1:100

MOT Metric

DATUM

VERTICAL NAVD 88

HORIZONTAL NAD 83 (1992)