Metric

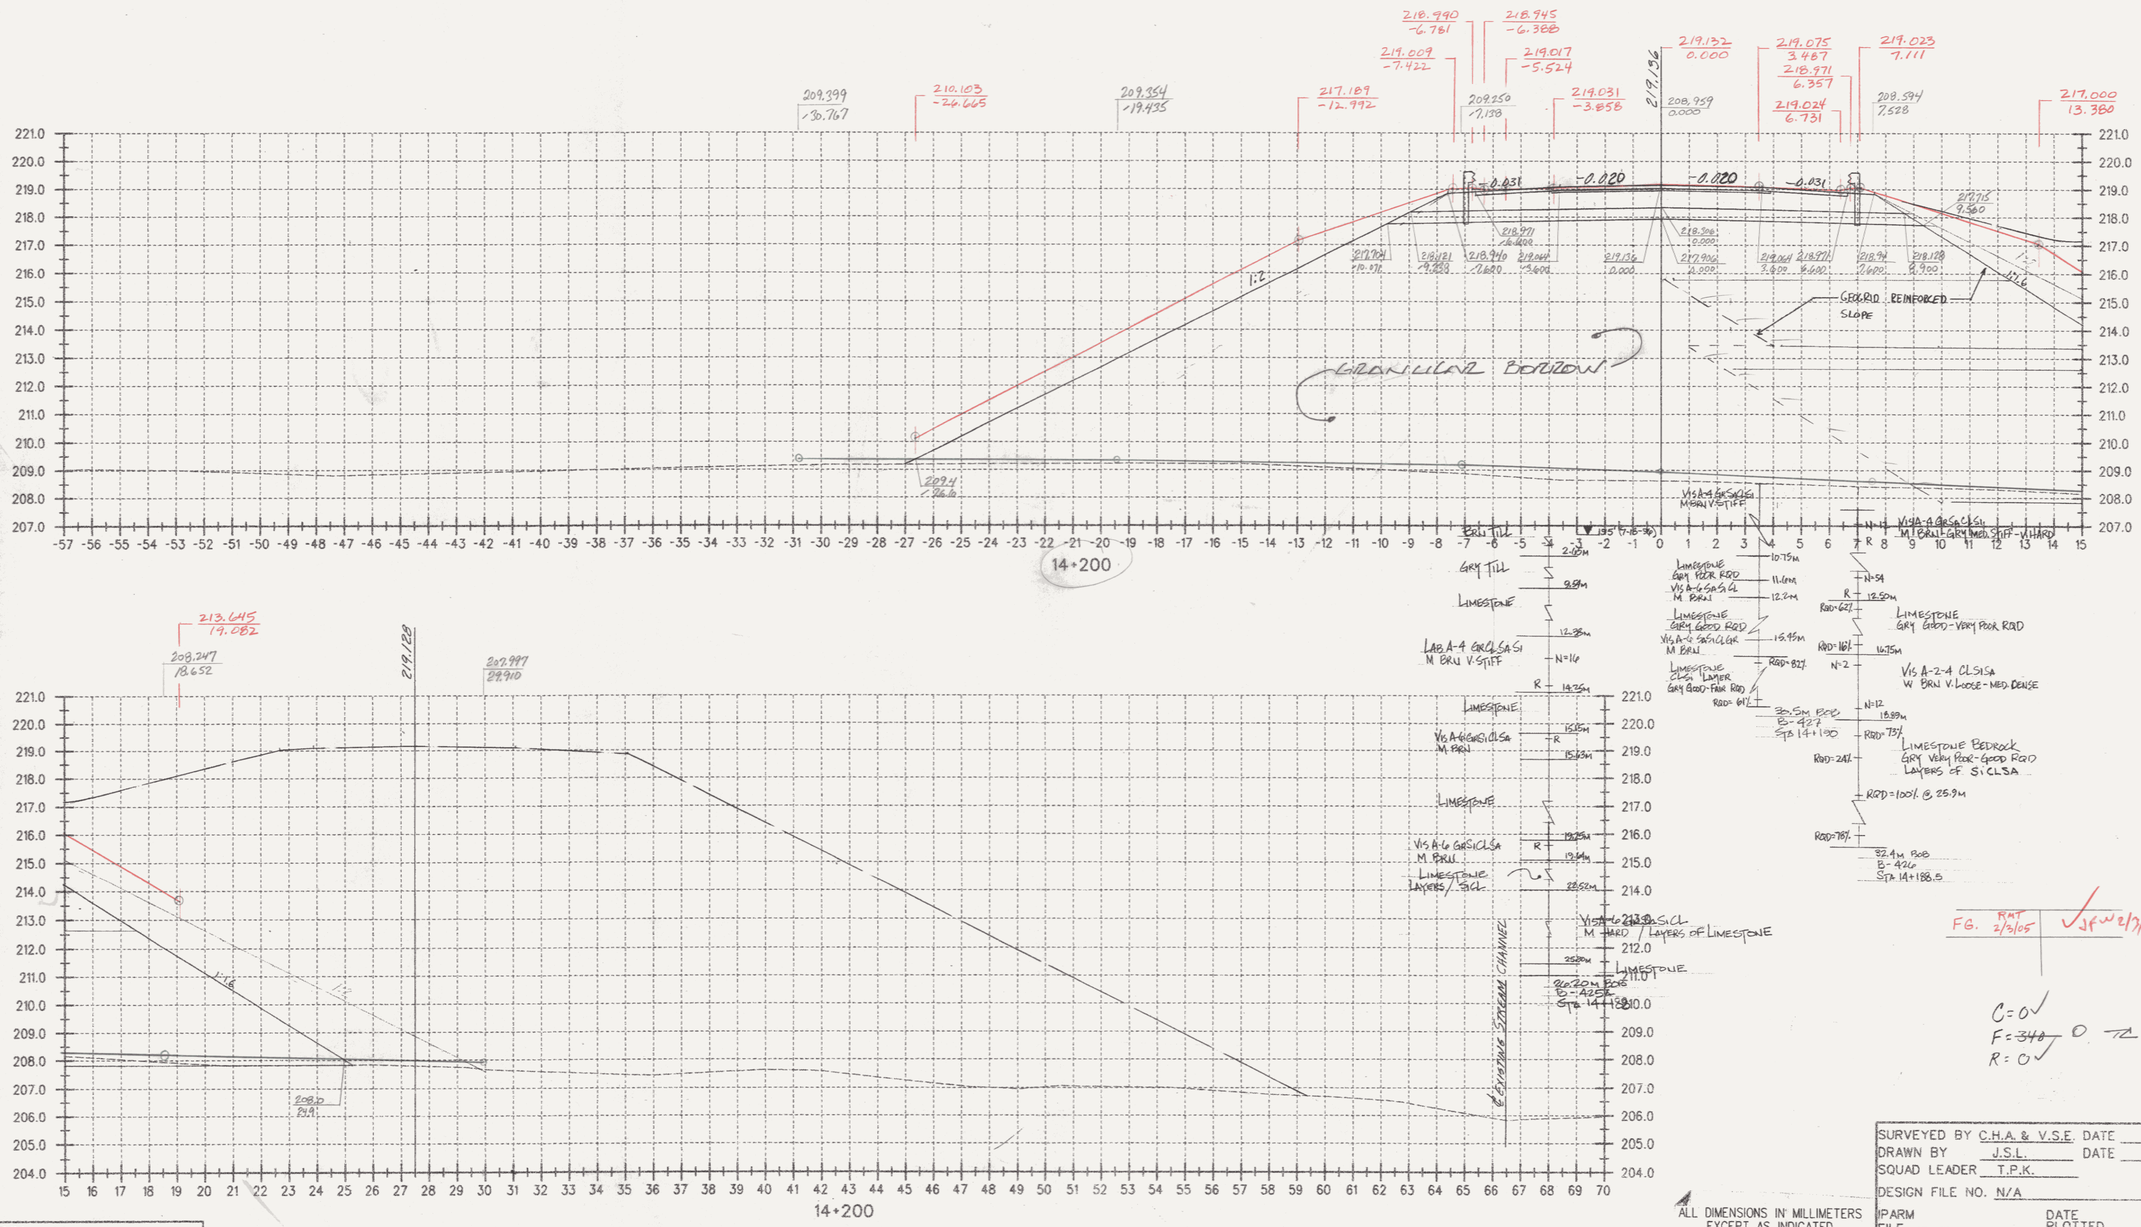

F.G. RMT 2/3/05 JFW 2/3/05

C = 0
F = ~~340~~ 0
R = 0