Metric

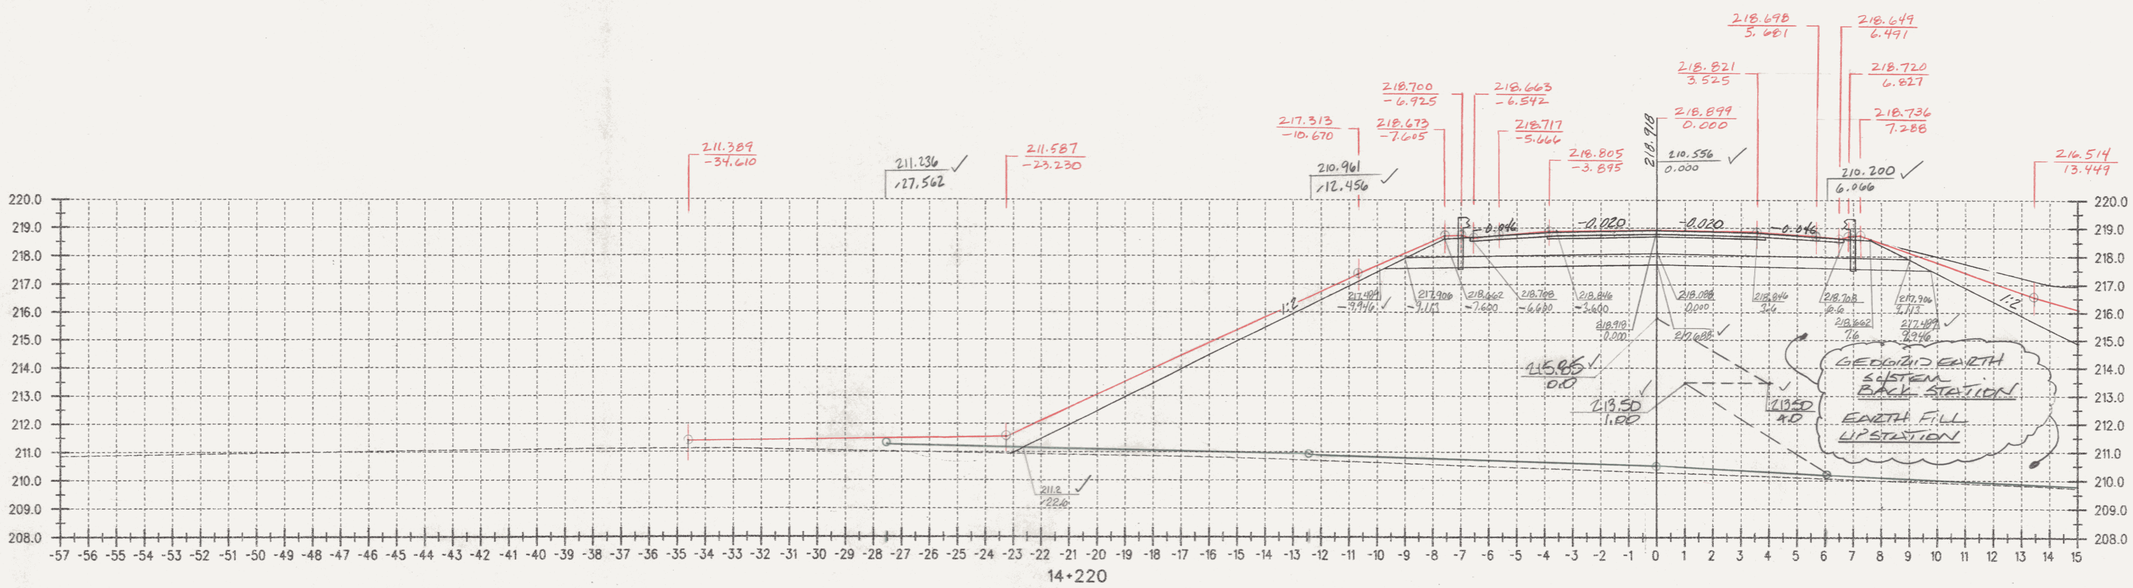

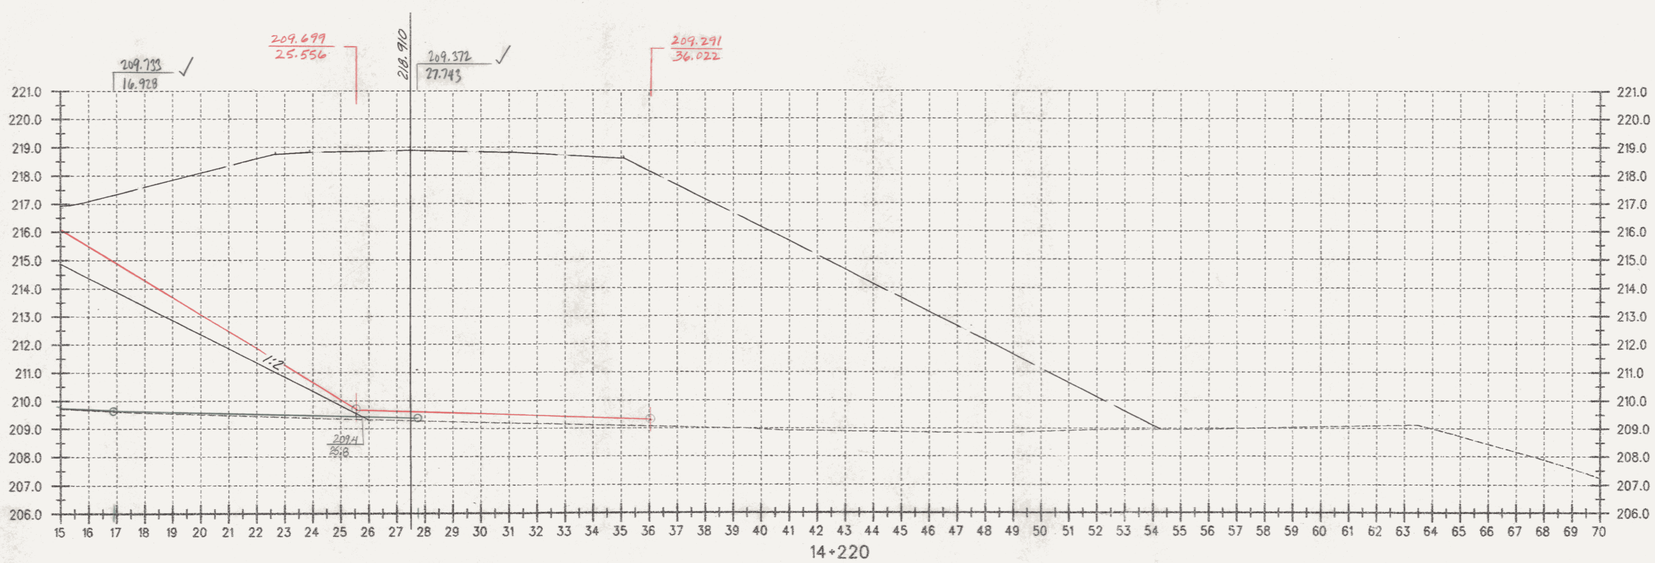

	BY	V BY
O.G.	DH 1-15-03	RRM 2-12-03
TEMP. ELV. + o/s	T.C. + DH	RRM 2-12-03
FG.	RHT 2/3/05	VJpw 2/3/05

C=0
F=~~248~~ UP 243.97 m²
Back 125.32 m²
R=0

O.G. Drawn By: DH 1/15/03
Checked By:

ALL DIMENSIONS IN MILLIMETERS EXCEPT AS INDICATED

2 0 2 m
H 1:100
V 1:100

DATUM
VERTICAL NAVD 88
HORIZONTAL NAD 83 (1992)

SURVEYED BY C.H.A. & V.S.E. DATE
DRAWN BY J.S.L. DATE
SQUAD LEADER T.P.K.
DESIGN FILE NO. N/A
IPARM FILE DATE PLOTTED
PROJ. NAME BENNINGTON - HOOSICK D.P.I. 0146(1) C/3
PROJ. NO. P.I.N. 1306.60.201
SHEET 384 OF 473 SHEETS