Metric

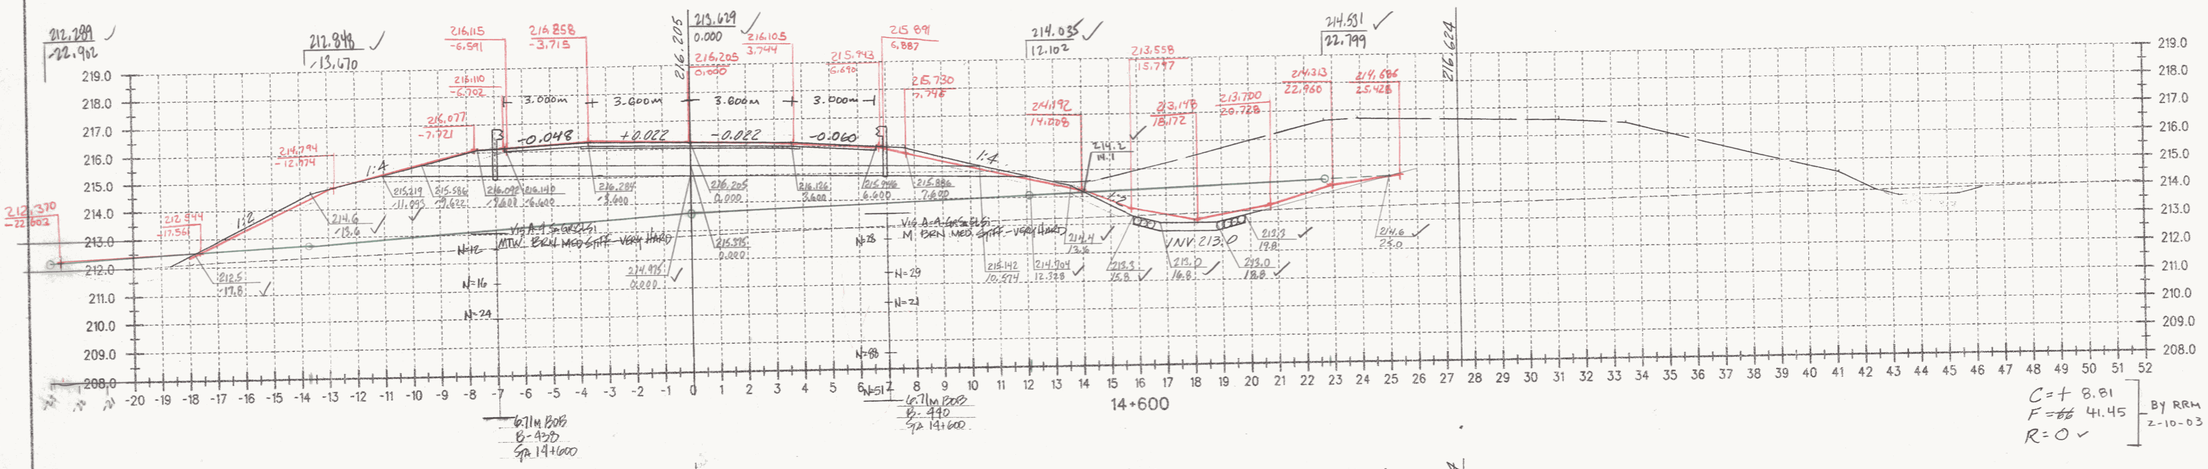

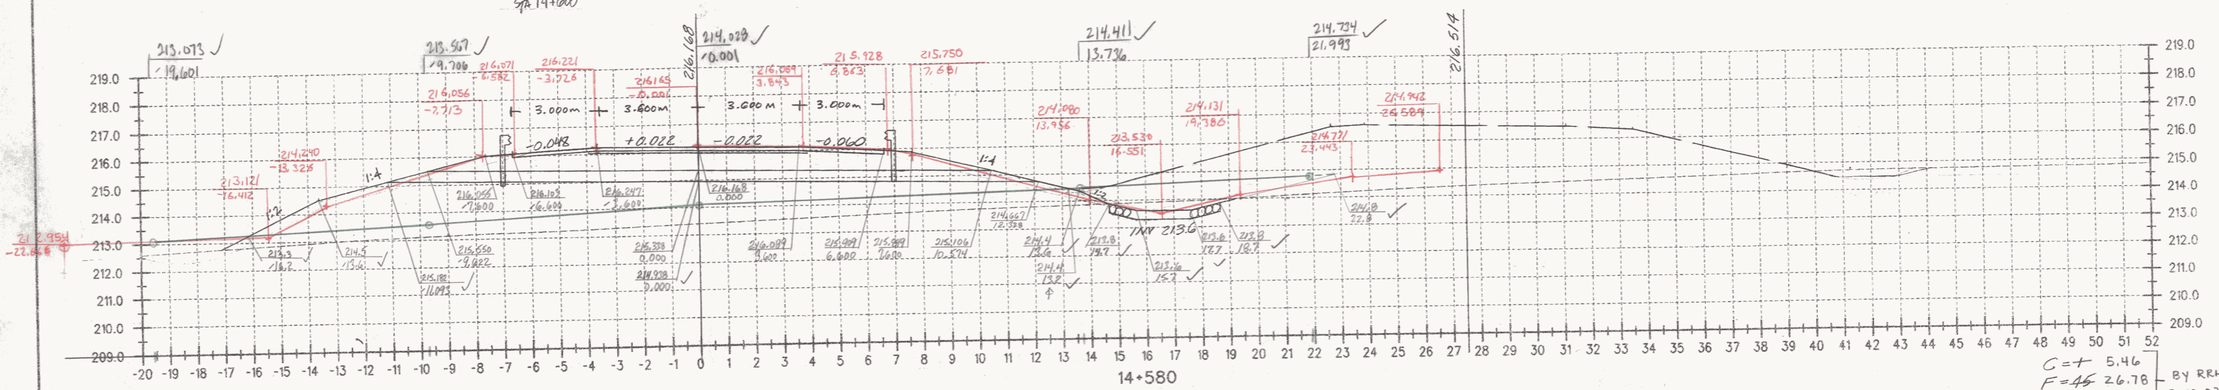

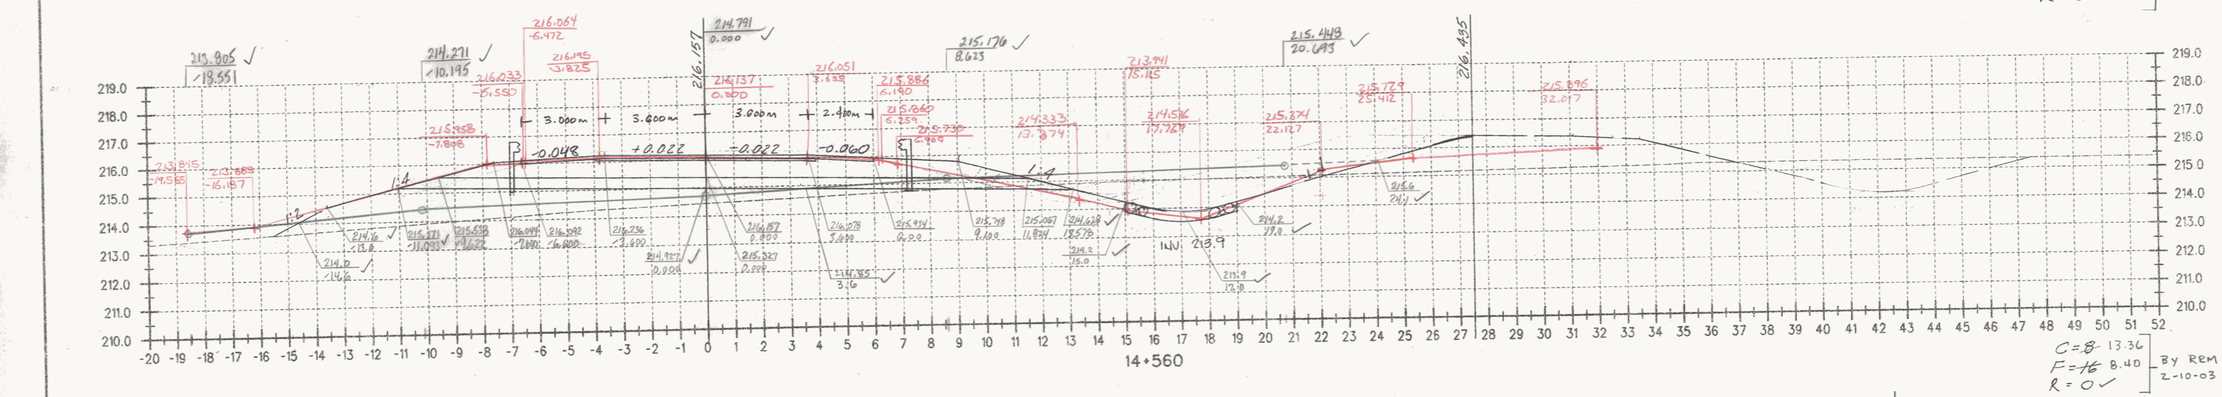

ALL SECT'S	BY	✓ BY
O.G.	DH 1/15/03	RRM 2-13-03
TEMP ELV + O/S FG.	DH	RRM 2-13-03
	DC 4/10/05	✓ 4/14/05

ALL DIMENSIONS IN MILLIMETERS EXCEPT AS INDICATED

2 0 2 m

H 1:100
V 1:100

SURVEYED BY C.H.A. & V.S.E. DATE
DRAWN BY J.S.L. DATE
SQUAD LEADER T.P.K.
DESIGN FILE NO. n/a
IPARM FILE DATE PLOTTED
PROJ. NAME BENNINGTON - HOOSICK D.P.I. 0146(1) C/3
PROJ. NO. P.I.N. 1306.60.201
SHEET 391 OF 473 SHEETS

DATUM
VERTICAL NAVD 88
HORIZONTAL NAD 83 (1992)