Metric

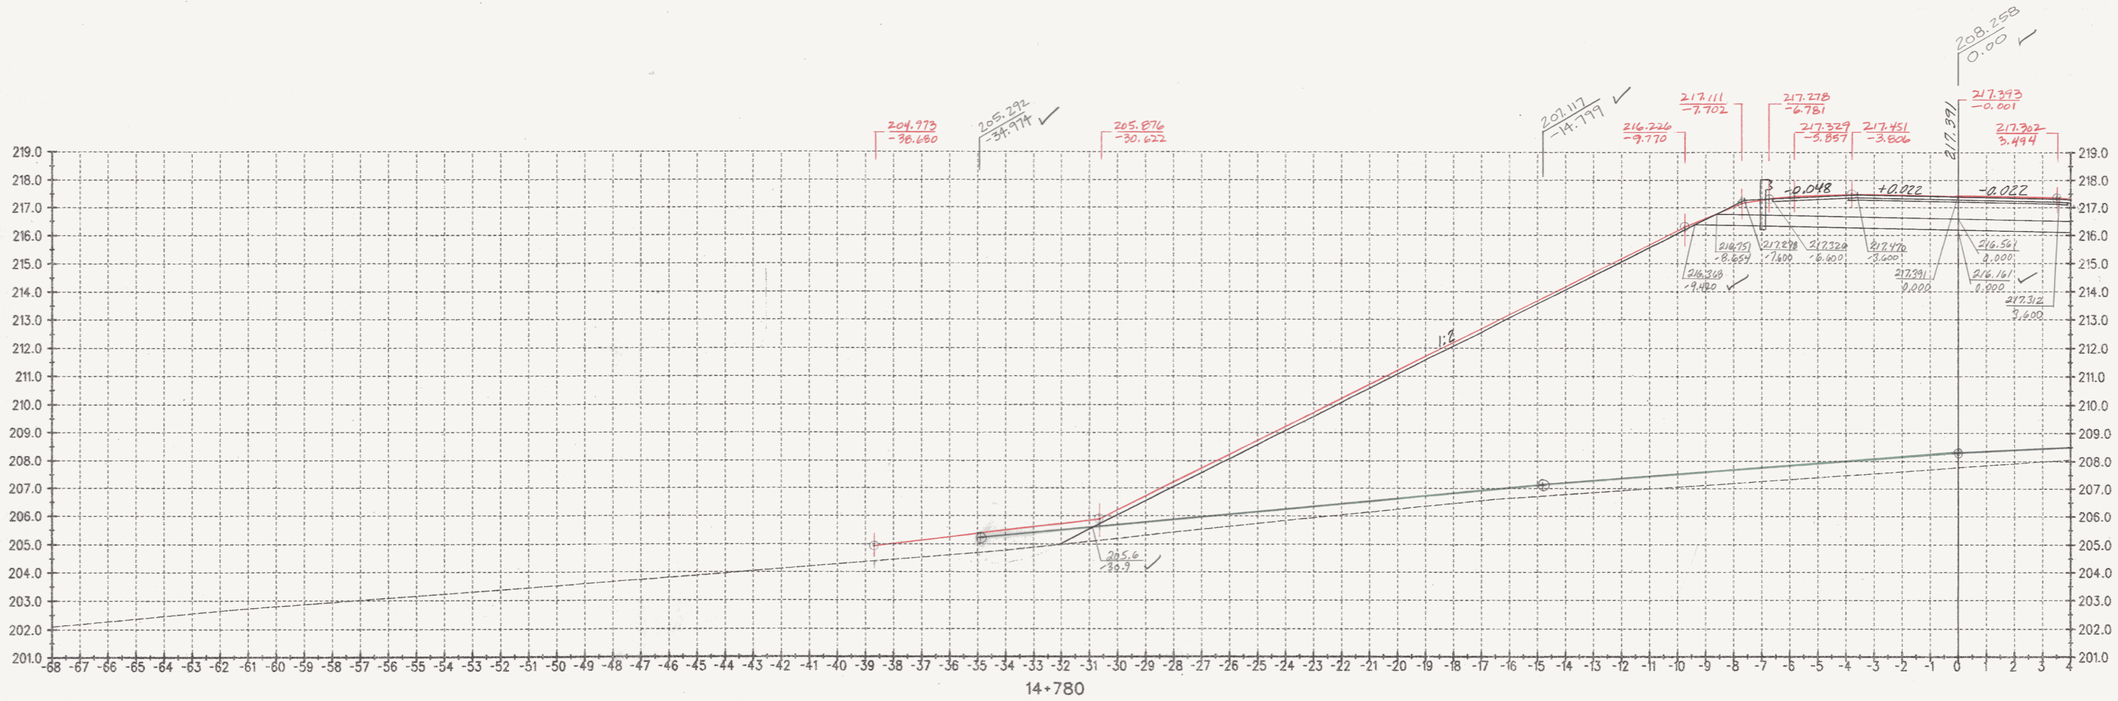

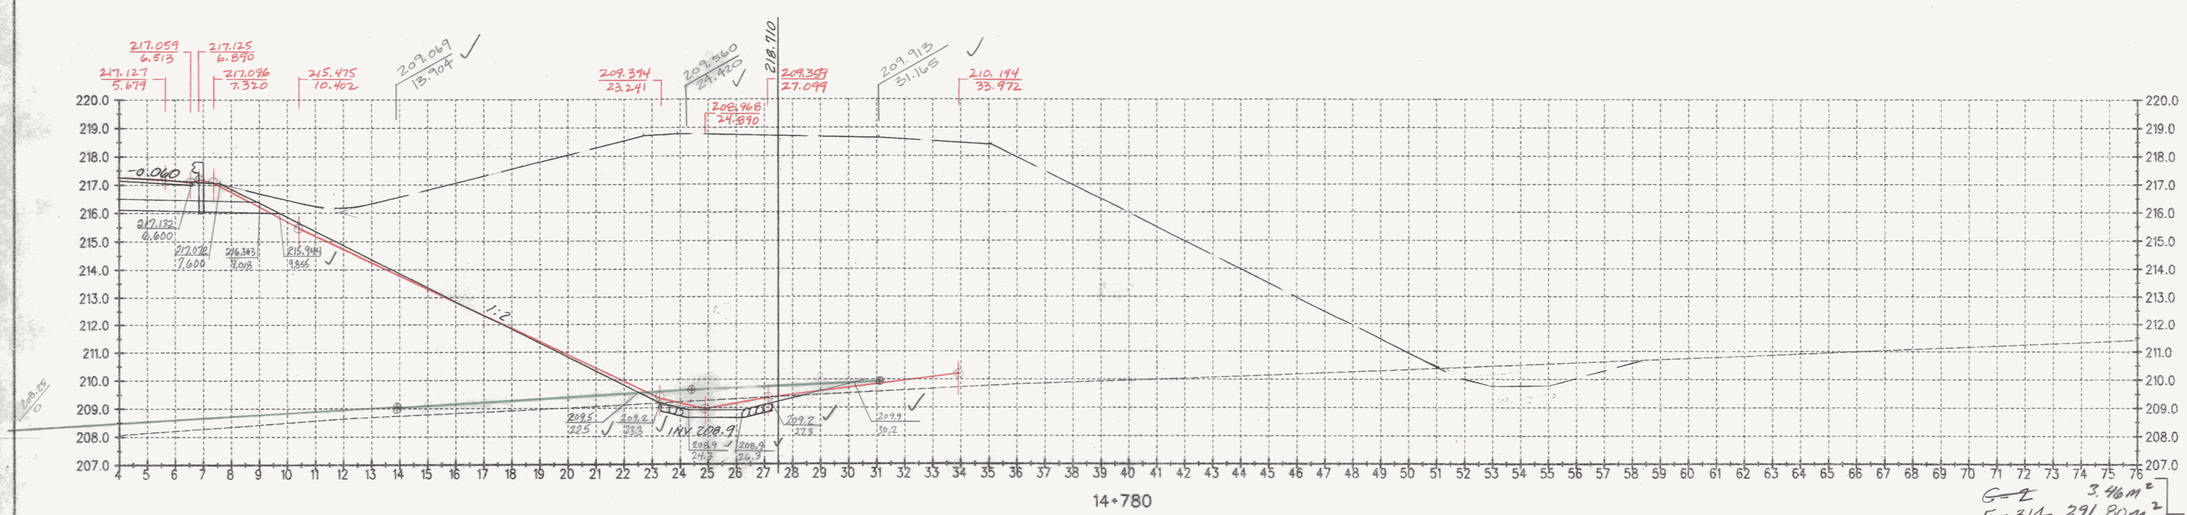

G = 2 3.46 m²
~~F = 314~~ 291.80 m²
R = 0

VERMONT TRANSPORT O.G.	TEMP. ELV. +0/S
DRAWN BY JPEW 1/14/03	BY B.B.
✓ BY RRM 2-13-03	✓ BY RRM 2-13-03
FG RMT 4/13/05	✓ JPW 4/13/05

DATUM
VERTICAL NAVD 88
HORIZONTAL NAD 83 (1992)

ALL DIMENSIONS IN MILLIMETERS EXCEPT AS INDICATED
2 0 2 m
H 1:100
V 1:100

SURVEYED BY C.H.A. & V.S.E. DATE
DRAWN BY J.S.L. DATE
SQUAD LEADER T.P.K.
DESIGN FILE NO. N/A
IPARM FILE DATE PLOTTED
PROJ. NAME BENNINGTON - HOOSICK D.P.I. 0146(1) C/3
PROJ. NO. P.I.N. 1306.60.201
SHEET 396 OF 473 SHEETS