Metric

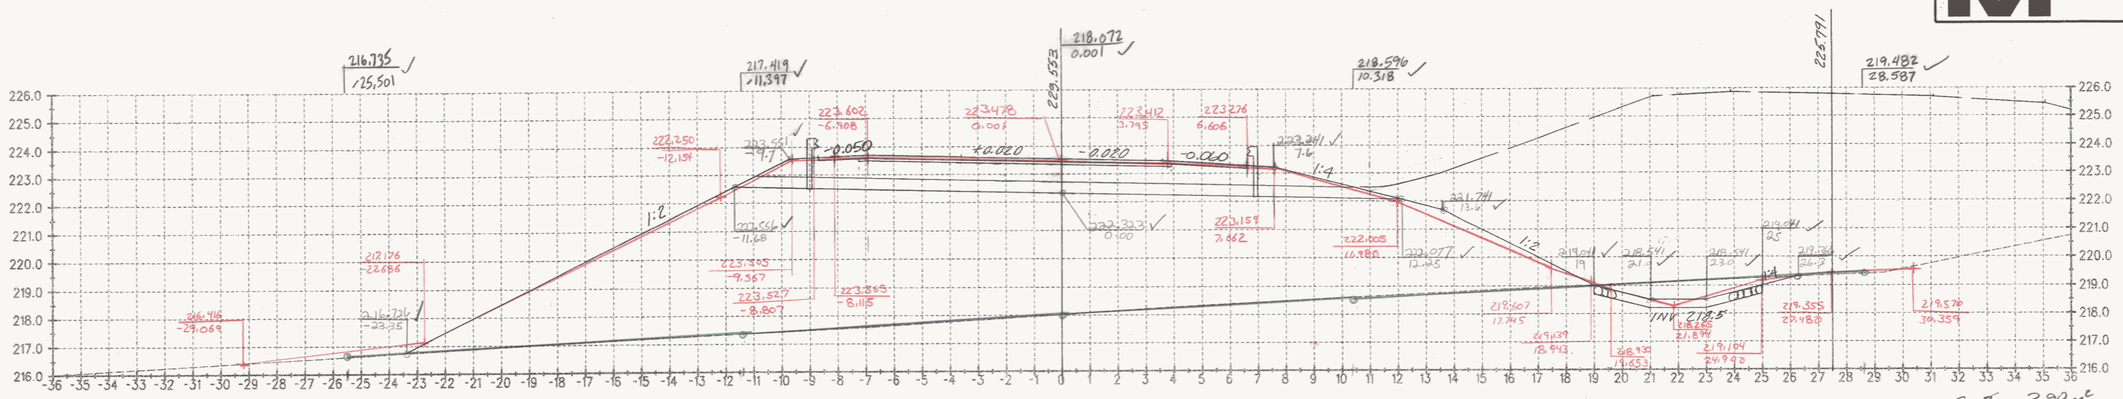


C=3 2.98m²
E=144 144.08m²
R=0

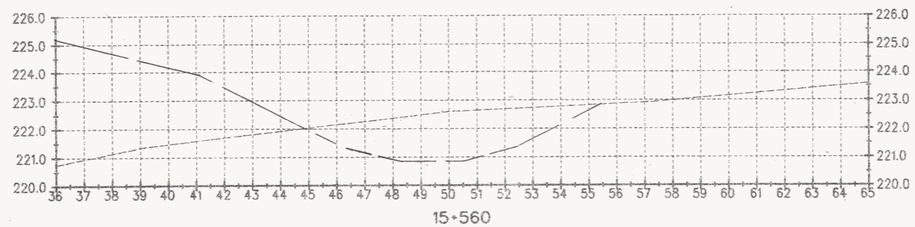


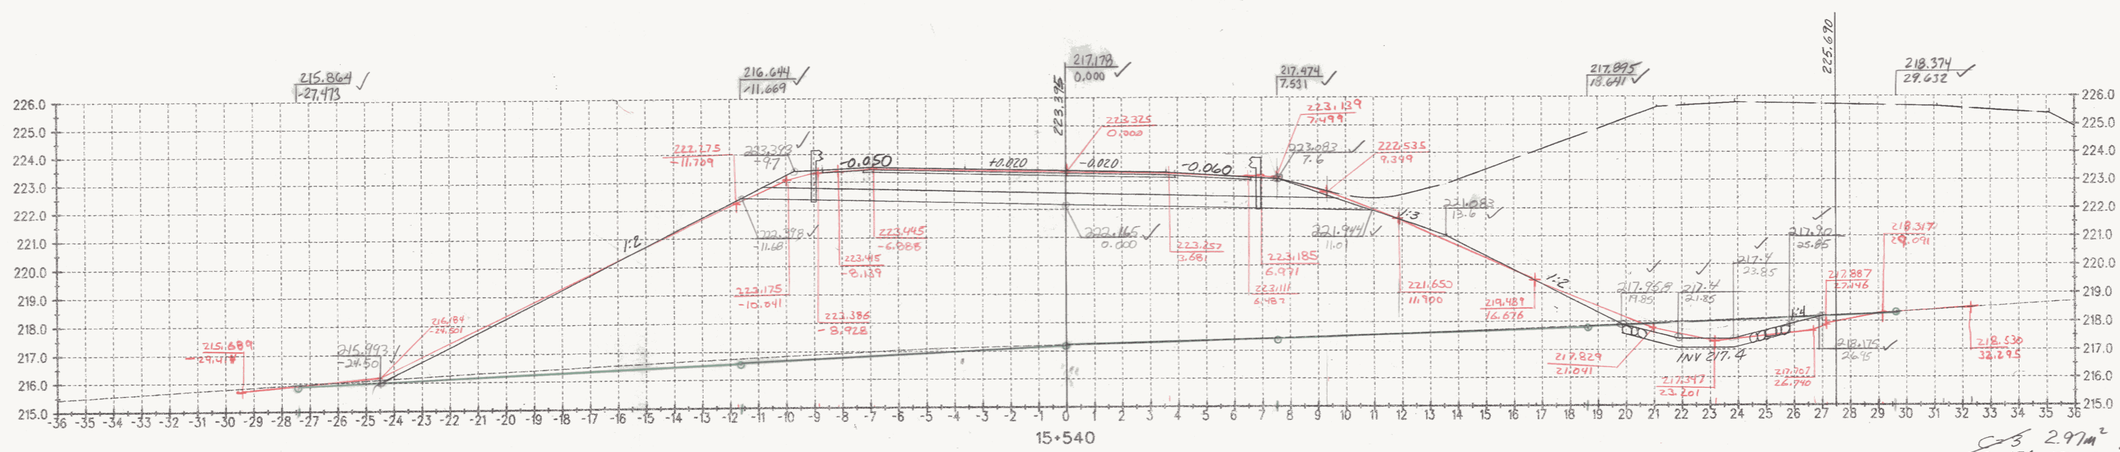


C=3 2.97m²
E=194 170.15m²
R=0

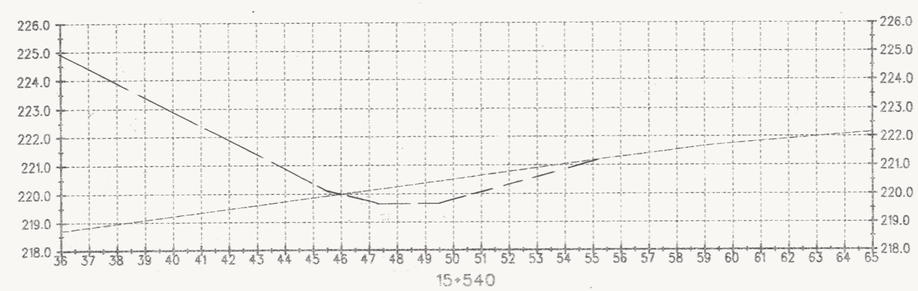


| BOTH SECT'S | BY | ✓ BY |
|---|---|---|
| O.G. | DH 1/14/03 | RRM 2-11-03 |
| TEMP. ELV. + O/S FG | DH 1/14/03 | RRM 2-11-03 |
| | RL 4/22/05 | JPW 1/26/05 |

ALL DIMENSIONS IN MILLIMETERS EXCEPT AS INDICATED

2 0 2 m

H 1:100
V 1:100

SURVEYED BY C.H.A. & V.S.E. DATE
DRAWN BY J.S.L. DATE
SQUAD LEADER T.P.K.
DESIGN FILE NO. N/A
PARM FILE DATE PLOTTED
PROJ. NAME BENNINGTON - HOOSICK D.P.I. 0146(1) C/3
PROJ. NO. P.I.N. 1306.60.201
SHEET 428 OF 473 SHEETS

DATUM
VERTICAL NAVD 88
HORIZONTAL NAD 83 (1992)