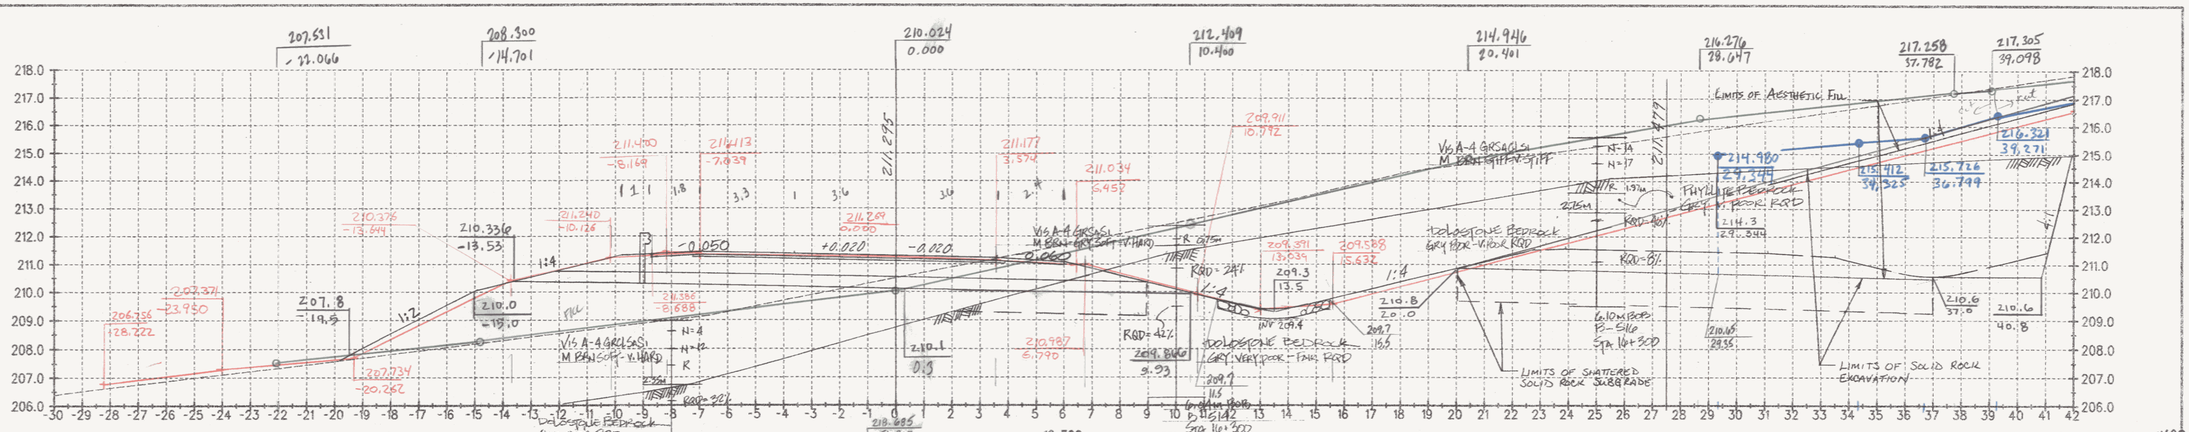

C = 178 108.36+3.56 = 111.92 m²
F = 22 19.98 m²
R = 102 63.74 m²
AESTHETIC FILL = 74 71.86 m²

O.G.	DM 1/18/03	RRM 2/3/03
ROCK	DM 1/19/03	
TEMP. / SHOTS	RRM 2/3/03	
F.G	BC 3/10/05	

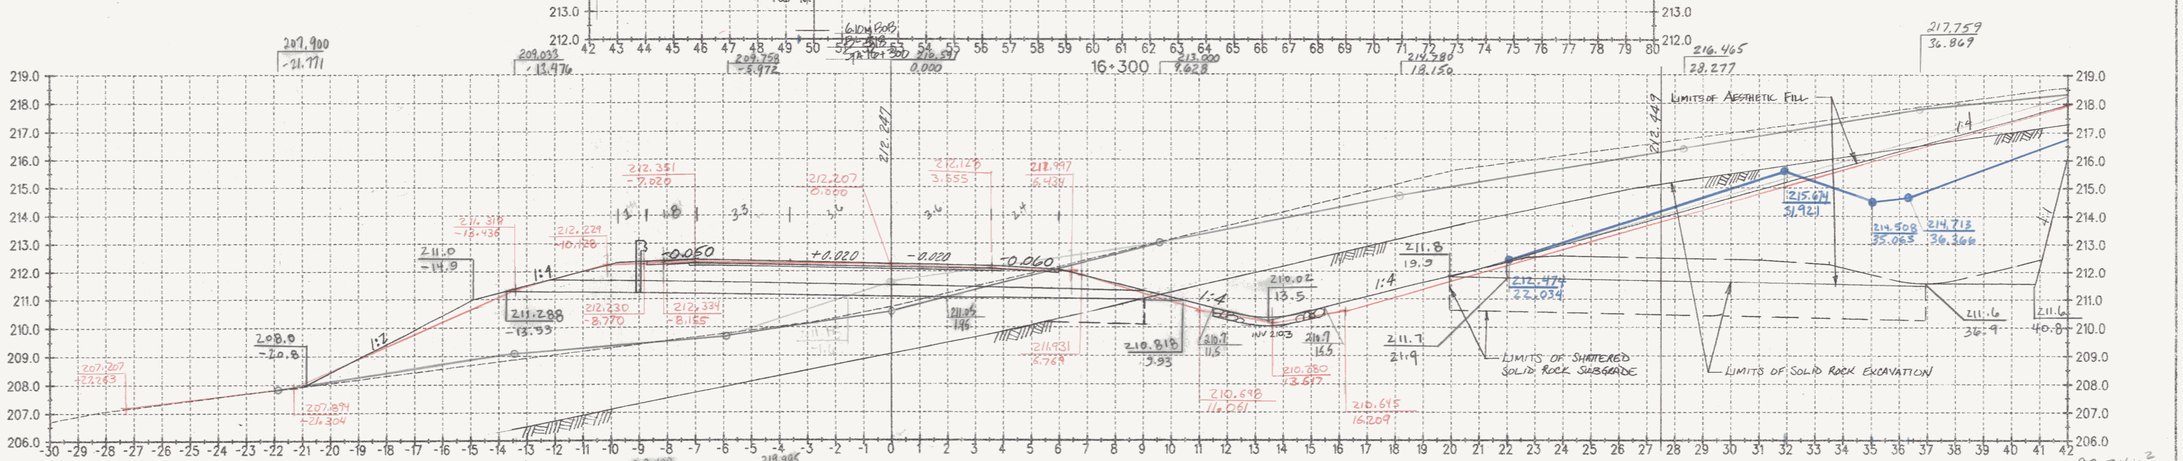

C = 165 98.24 m²
F = 32 29.47 m²
R = 99 53.28 m²
AESTHETIC FILL = 71 76.77 m²

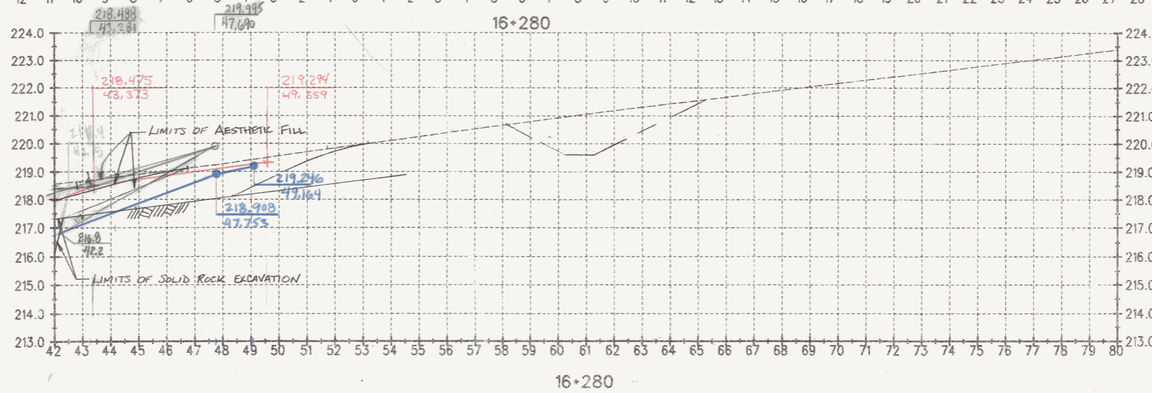

ALL DIMENSIONS IN MILLIMETERS EXCEPT AS INDICATED

2 0 2 m

H 1:100
V 1:100

Metric

DATUM

VERTICAL NAVD 88

HORIZONTAL NAD 83 (1992)

SURVEYED BY C.H.A. & V.S.E. DATE

DRAWN BY J.S.L. DATE

SQUAD LEADER T.P.K.

DESIGN FILE NO. N/A

IPARM FILE DATE PLOTTED

PROJ. NAME BENNINGTON - HOOSICK D.P.I. 0146(1) C/3

PROJ. NO. P.I.N. 1306.60.201

SHEET 445 OF 473 SHEETS