Metric

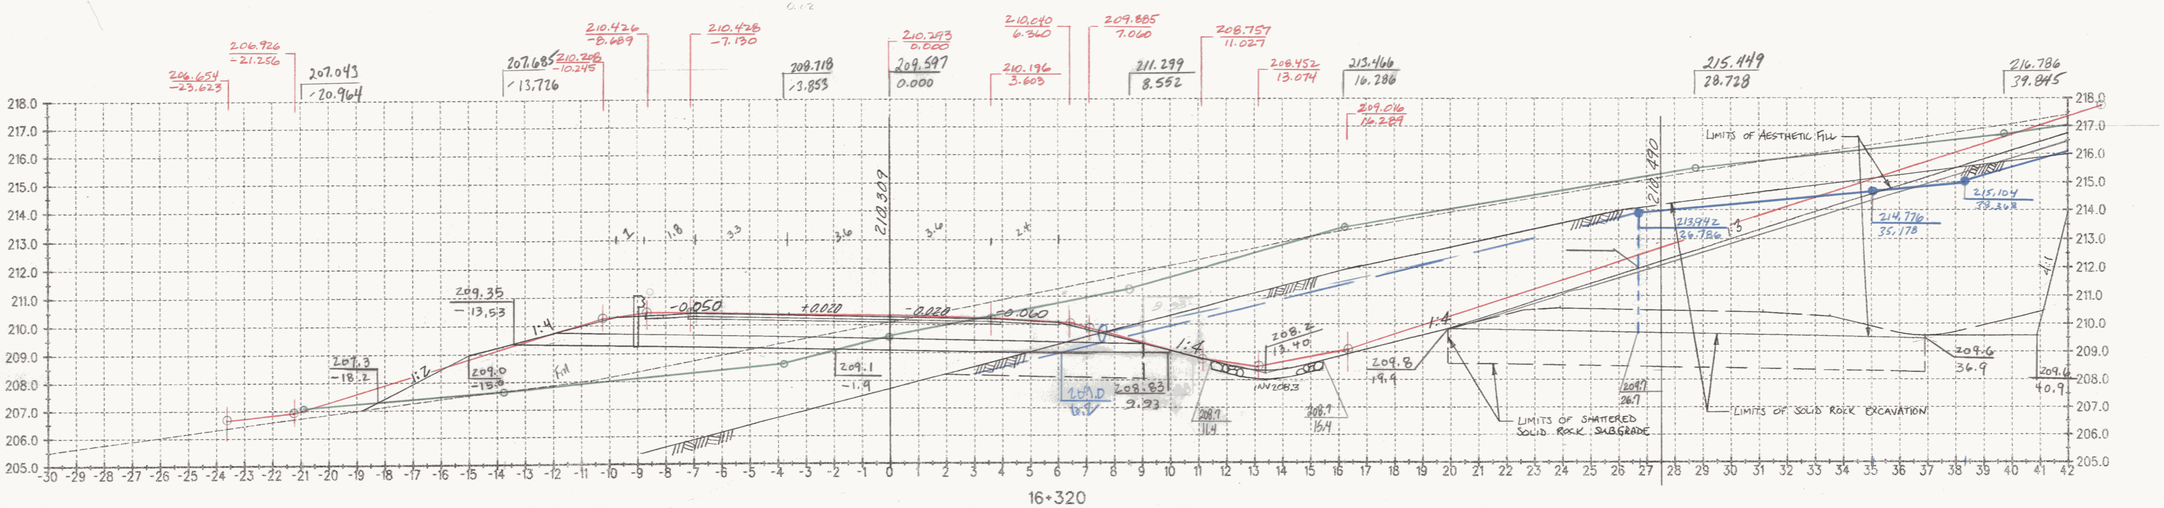

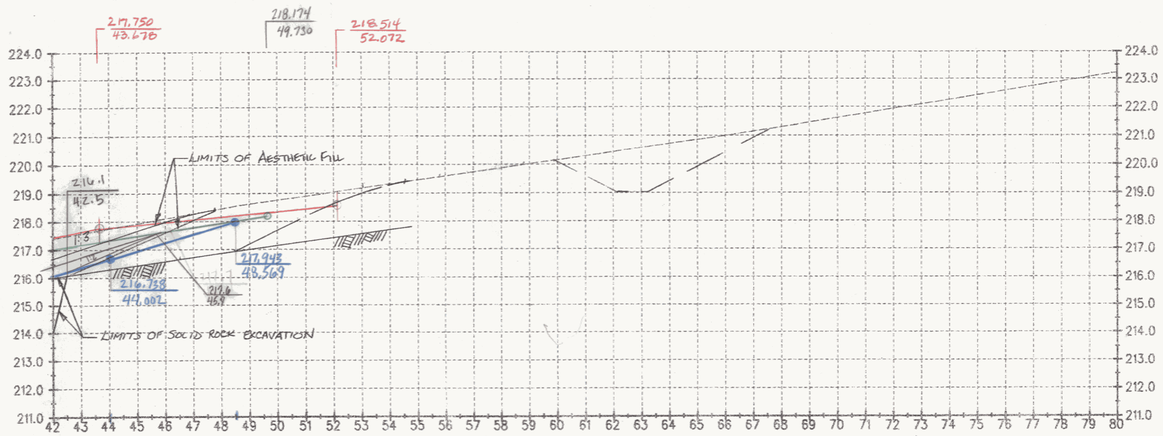

O.G.	DH 1/13/03	
ROCK	DH 1/14/03	
TEMP / SHOT BY RRM 2/3/03		
FG	RMT 4/14/05	✓ 4/14/05 JPM

C = ~~201~~ 141.37 m²
F = ~~15~~ 14.96 m²
R = 135 123.79 m²
AESTHETIC FILL = ~~34~~ 75.85 m²

DATUM
VERTICAL NAVD 88
HORIZONTAL NAD 83 (1992)

ALL DIMENSIONS IN MILLIMETERS EXCEPT AS INDICATED

2 0 2 m
H 1:100
V 1:100

SURVEYED BY C.H.A. & V.S.F. DATE
DRAWN BY J.S.L. DATE
SQUAD LEADER T.P.K.
DESIGN FILE NO. N/A
IPARM FILE DATE PLOTTED
PROJ. NAME BENNINGTON - HOOSICK D.P.I. 0146(1) C13
PROJ. NO. P.I.N. 1306.60.201
SHEET 446 OF 473 SHEETS