Metric

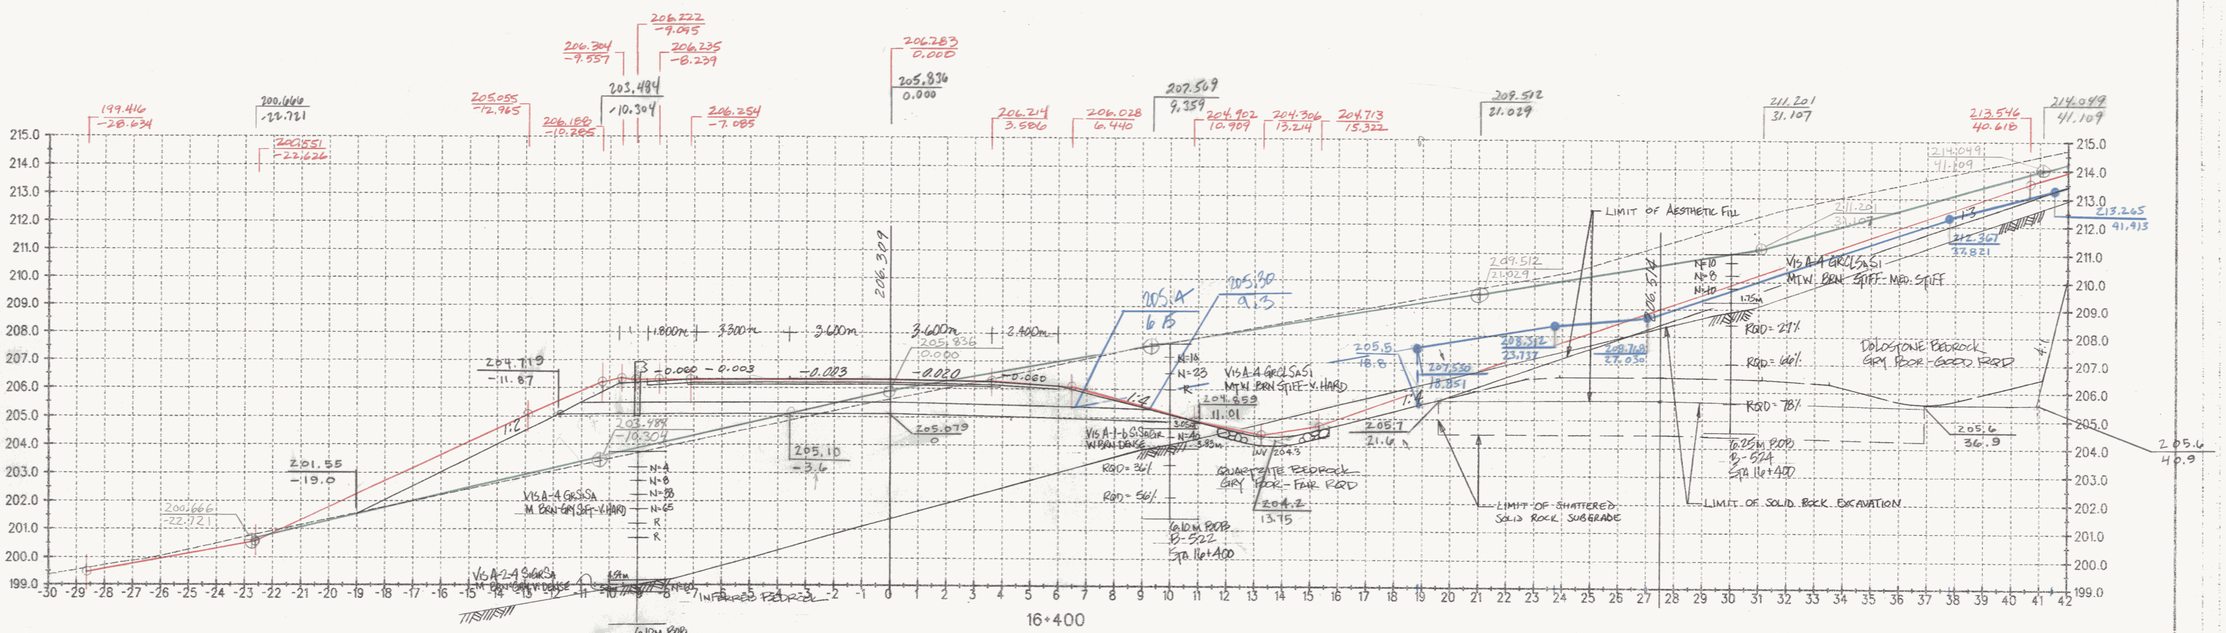

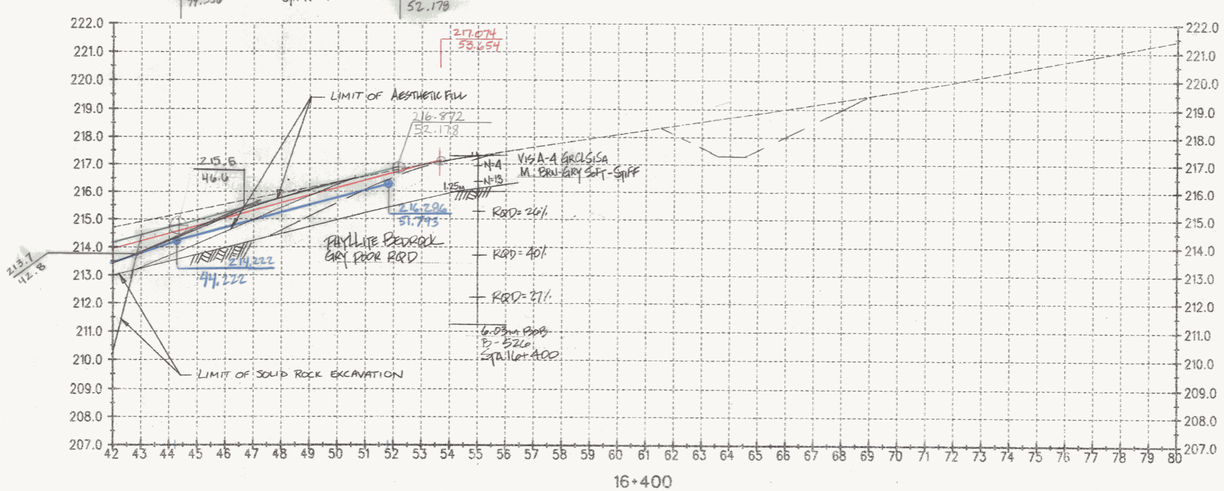

O.G. DH 1/13/03	V RRM	1/30/03
ROCK DH 1/16/03		
TEMP. RRM 1/20/03		
SHOTS BY RRM 1/20/03		
FG. RMT 4/14/05		

JPW 4/14/05

C = ~~205~~
F = ~~16~~
R = ~~87~~ 121.98
AESTHETIC FILL = ~~90~~ 79.40

JPW 2/11/03

Plot By: RD 10-31-02
Check By: JPW

ALL DIMENSIONS IN MILLIMETERS EXCEPT AS INDICATED

2 0 2 m
H 1:100
V 1:100

SURVEYED BY	C.H.A. & V.S.E.	DATE	6/95
DESIGNED BY	D.E.G.	DATE	6/95
DRAWN BY	J.S.L.	DATE	6/95
CHECKED BY	T.P.K.	DATE	6/95

DESIGN FILE NO. N/A

PROJ. NAME BENNINGTON - HOOSICK
D.P.I. 0146(1) C13 STA 16+400

PROJ. NO. P.I.N. 1306.60.201

SHEET 450 OF 473 DWG No. -

DATUM

VERTICAL	NAVD 88
HORIZONTAL	NAD 83 (1992)