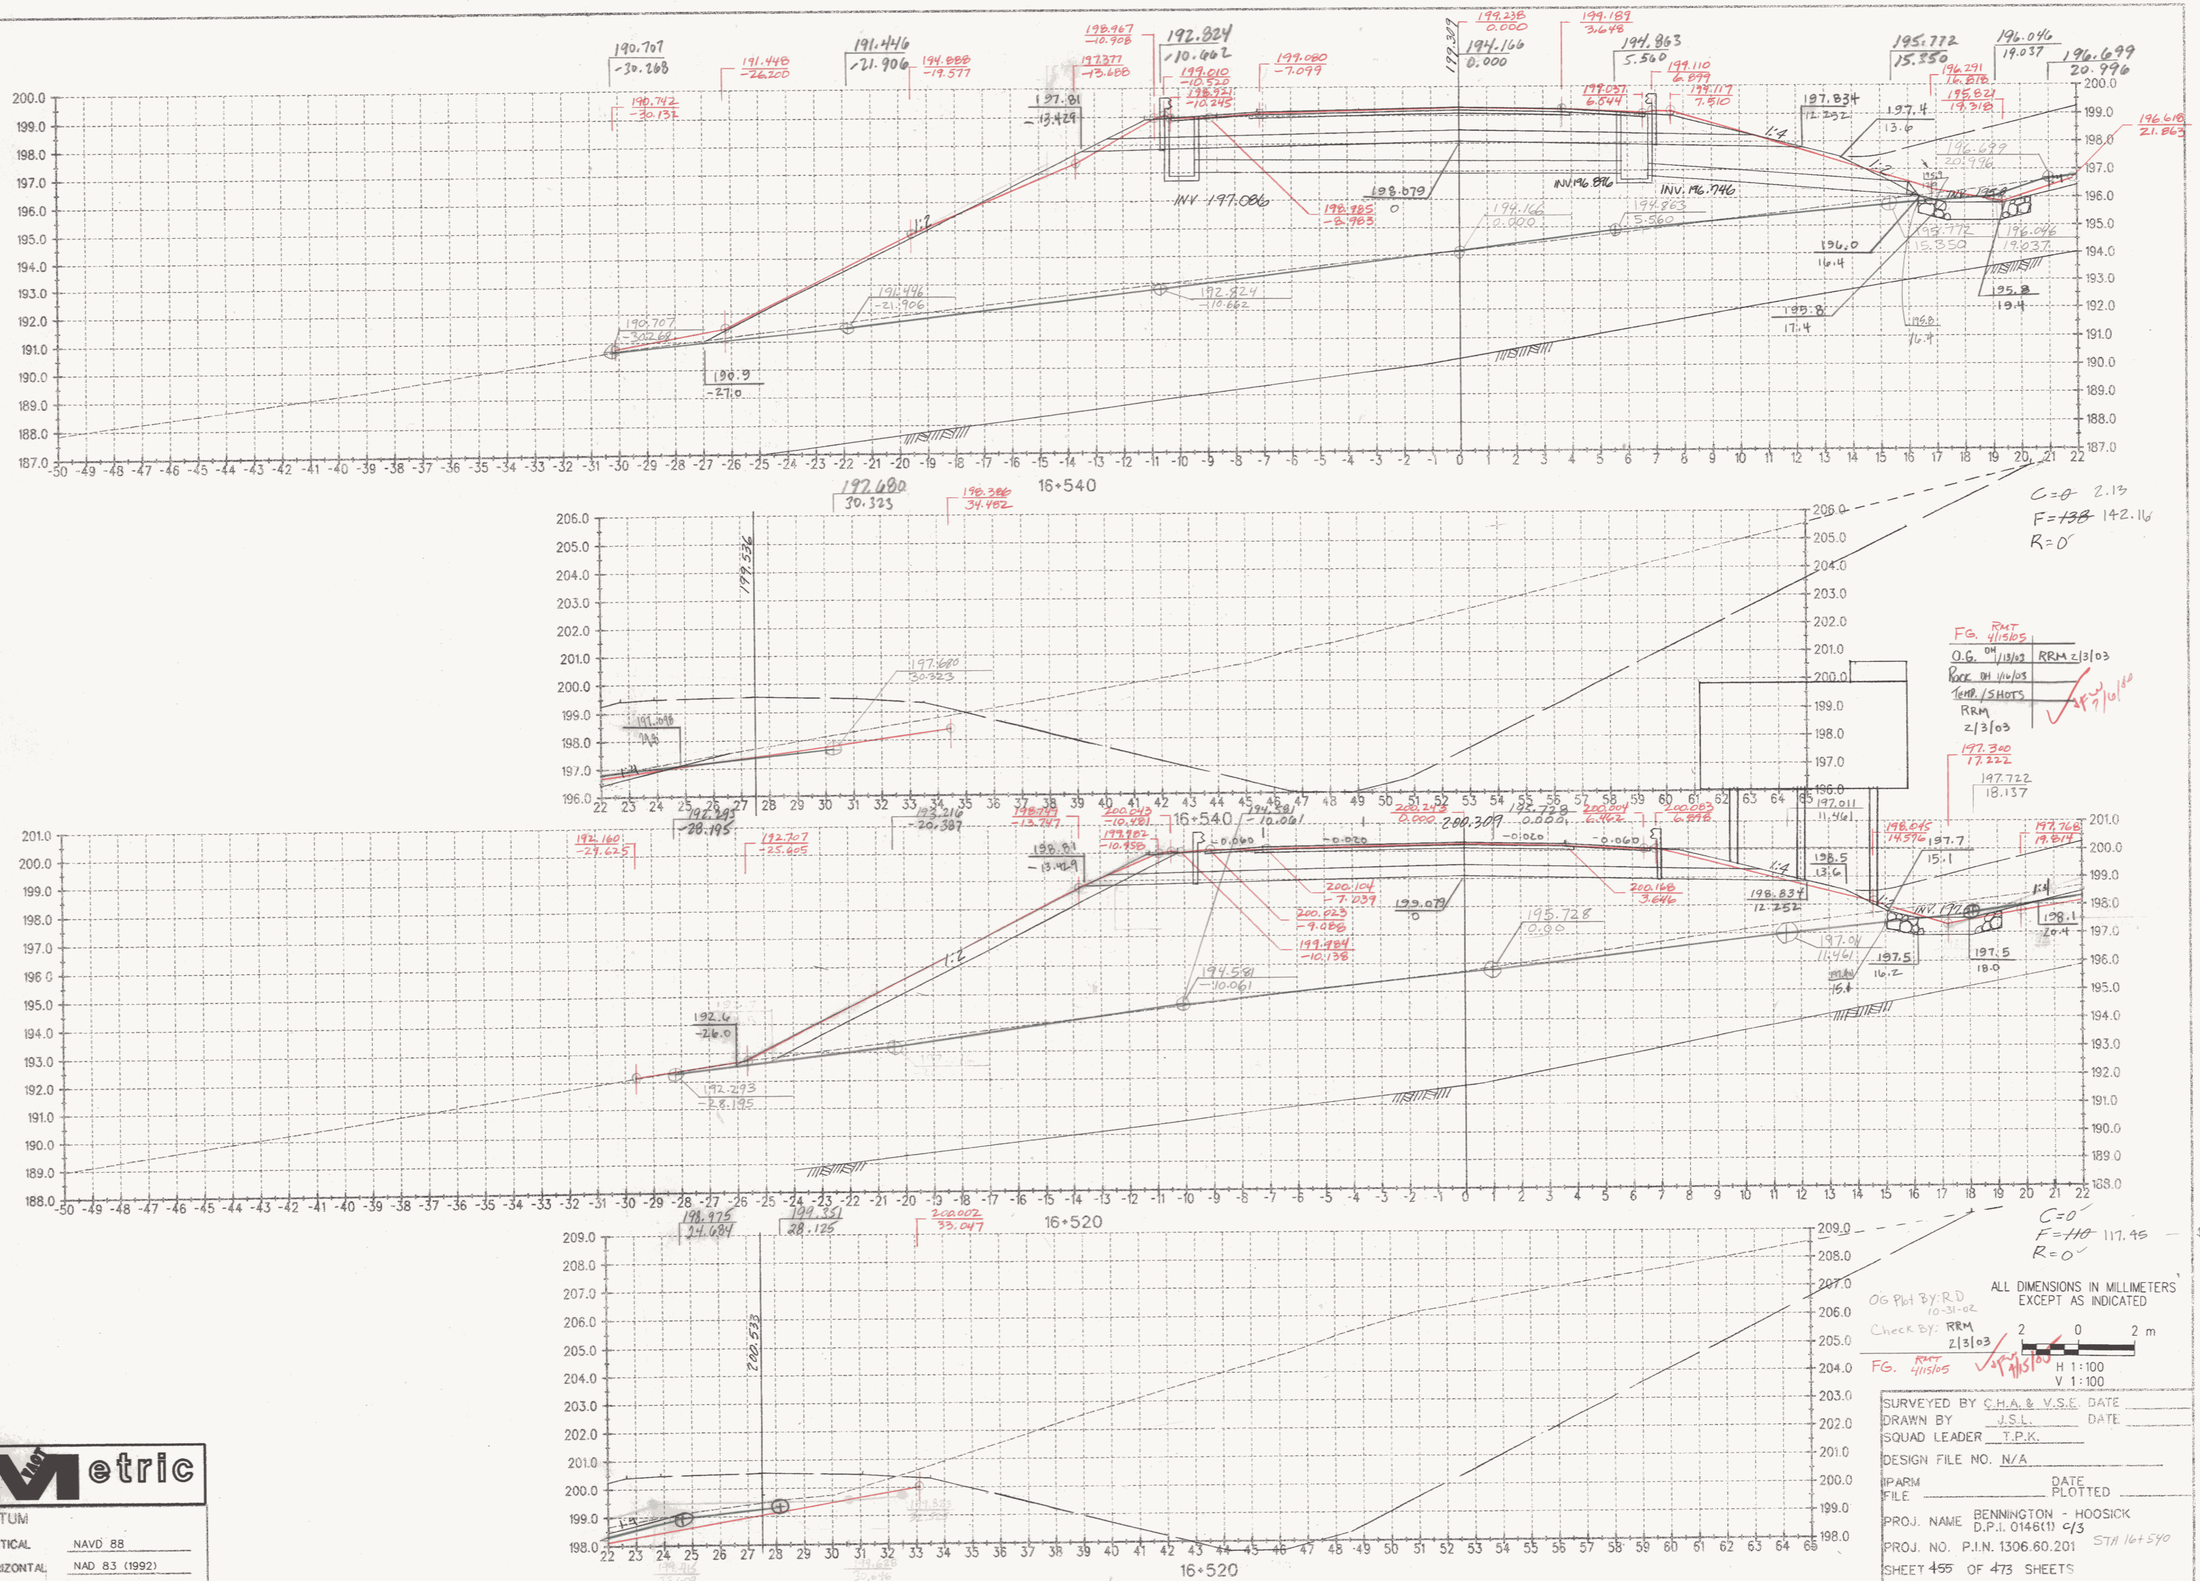
16+540
16+520
INV. 197.086
INV. 196.896
INV. 196.746
C=0 2.13
F=~~138~~ 142.16
R=0
C=0
F=~~110~~ 117.45
R=0
FG. RMT 4/15/05
O.G. DH 1/13/03 RRM 2/3/03
ROCK DH 1/10/03
TEMP./SHOTS
RRM 2/3/03
OG Plot By: R.D. 10-31-02
Check By: RRM 2/3/03
FG. RMT 4/15/05
ALL DIMENSIONS IN MILLIMETERS EXCEPT AS INDICATED
2 0 2 m
H 1:100
V 1:100
SURVEYED BY C.H.A. & V.S.E. DATE
DRAWN BY J.S.L. DATE
SQUAD LEADER T.P.K.
DESIGN FILE NO. N/A
IPARM FILE
DATE PLOTTED
PROJ. NAME BENNINGTON - HOOSICK D.P.I. 0146(1) 6/3
PROJ. NO. P.I.N. 1306.60.201
STA 16+540
SHEET 455 OF 473 SHEETS
Metric
DATUM
VERTICAL NAVD 88
HORIZONTAL NAD 83 (1992)