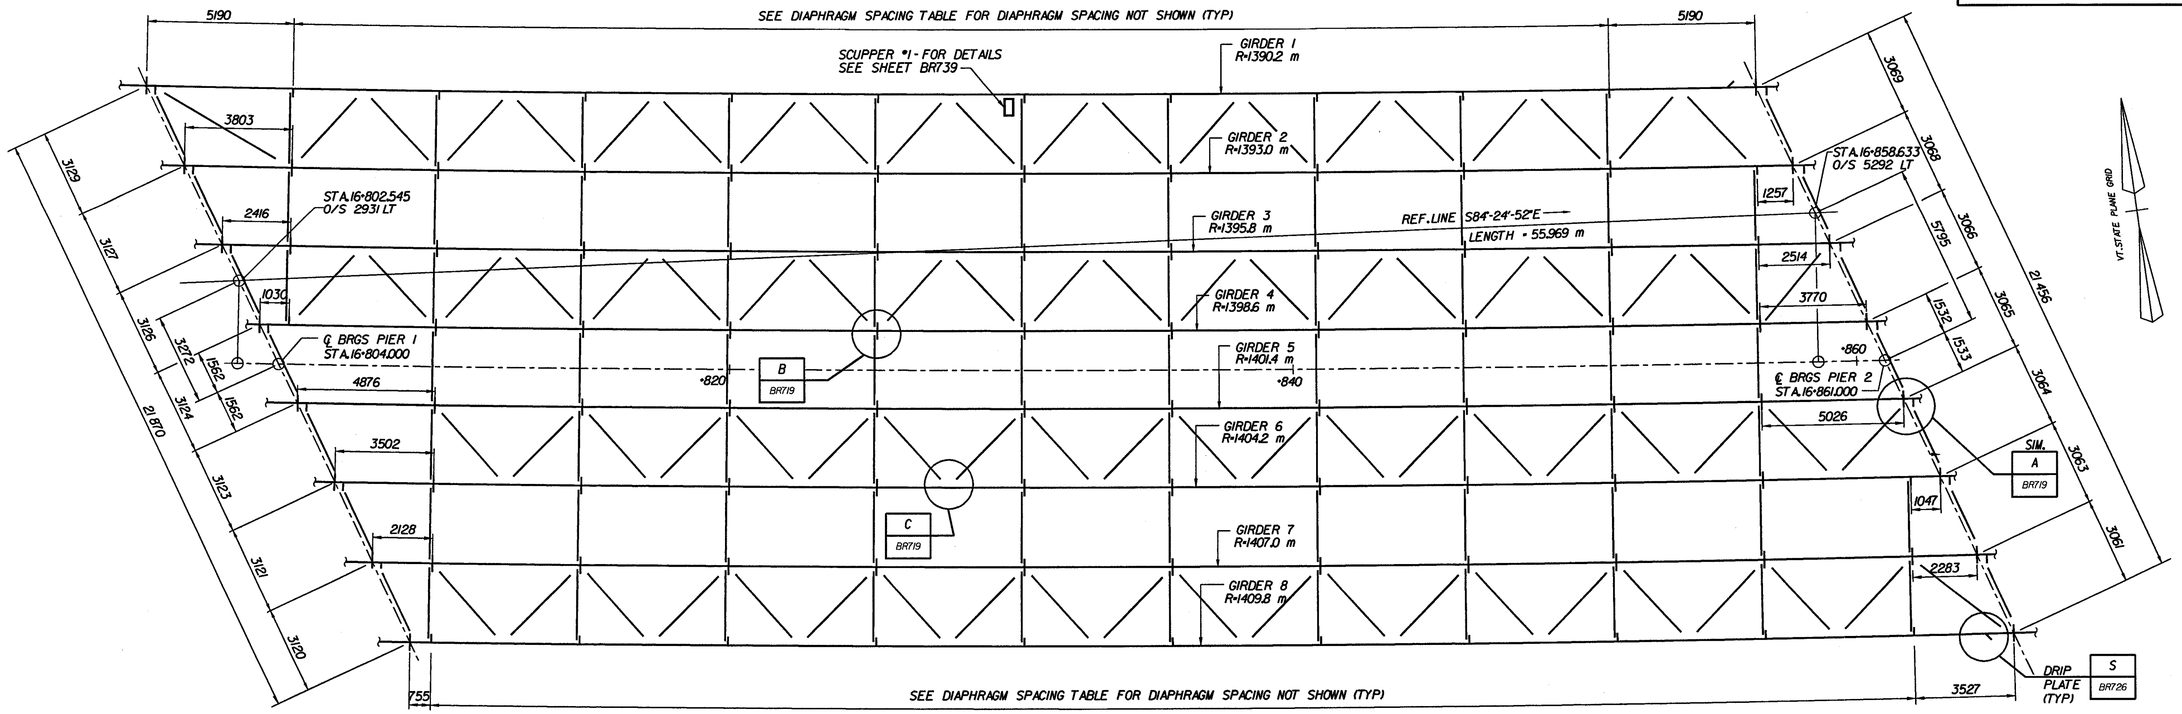

FRAMING PLAN - SPAN 2

2 m 0 2 m

1:100

DIAPHRAGM SPACING TABLE	
GIRDER NO.	DIAPHRAGM SPACING (m)
1	9 EQ. SP. = 46.709
2	10 EQ. SP. = 52.004
3	10 EQ. SP. = 52.108
4	10 EQ. SP. = 52.213
5	9 EQ. SP. = 47.085
6	10 EQ. SP. = 52.413
7	10 EQ. SP. = 52.527
8	10 EQ. SP. = 52.631

STATE OF VERMONT
AGENCY OF TRANSPORTATION

Town Of BENNINGTON	Bridge No. BR700
Highway No. VT. RTE. 9	Log Sta. 16+00
	Surv. Sta. 51+00

VT. RTE. OVER SILK ROAD AND WALLOOMSAC RIVER

FRAMING PLAN - SPAN 2

Designed By D. VIENI	Drawn by B. WEATHERBY
Checked By M. SCARDINO Date 6/00	Bridge Design Supervisor M.W. OLSTAD Date 9/00
PROJECT BENNINGTON-HOOSICK	PROJECT NO. D.P.I. 0146(1) C/4
I.G.C. Info.	
Bridge Sheet No. BR720	Sheet 203 OF 385

CLOUGH, HARBOUR & ASSOCIATES LLP
ENGINEERS, SURVEYORS, PLANNERS & LANDSCAPE ARCHITECTS
11 WINNERS CIRCLE ALBANY, NEW YORK, 12205