VAOT Metric

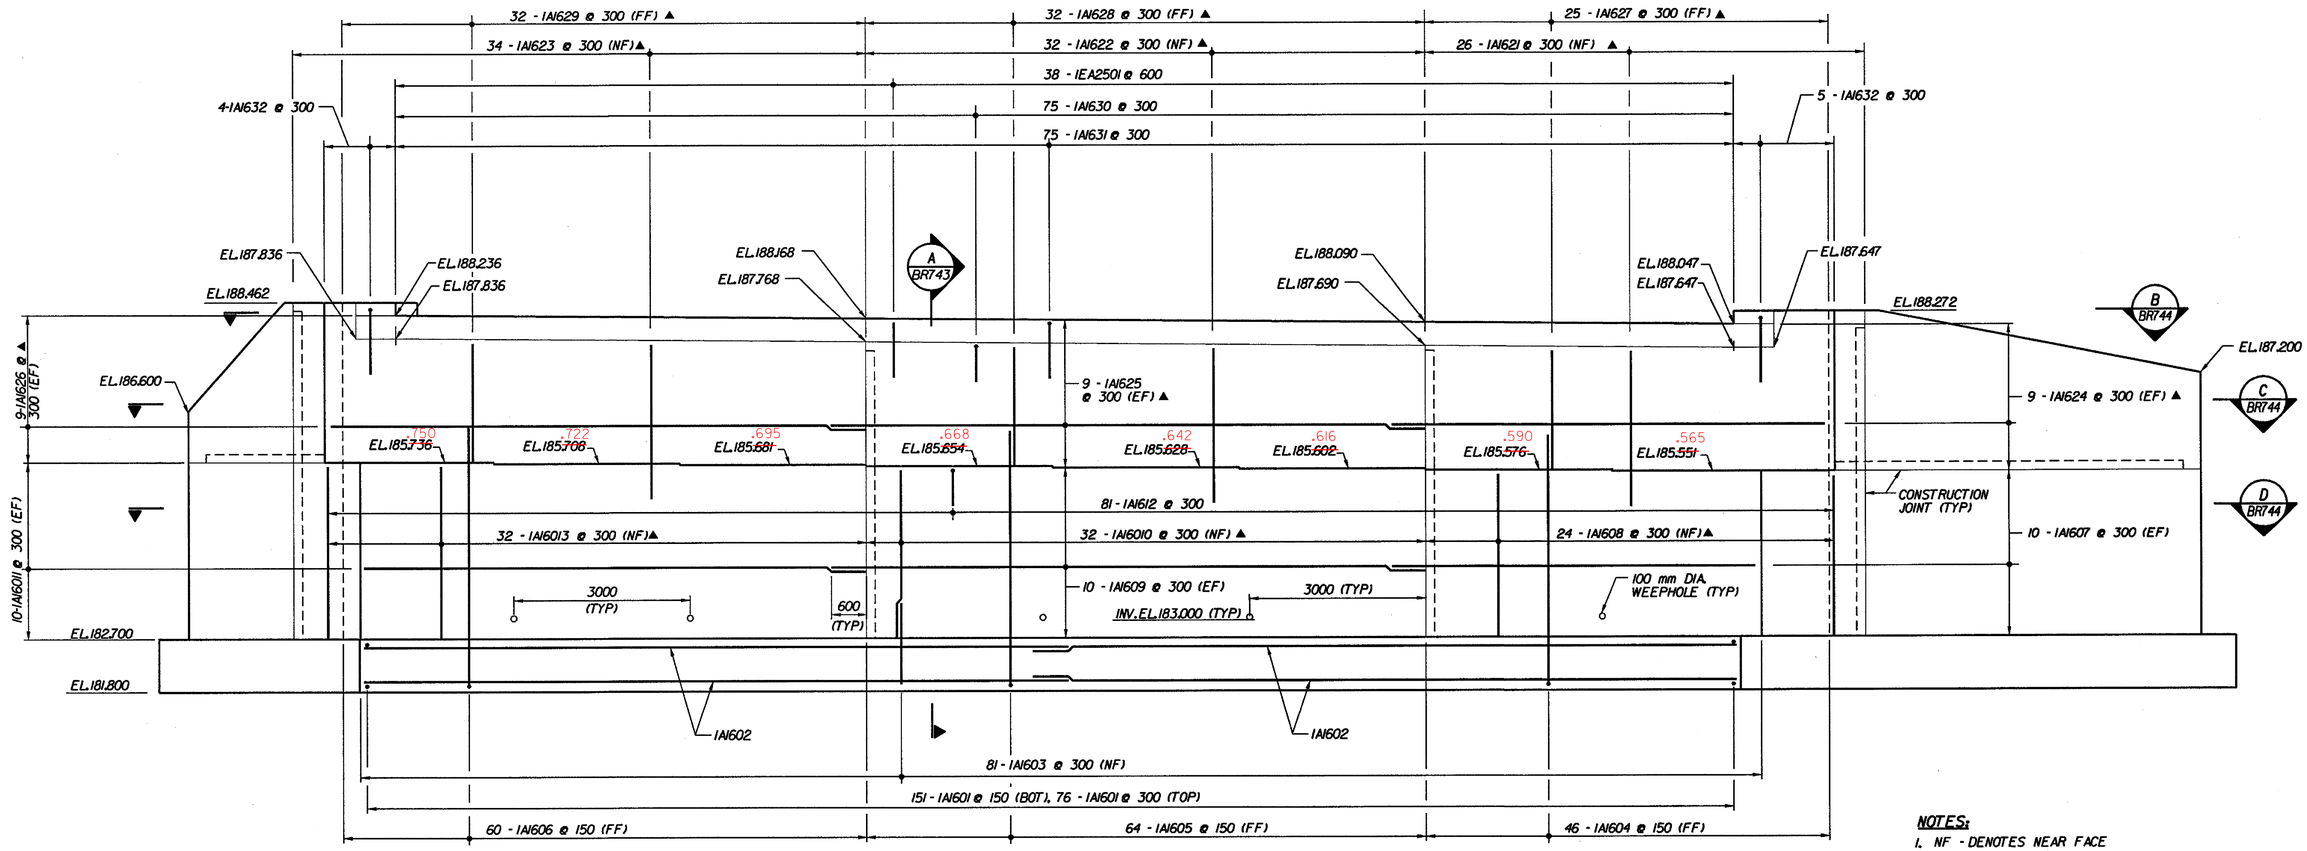

ELEVATION

1m 0 1m

1:50

NOTES:

1. NF - DENOTES NEAR FACE
2. FF - DENOTES FAR FACE
3. EF - DENOTES EACH FACE
4. FOR WEEPHOLE DETAILS, SEE BR743.
5. ▲ INDICATES BAR TO BE CUT IN FIELD.

STATE OF VERMONT
AGENCY OF TRANSPORTATION

Town Of BENNINGTON	Bridge No. BR700 / Log Sta.
Highway No. VT. RTE. 9	Surv. Sta. 16+800
VT. RTE. 9 OVER SILK ROAD AND WALLOOMSAC RIVER	
ABUTMENT 1 ELEVATION	
Designed By C. TUTUNJIAN	Drawn by B. WEATHERBY
Checked By L. AVERY Date 6/00	Bridge Design Supervisor M. OLSTAD Date 9/00
PROJECT BENNINGTON-HOOSICK	PROJECT NO. D.P.I. 0146(1) C/4
I.G.C. Info.	
Bridge Sheet No. BR741	Sheet 224 OF 385

CHA CLOUGH, HARBOUR & ASSOCIATES LLP
ENGINEERS, SURVEYORS, PLANNERS & LANDSCAPE ARCHITECTS
111 WINNERS CIRCLE ALBANY, NEW YORK, 12205

U:\357-5\BR700-NEL01\BM/3\120000/ 1:50