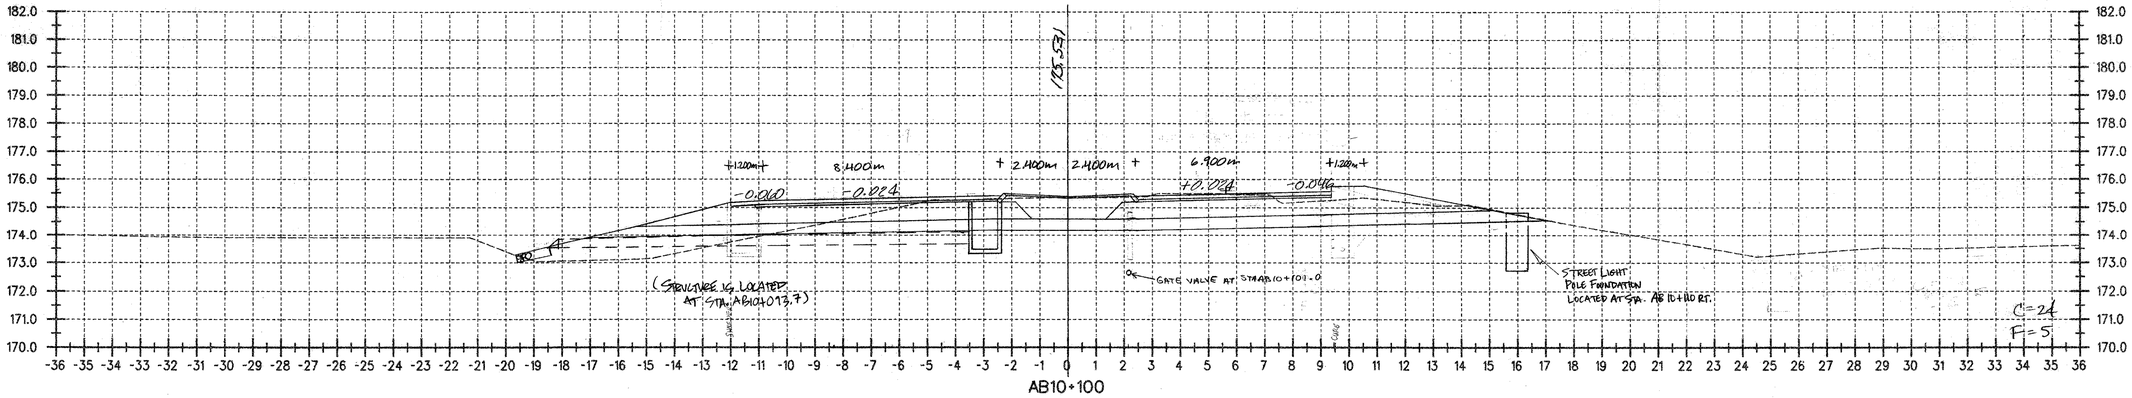

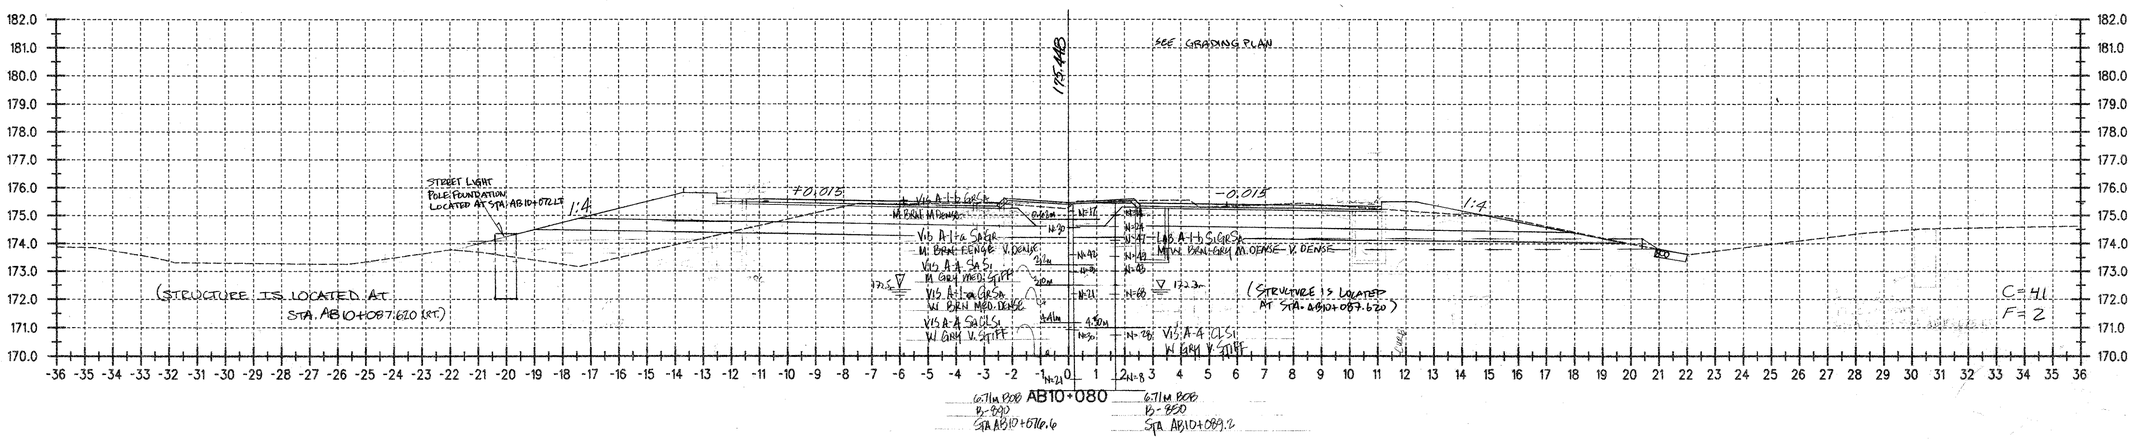

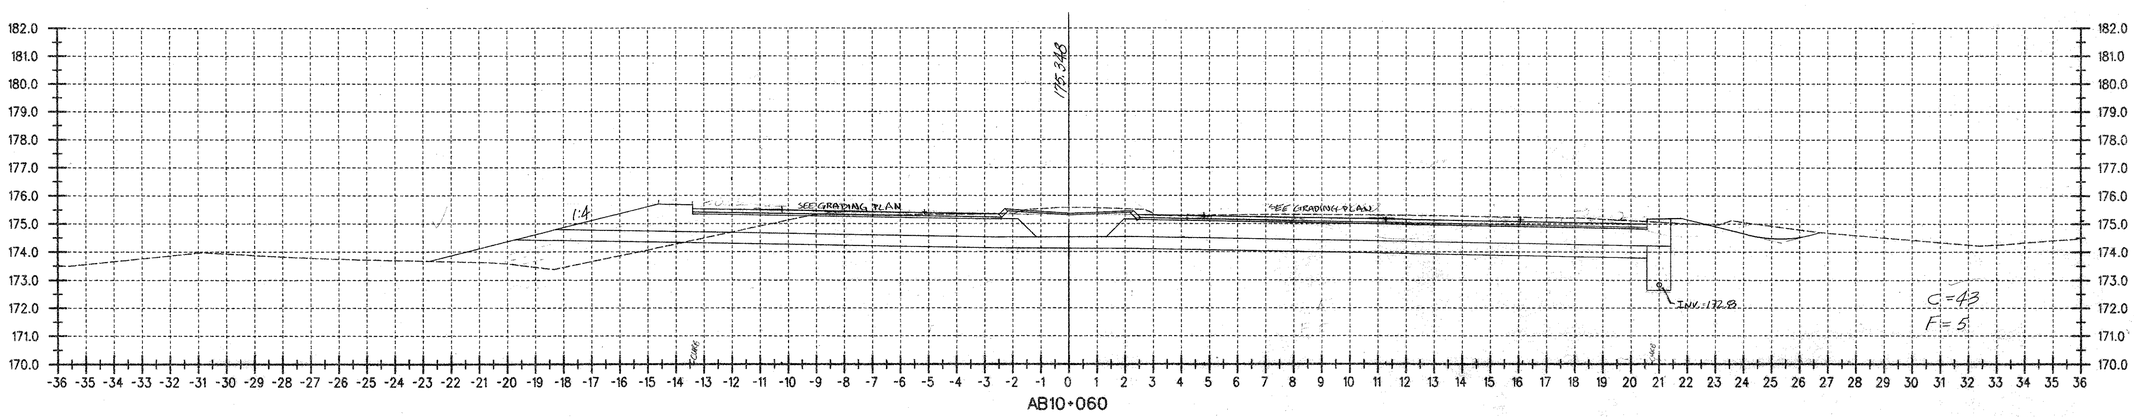

Metric

DATUM

VERTICAL	NAVD 88
HORIZONTAL	NAD 83 (1992)

ALL DIMENSIONS IN MILLIMETERS EXCEPT AS INDICATED

2 0 2 m

H 1:100

V 1:100

SURVEYED BY C.H.A. & V.S.E. DATE

DRAWN BY J.S.L. DATE

SQUAD LEADER T.P.K.

DESIGN FILE NO. N/A

IPARM FILE DATE PLOTTED

PROJ. NAME BENNINGTON - HOOSICK D.P.I. 0146(1) C/4

PROJ. NO. P.I.N. 1306.60.101

SHEET 315 OF 385 SHEETS