Metric

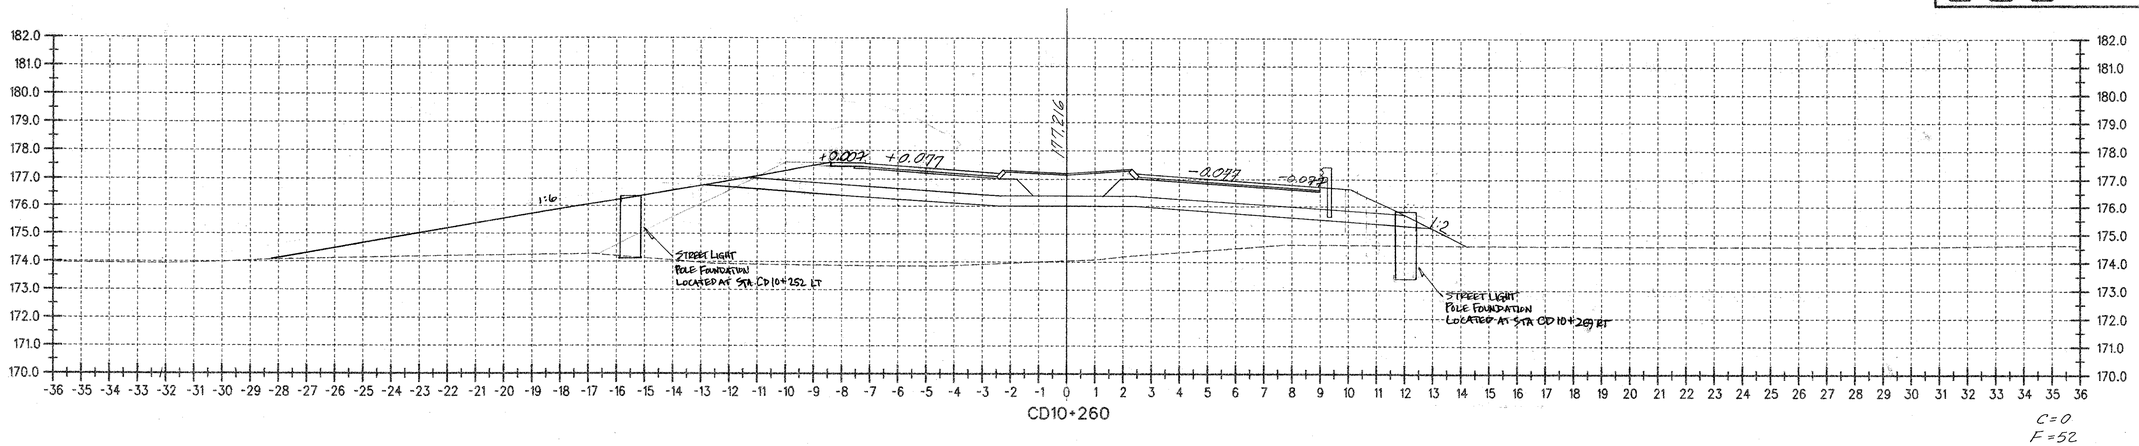

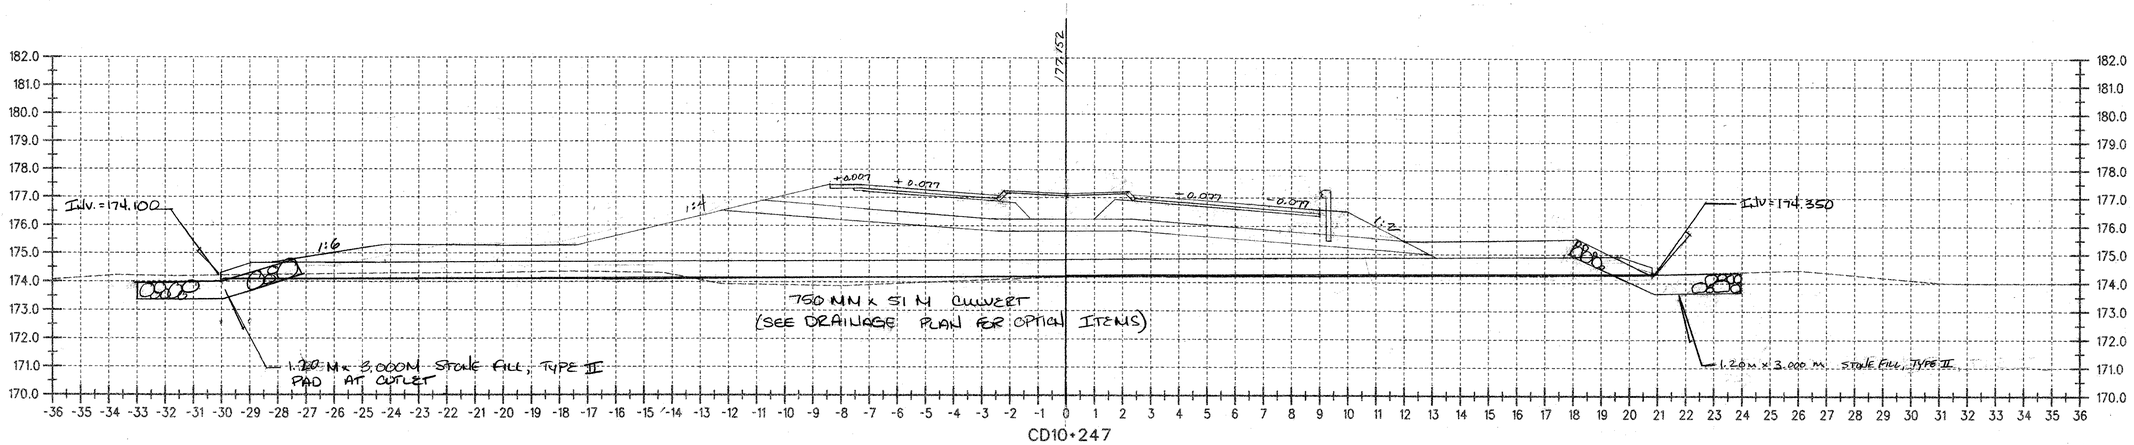

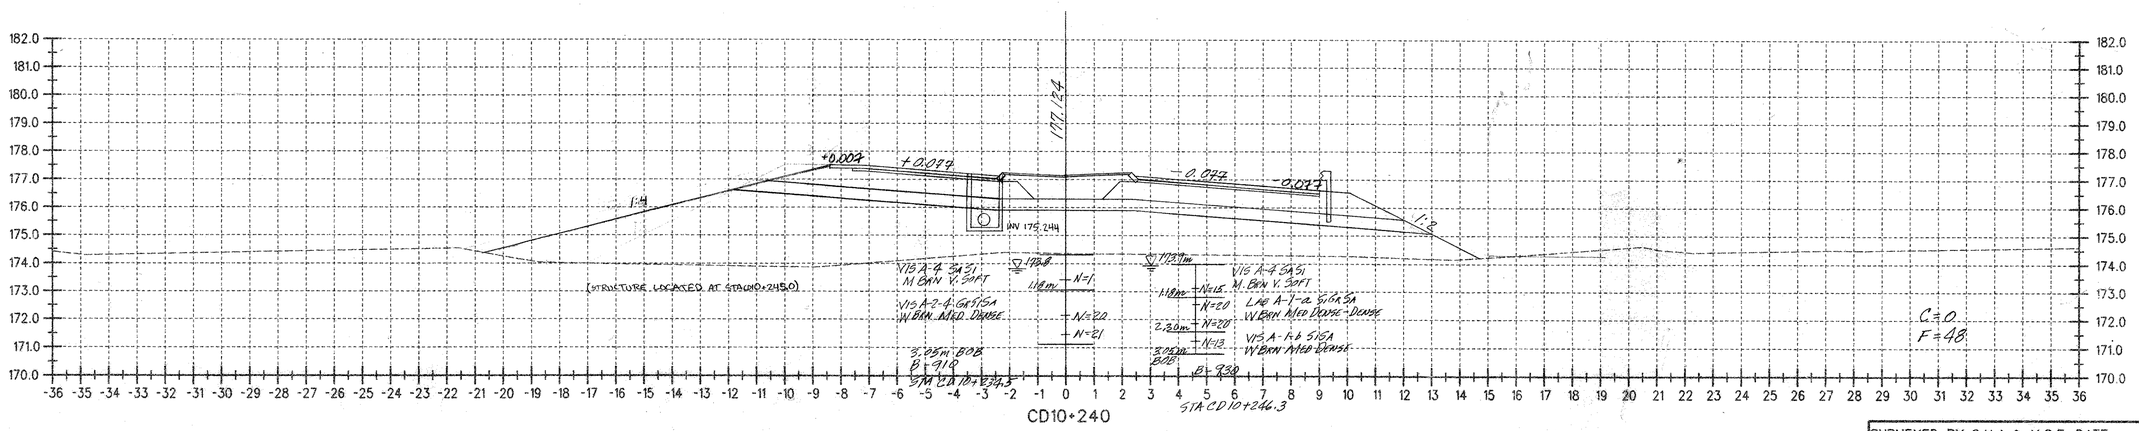

DATUM	
VERTICAL	NAVD 88
HORIZONTAL	NAD 83 (1992)

ALL DIMENSIONS IN MILLIMETERS EXCEPT AS INDICATED

2 0 2 m

H 1:100
V 1:100

SURVEYED BY C.H.A. & V.S.E. DATE _____
DRAWN BY J.S.L. DATE _____
SQUAD LEADER T.P.K.
DESIGN FILE NO. N/A
IPARM FILE _____ DATE PLOTTED _____
PROJ. NAME BENNINGTON - HOOSICK D.P.I. 0146(1) C/4
PROJ. NO. P.I.N. 1306.60.101
SHEET 333 OF 385 SHEETS