646.403 DURABLE 4 INCH WHITE LINE, EPOXY PAINT
STA. 284+50 - STA. 300+50 (SOLID LT & RT)
(WITH EDGELINE BREAKS AT TOWN ROADS)
STA. 285+09 RT (EDGELINES, TH# 12)

646.413 DURABLE 4 INCH YELLOW LINE, EPOXY PAINT
STA. 284+50 - STA. 300+50 (SOLID LT & RT)
(WITH CENTERLINE BREAKS AT TOWN ROADS)
STA. 285+09 RT (CENTERLINE, TH# 12)

646.482 DURABLE 24 INCH STOP BAR, THERMOPLASTIC
STA. 285+09 RT - STA. 285+26 RT (TH# 12)

646.492 DURABLE LETTER OR SYMBOL, THERMOPLASTIC
STA. 285+20 RT "STOP" (TH# 12)

646.602 TEMPORARY 4 INCH WHITE LINE, PAINT
STA. 284+50 - STA. 300+50 (SOLID LT & RT)
(WITH EDGELINE BREAKS AT TOWN ROADS)
STA. 285+09 RT (EDGELINES, TH# 12)

646.612 TEMPORARY 4 INCH YELLOW LINE, PAINT
STA. 284+50 - STA. 300+50 (SOLID LT & RT)
(WITH CENTERLINE BREAKS AT TOWN ROADS)
STA. 285+09 RT (CENTERLINE, TH# 12)

646.682 TEMPORARY 24 INCH STOP BAR, PAINT
STA. 285+09 RT - STA. 285+26 RT (TH# 12)

646.692 TEMPORARY LETTER OR SYMBOL, PAINT
STA. 285+20 RT "STOP" (TH# 12)

675.50 REMOVING SIGNS
AS SHOWN - 3

675.60 ERECTING SALVAGED SIGNS
AS SHOWN - 1

604.412 REHAB. DROP INLETS, CATCH BASINS, OR MANHOLES, CLASS I
STA. 288+65 LT
STA. 290+15 LT
STA. 293+64 LT
STA. 296+59 LT

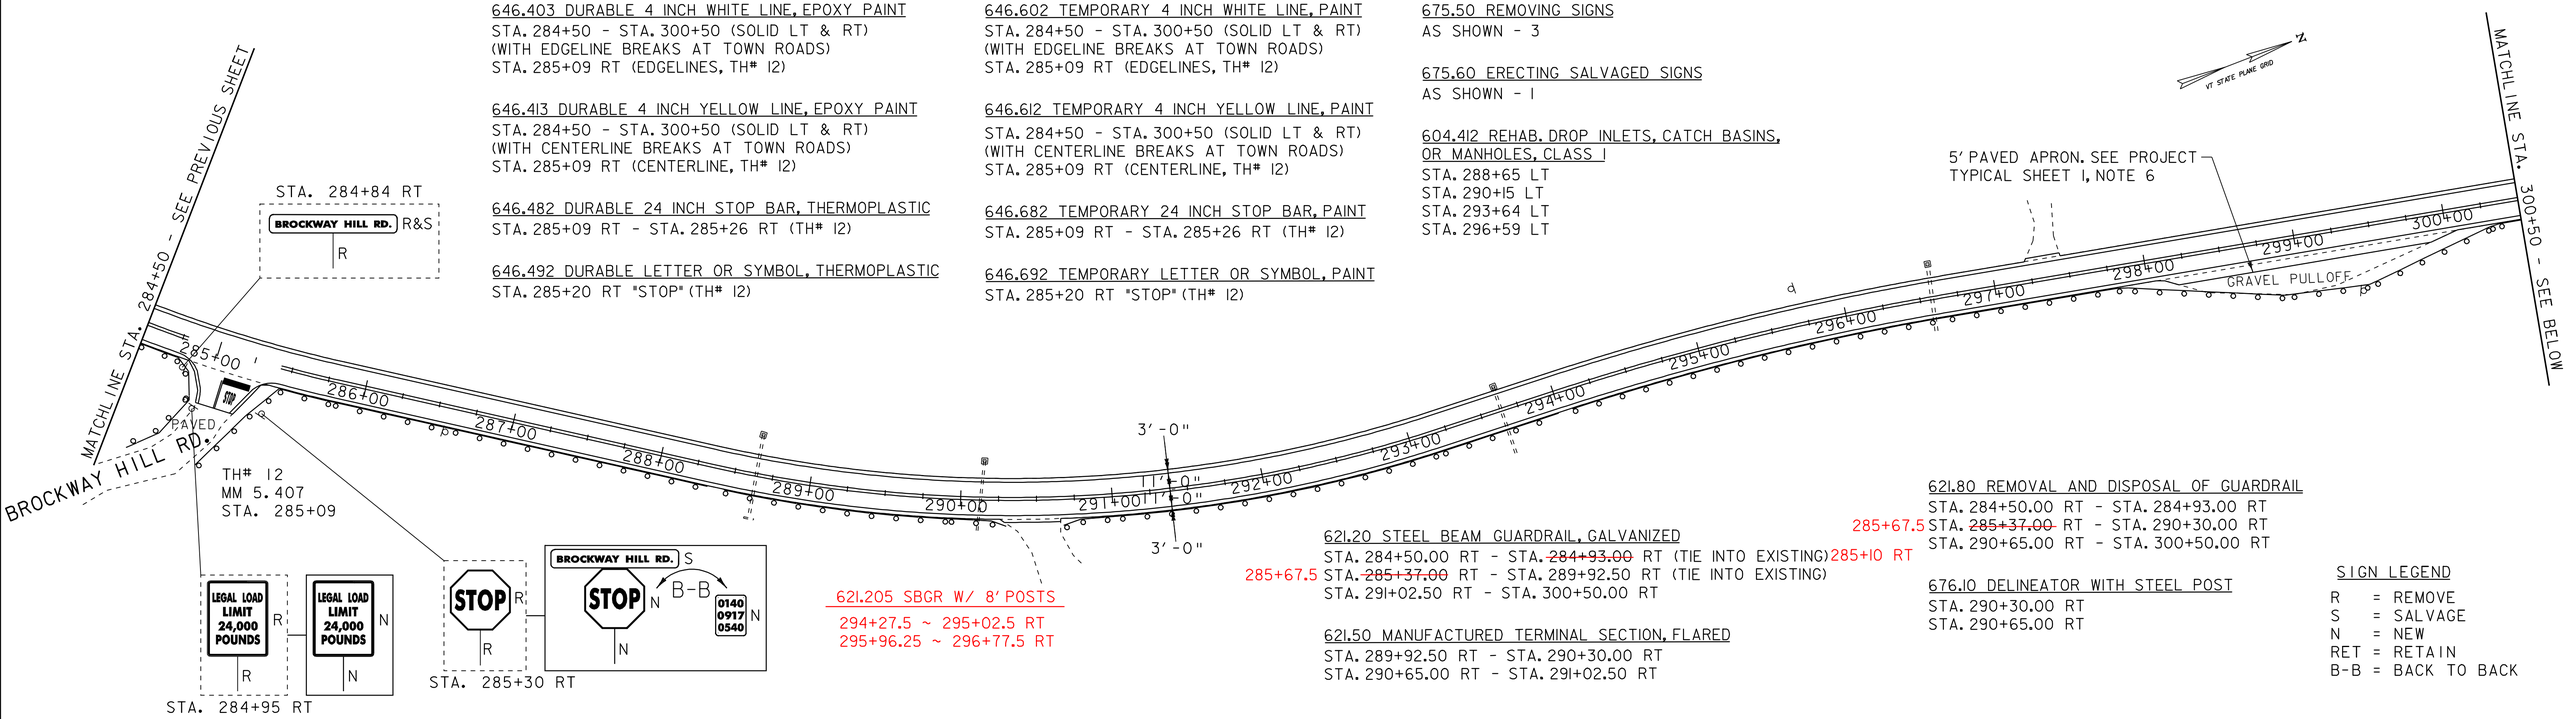

646.403 DURABLE 4 INCH WHITE LINE, EPOXY PAINT
STA. 300+50 - STA. 315+50 (SOLID LT & RT)
(WITH EDGELINE BREAKS AT TOWN ROADS)
STA. 305+43 LT (EDGELINES, TH# 8)

646.413 DURABLE 4 INCH YELLOW LINE, EPOXY PAINT
STA. 300+50 - STA. 315+50 (SOLID LT & RT)
(WITH CENTERLINE BREAKS AT TOWN ROADS)
STA. 305+43 LT (CENTERLINE, TH# 8)

646.482 DURABLE 24 INCH STOP BAR, THERMOPLASTIC
STA. 305+20 LT - STA. 305+43 LT (TH# 8)

646.492 DURABLE LETTER OR SYMBOL, THERMOPLASTIC
STA. 305+30 LT "STOP" (TH# 8)

646.602 TEMPORARY 4 INCH WHITE LINE, PAINT
STA. 300+50 - STA. 315+50 (SOLID LT & RT)
(WITH EDGELINE BREAKS AT TOWN ROADS)
STA. 305+43 LT (EDGELINES, TH# 8)

646.612 TEMPORARY 4 INCH YELLOW LINE, PAINT
STA. 300+50 - STA. 315+50 (SOLID LT & RT)
(WITH CENTERLINE BREAKS AT TOWN ROADS)
STA. 305+43 LT (CENTERLINE, TH# 8)

646.682 TEMPORARY 24 INCH STOP BAR, PAINT
STA. 305+20 LT - STA. 305+43 LT (TH# 8)

646.692 TEMPORARY LETTER OR SYMBOL, PAINT
STA. 305+30 LT "STOP" (TH# 8)

675.50 REMOVING SIGNS
AS SHOWN - 4

675.60 ERECTING SALVAGED SIGNS
AS SHOWN - 2

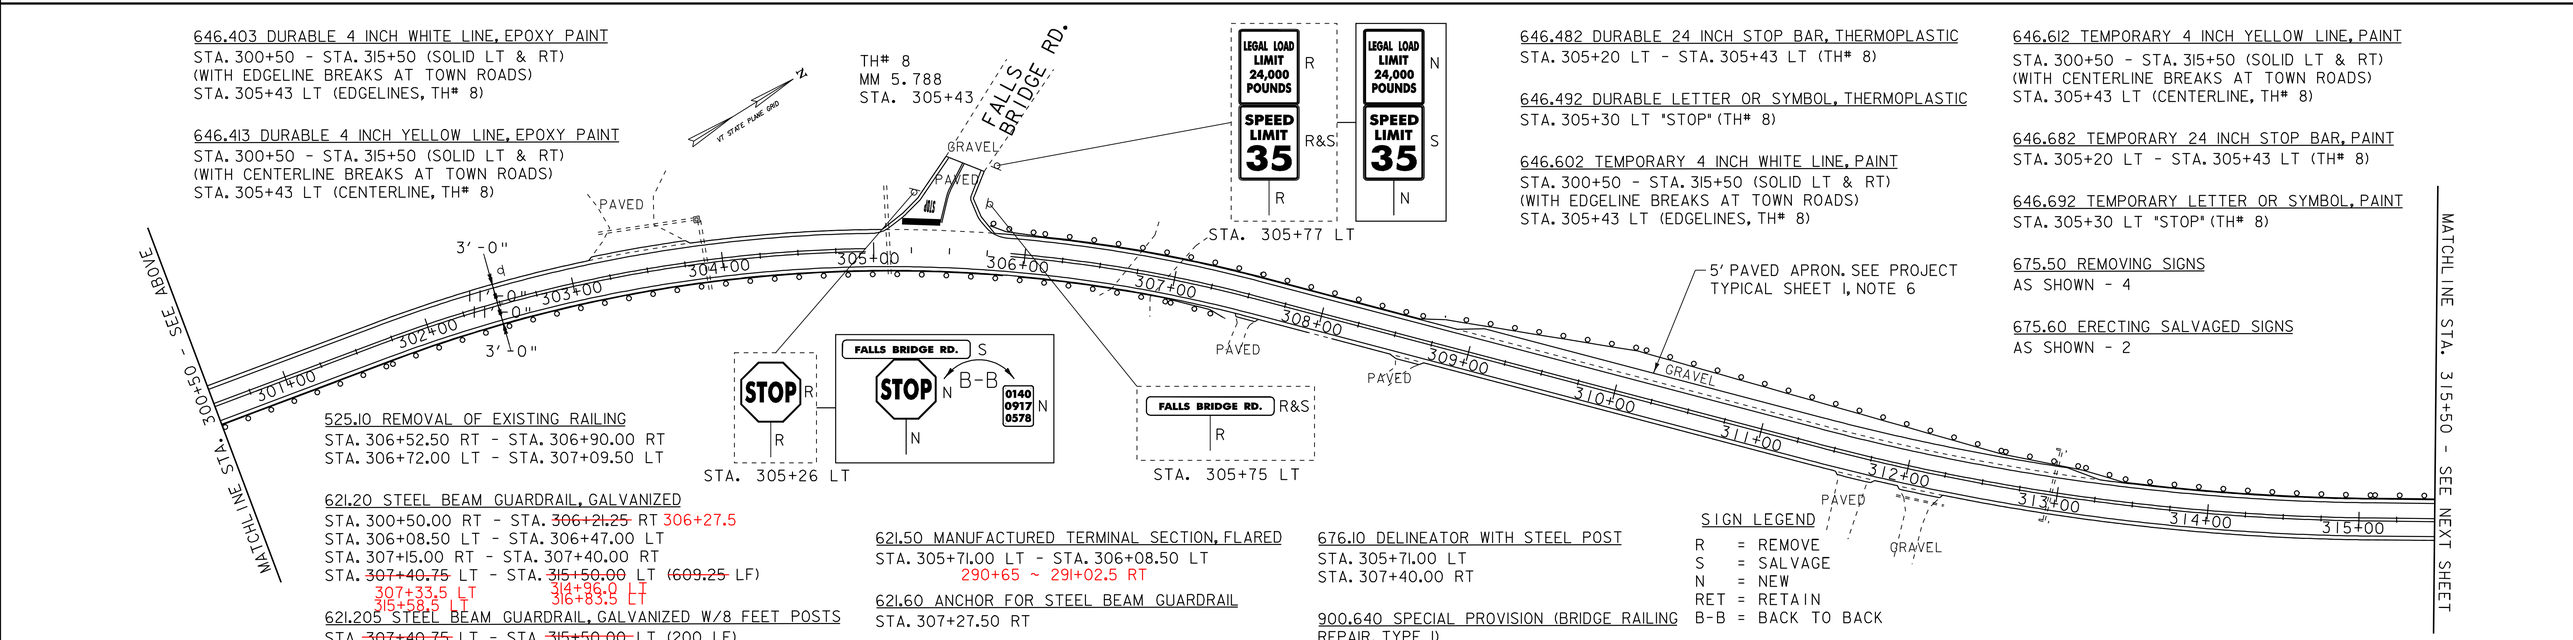

DATUM
VERTICAL N/A
HORIZONTAL N/A

PROJECT LAYOUT SHEET 6

PROJECT NAME: WILLIAMSTOWN-BARRE TOWN
PROJECT NUMBER: STP 2210(1)S

FILE NAME: p99c172.dgn
PROJECT LEADER: EPD
DESIGNED BY: CDL
PLOT FILE: p99c172106.1
PLOT DATE: 29-APR-2009 13:
DRAWN BY: RHB
CHECKED BY: EPD
SHEET 18 OF 32