VT ROUTE 100C
STA 0+00 = MM 0.000
BEGIN PROJECT STP 2215(1)S

TEMPORARY 4in YELLOW LINE (PAINT)
DURABLE 4in YELLOW LINE (THERMOPLASTIC)
0+35 STA ~~0+40~~ TO 11+50 SOLID LT&RT
(WITH CENTERLINE BREAKS FOR TOWN HIGHWAYS)

TEMPORARY 4in WHITE LINE (PAINT)
DURABLE 4in WHITE LINE (THERMOPLASTIC)
0+00 STA 0+~~40~~ TO 11+50 SOLID LT&RT
(WITH EDGELINE BREAKS FOR TOWN HIGHWAYS)

TEMPORARY LETTER OR SYMBOL (PAINT)
DURABLE LETTER OR SYMBOL (THERMOPLASTIC)
STA ~~0+46~~ LT 0+56 "STOP"
STA 6+00 LT "STOP AHEAD"

TEMPORARY 24in STOP BAR (PAINT)
DURABLE 24in STOP BAR (THERMOPLASTIC)
STA 0+40 LT VT ROUTE 100C

CHANGE ELEVATION OF SEWER MANHOLE
STA 10+63 LT DONE BY TOWN OF JOHNSON

BITUMINOUS CONCRETE GUTTER
STA 4+80 TO ~~9+40~~ LT
10+25

REHABILITATION OF D.I.'S, C.B.'S, OR M.H.'S
STA 0+70 RT
STA 4+80 LT
STA 6+66 LT
STA 6+69 RT
STA 0+69 LT

ADJUST ELEVATION OF VALVE BOX
STA 0+65 C.L. DONE BY TOWN OF JOHNSON
~~STA 6+76 RT~~
~~STA 8+17 LT~~

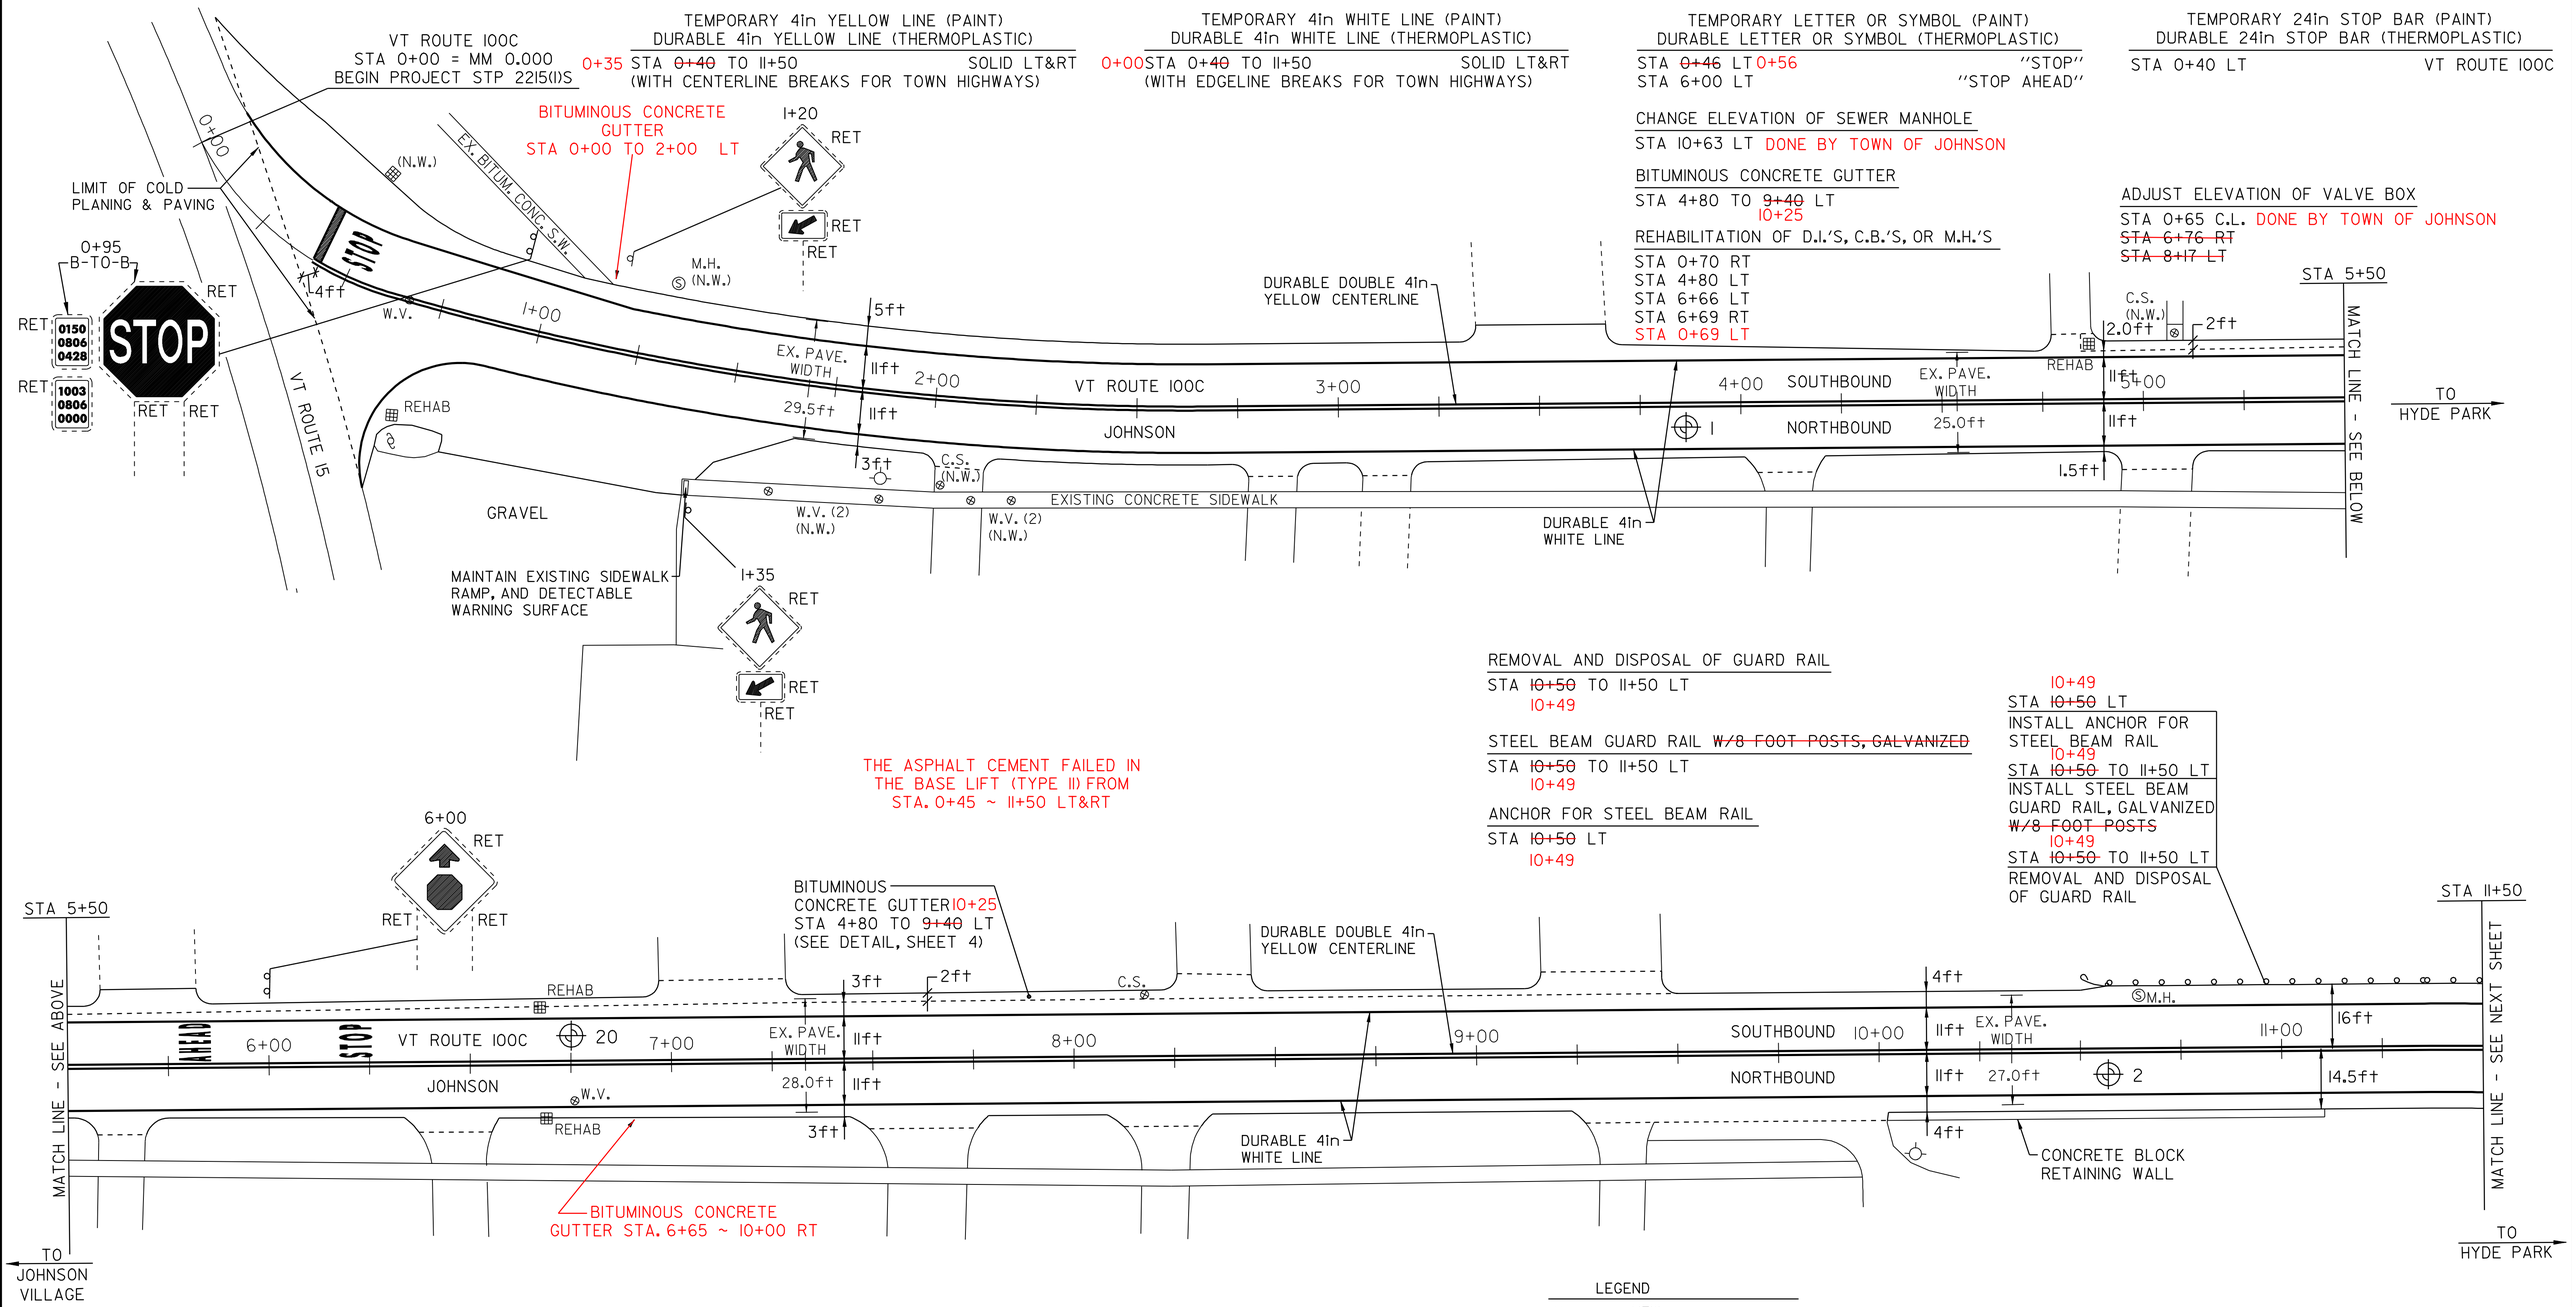

THE ASPHALT CEMENT FAILED IN THE BASE LIFT (TYPE II) FROM STA. 0+45 ~ 11+50 LT&RT

REMOVAL AND DISPOSAL OF GUARD RAIL
STA ~~10+50~~ TO 11+50 LT
10+49

STEEL BEAM GUARD RAIL ~~W/8 FOOT POSTS, GALVANIZED~~
STA ~~10+50~~ TO 11+50 LT
10+49

ANCHOR FOR STEEL BEAM RAIL
STA ~~10+50~~ LT
10+49

10+49
STA ~~10+50~~ LT
INSTALL ANCHOR FOR STEEL BEAM RAIL
10+49
STA ~~10+50~~ TO 11+50 LT
INSTALL STEEL BEAM GUARD RAIL, GALVANIZED ~~W/8 FOOT POSTS~~
10+49
STA ~~10+50~~ TO 11+50 LT
REMOVAL AND DISPOSAL OF GUARD RAIL

PAVEMENT CORES - ⊕

#	TOTAL DEPTH (in)	DRAINABLE BASE	SOLID CORE	COMMENTS
1	8.0	NO	NO	APPEARS TO BE TREATED GRAVEL
20	13.0	NO	YES	--
2	11.0	NO	YES	CONCRETE RETAINING WALL

NOTE:
- NO PCC UNDER ANY CORES
- NO CORES OVER ASPHALTED
- NO SHOULDER CORES
- NO STRIPPED CORES

LEGEND

N	= NEW
R	= REMOVE
R&S	= REMOVE & SALVAGE
S	= SALVAGE
RET	= RETAIN
B-TO-B	= BACK TO BACK
⊕ ⊞ □	CATCH BASIN/DI
Ⓢ M.H.	SEWER MANHOLE
⊗ W.V.	WATER VALVE
⊗ C.S.	CURB STOP
(N.W.)	NO WORK REQUIRED (TYP. FOR W.V.'S, C.S.'S, D.I.'S, C.B.'S WHERE NOTED)
I	YIELDING MARKER POST
	UTILITY POLE
	DRIVE

PAVING PROJECT LAYOUT SHEET #1

DESIGNED BY BCE/PJM DATE 7-07
DRAWN BY C.E.A., INC. DATE 7-07
DESIGN FILE NO. p99c182.dgn
PRF FILE p99c182p101.i DATE PLOTTED 08-JAN-2009
PROJ. NAME **JOHNSON–HYDE PARK**
PROJ. NO. **STP 2215(1)S**
SHEET **10** OF **33** SHEETS