


25 N

20 W
(19.5)

20 S
(19.5)

25 S

SCALE: 1"=20'

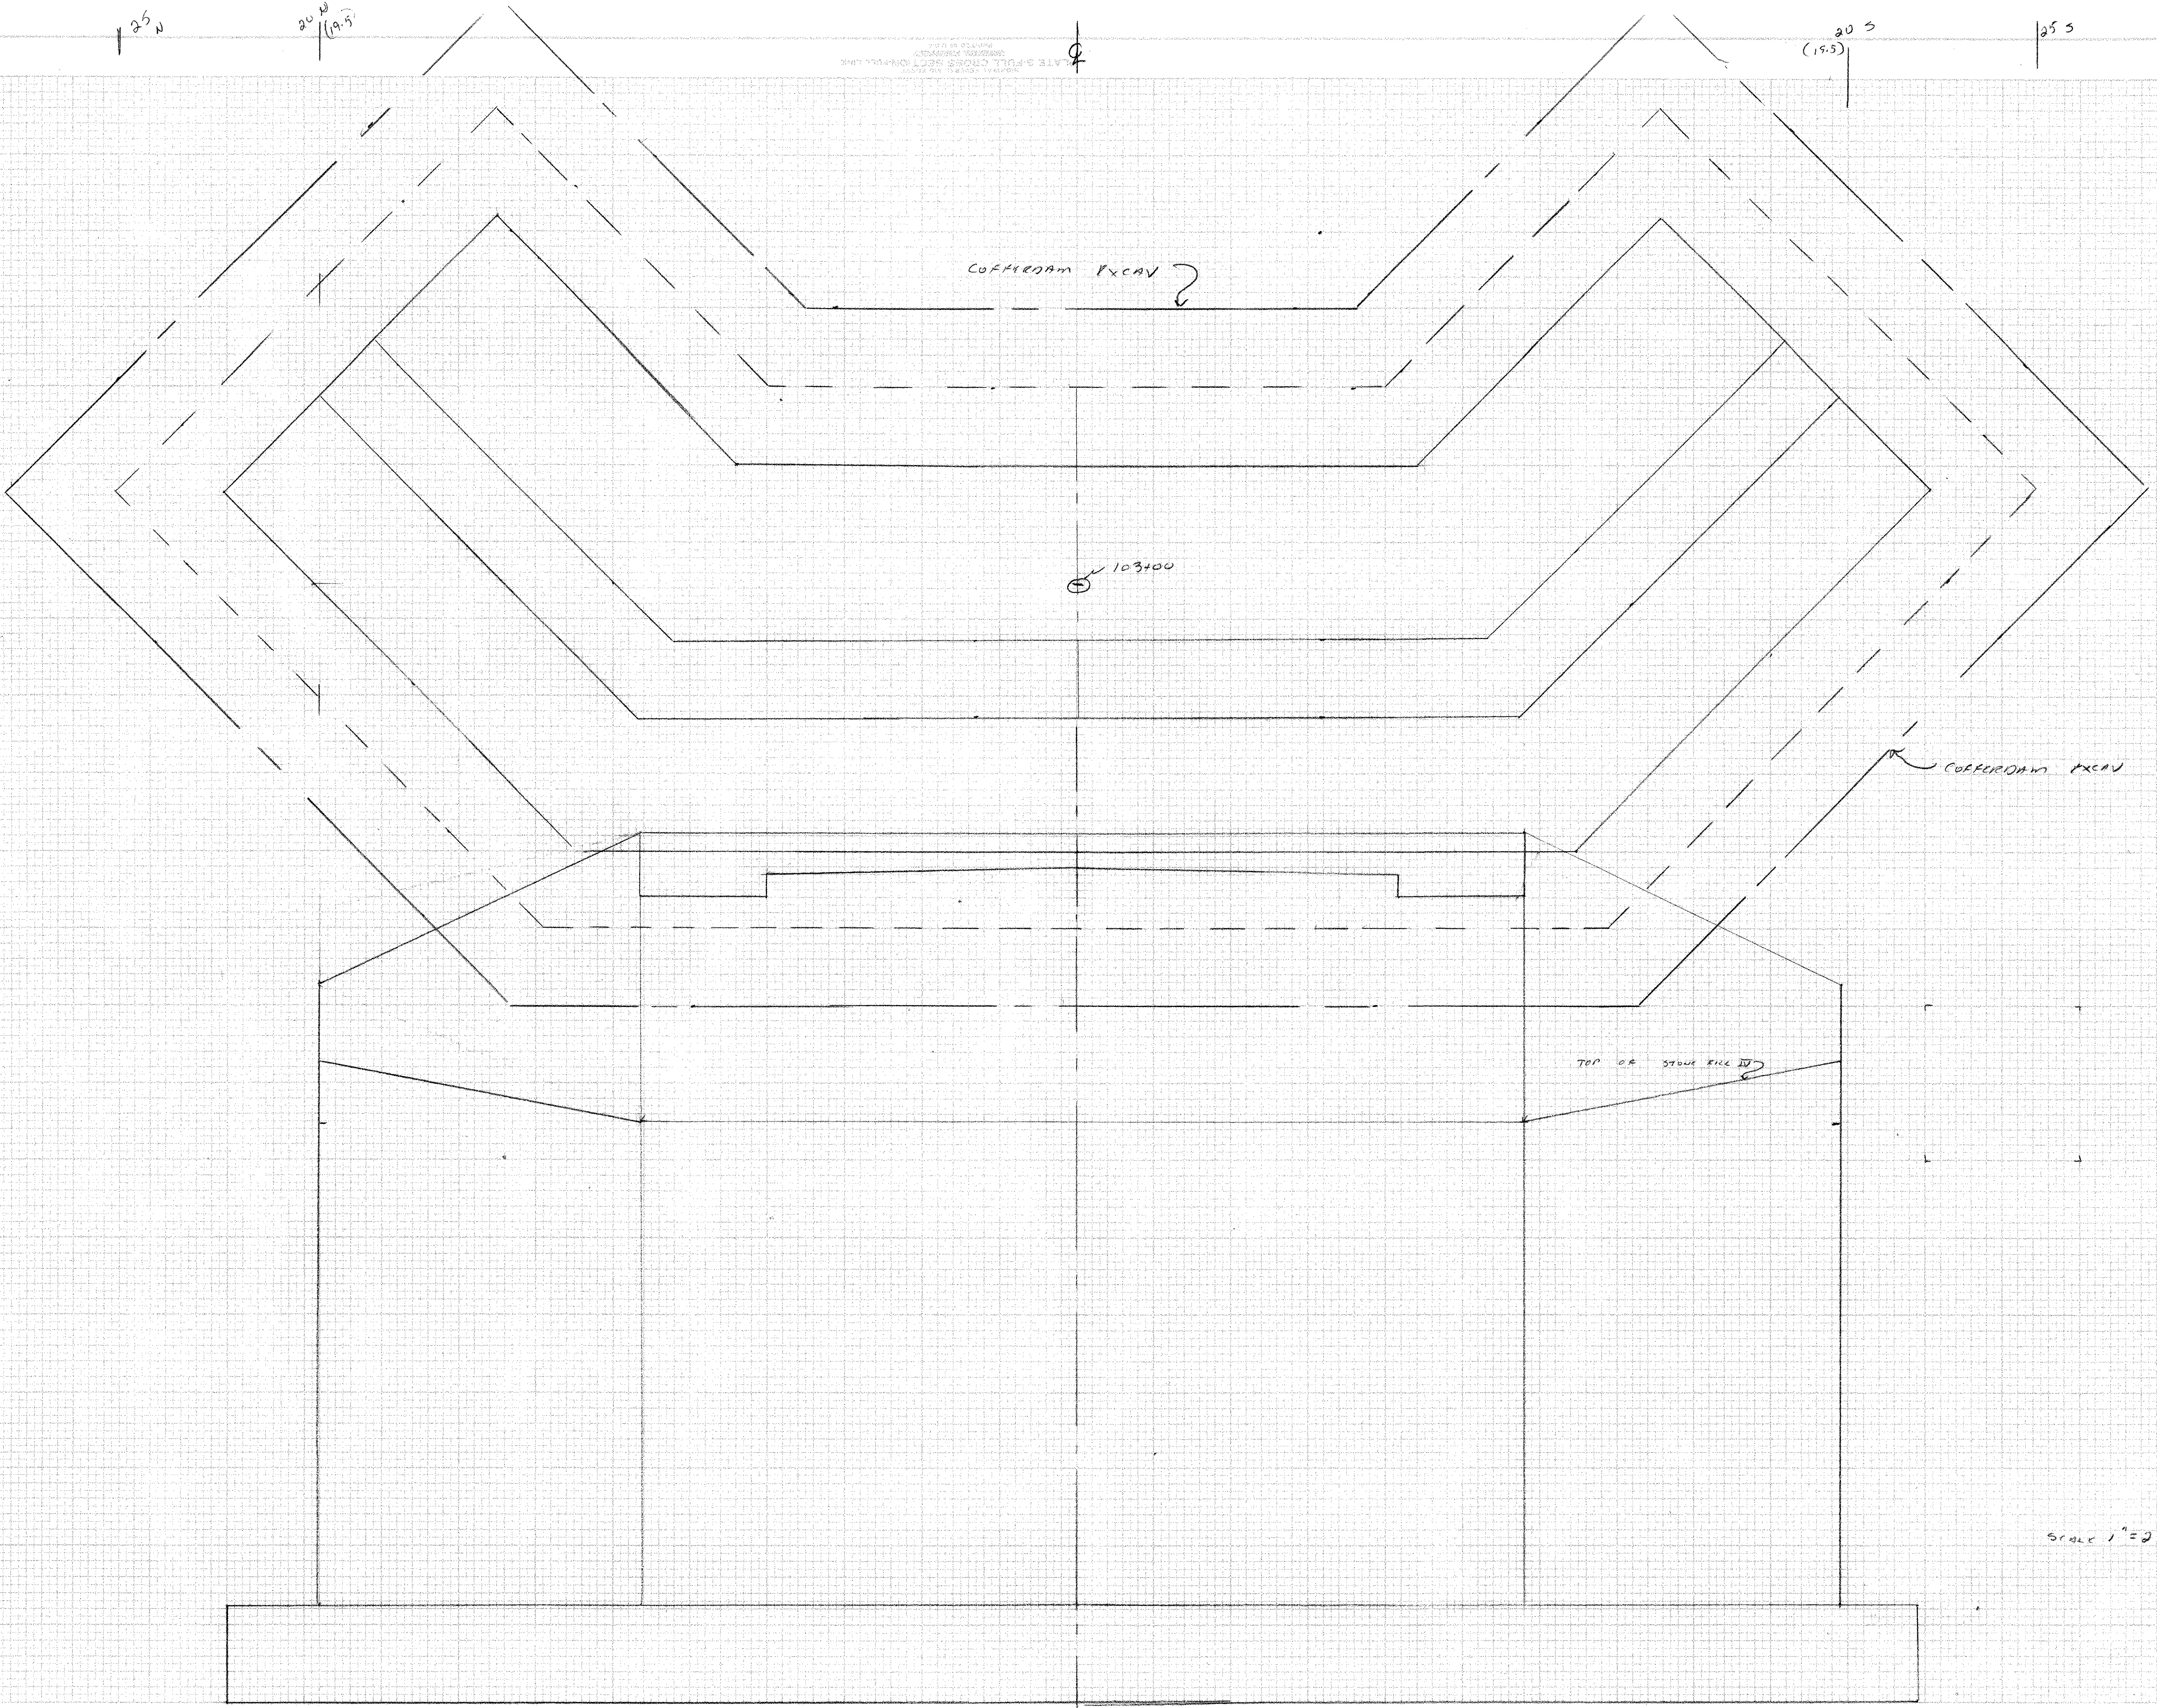



Scale 1"=20'