| ABM INFO | | SHOP BILL | | | | | | | JOB NO. 214 | DRG. NO. M1 |
|---|---|---|---|---|---|---|---|---|---|---|
| PAGE | LINE | NO. | DESCRIPTION | FT | IN | ASSEM. MARK | SHIPPING MARK | REMARKS | | WEIGHT |
| | | 1 | PIERNOSING | 25 | 0 | | PN1 | | | |
| | | 3 | PL 3/4 X 16 | 8 | 4 | SHOP | | BEND | | |
| | | 28 | 3/4" ANC STUDS | | 7 | SHOP | | | | |
| | | SUB TO ITEM 501.34 | | | | | | | | |

APPROVED
KCE 12/30/03 JM

RECEIVED
OK'D BY_____ OK'D BY_____
DEC 1 1 2003
RESUBMIT_____ APPROVED_____
BY _____ DATE 1/6/04

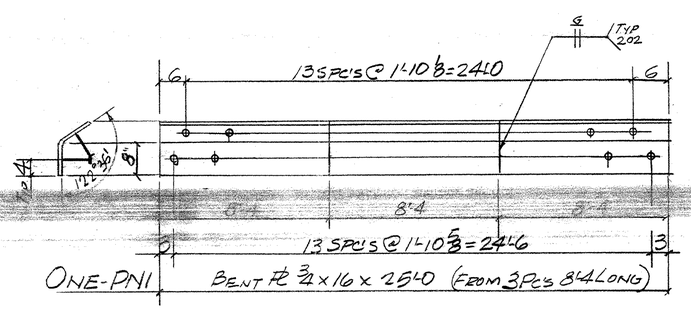


| REV. | REMARKS | DATE | DWN | CHK | APP | Q.A. | NO. | DIA. | LGT | TYPE | WASHER |
|---|---|---|---|---|---|---|---|---|---|---|---|
| | OUT FOR APPROVAL | 12-4-03 | | | | | | | | | |
| | OUT FOR APPROVAL | | | | | | | | | | |
| | ISSUED TO SHOP | | | | | | | | | | |
| | FIELD & OFFICE | | | | | | | | | | |

PROJECT NO. BHO-1447(24) STATE BRIDGE NO. 1

MATERIAL AASHTO M270 GR. 50 ELECTRODES: PER PROC HOLES: — SHOP BOLTS: —

SURFACE PREP. & PAINT:

GALVANIZED AFTER FAB. (ASTM-A123)

DESCRIPTION: PIER NOSING

JOB: BRIDGE IMPROVEMENTS
MAIDSTONE, VT.
STRATFORD, N.H.

| | DRAWN BY | DATE |
|---|---|---|
| | JPF | 12-03 |
| | CHKD BY | |
| | E.J | |
| | APPROV BY | |
| | | |
| | Q.A. | |

CUSTOMER: WINTERSET INC.

RECEIVED DEC 2 9 2003 LICHTENSTEIN


**CASCO BAY STEEL STRUCTURES, INC.**
75 SPRING HILL ROAD SACO, MAINE 04072
PHONE (207) 282-7360 FAX. (207) 282-1179


| JOB NO. | DRG. NO. |
|---|---|
| 214 | M1 |
| | REV. △ |

071 SHOP