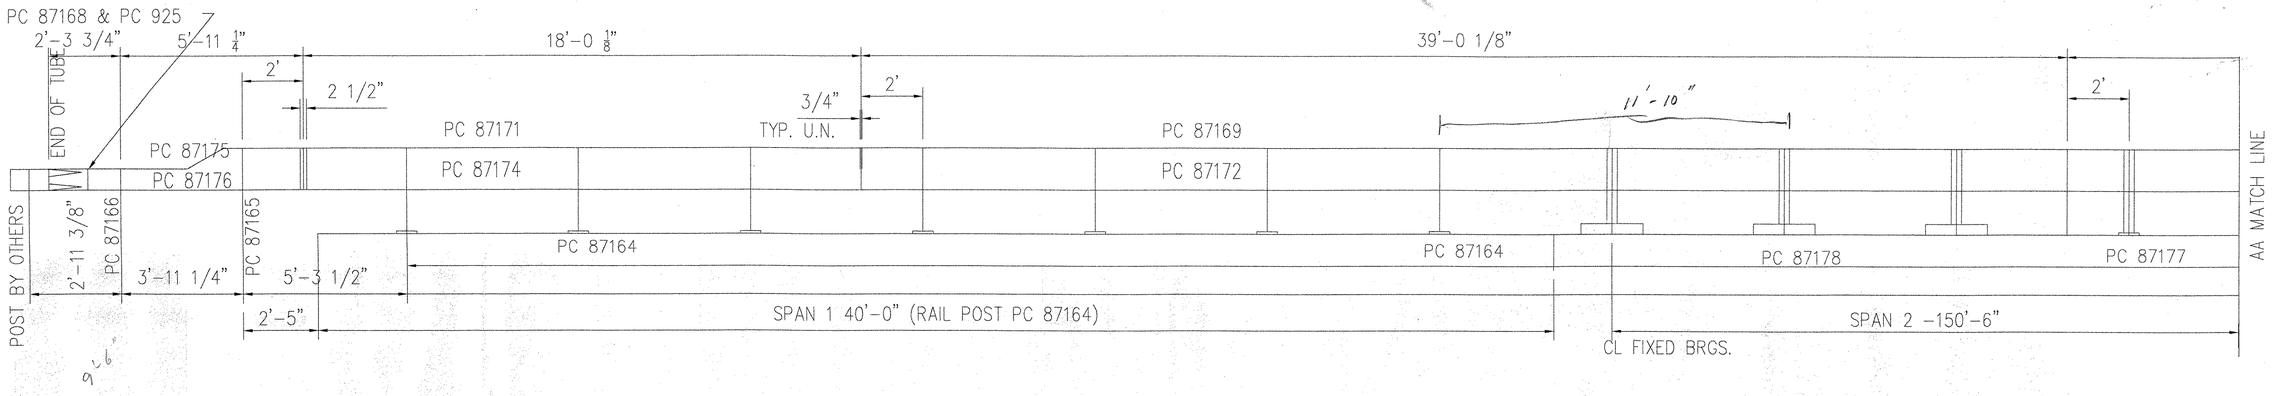

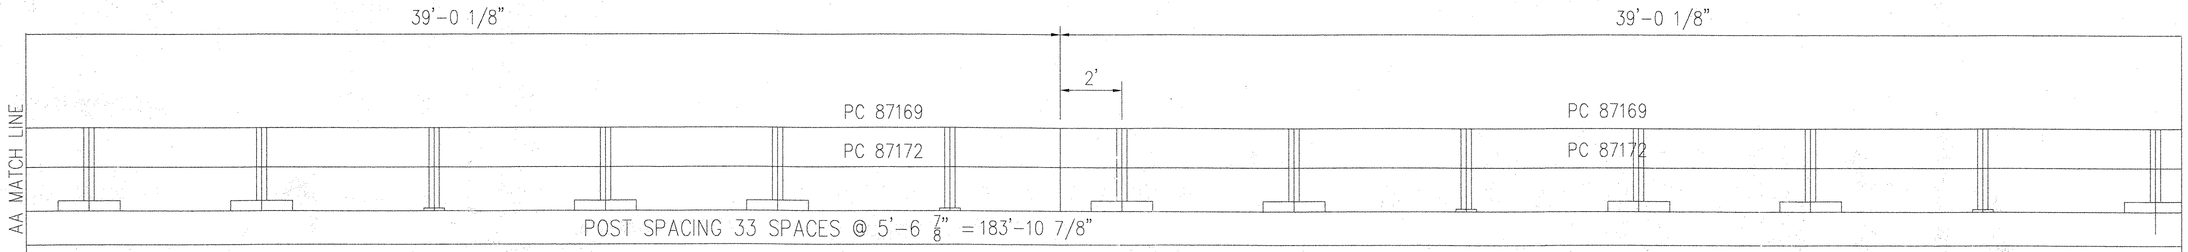

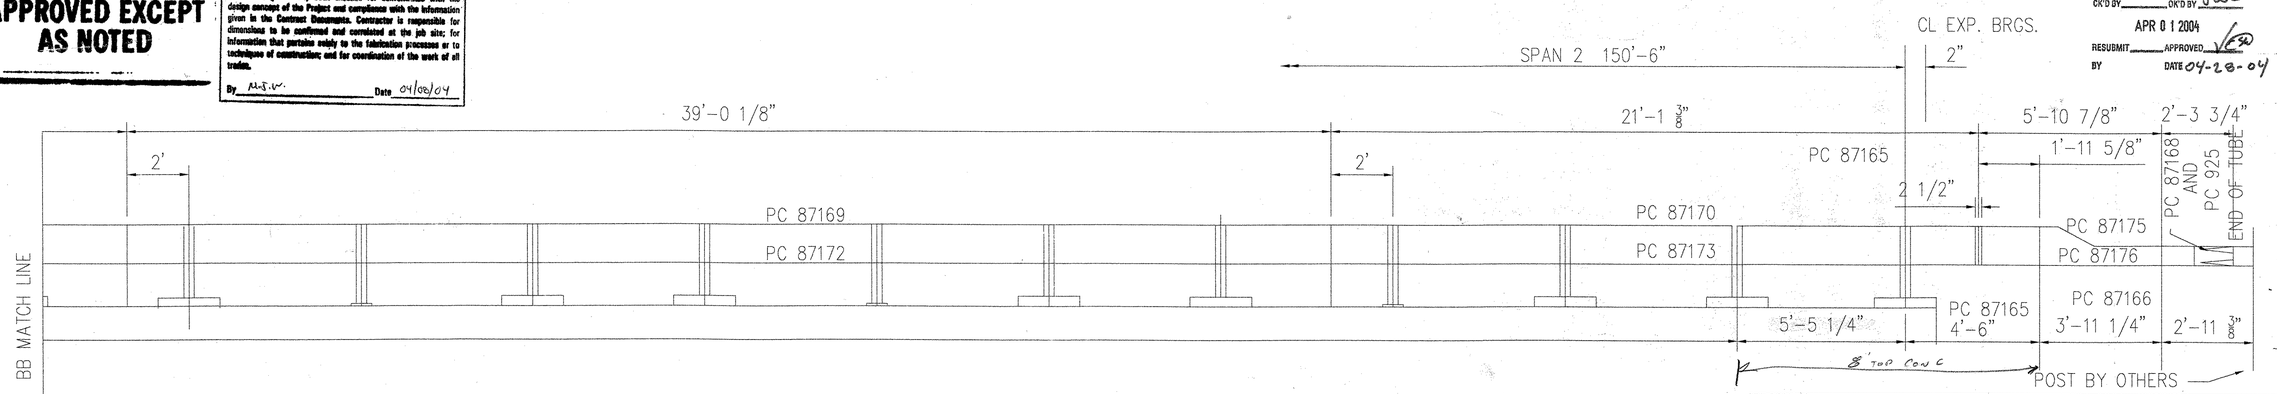

APPROVED EXCEPT AS NOTED

LICHTENSTEIN CONSULTING ENGINEERS, INC.
This drawing has only been checked for conformance with the design concept of the Project and compliance with the information given in the Contract Documents. Contractor is responsible for dimensions to be confirmed and correlated at the job site; for information that pertains solely to the fabrication processes or to techniques of construction; and for coordination of the work of all trades.
By M.S.W. Date 04/08/04

V.A.O.T. RECEIVED
CK'D BY _____ OK'D BY JWC
APR 0 1 2004
RESUBMIT _____ APPROVED VSD
BY _____ DATE 04-28-04

NORTH RAILING ~VIEWING TRAFFIC FACE
SOUTH RAILING ~VIEWING NON TRAFFIC FACE

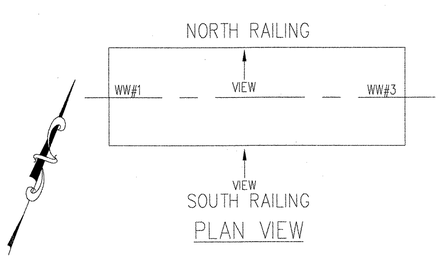

PLAN VIEW

NOTES:
1.) ALL T.S. 8 x 4 RAIL SPLICES ARE P.C. 35107.
2.) ALL T.S. 4 x 4 RAIL SPLICES ARE P.C. 35103.
3.) TOTAL PAY LENGTH: 414'-0 1/4"
4.) FIELD DRILL 7/8" DIA. HOLES IN TUBES FOR THE POST CONNECTION.
5.) FINISH GALV. ASTM A-123, HARDWARE ASTM A-153

RECEIVED APR 7 LICHTENSTEIN

SHOP DETAILS ARE ON D1,D2 AND D3 OF 3

APPROVAL DRAWING

GIRARD ENGINEERING DEPT. ISSUED
Wednesday, March 24, 2004
TRINITY INDUSTRIES, INC.
1170 N. STATE STREET
GIRARD, OHIO 44420

This drawing and the information shown thereon is the sole property of TRINITY INDUSTRIES, INC. Neither the drawing nor such information is to be used for any purpose other than that for which it was specifically furnished by TRINITY INDUSTRIES, INC., nor is any reproduction authorized without written permission.

REV.	CHK'D	BY	DATE	REMARKS

PAY ITEM 525-33 NETC 2-RAIL

STATE OF VERMONT AGENCY OF TRANSPORTATION
TOWN OF MADISON,VT STRATFORD, NH
PROJECT NO.NH BHO-1447-(24)

DRAWN	MARLEY
CHECKED	SAR
APPROVED	
DATE	3/4/04
ENG. FILE #	22-1032196
SHT.No.	E2 OF 3
TRINITY SALES ORDER NO.	(22)1032196
REV.	0

CUSTOMER WINTERSET INC P.O. No. C-1308

TRINITY INDUSTRIES, INC.
HIGHWAY SAFETY PRODUCTS
2525 STEMMONS FREEWAY, DALLAS, TX 75207

076

F:\Rf\Share\Engineering\STATE\VT\VT1032196\22-1032196-E002.dwg 11:44:30 3/24/04